


Guards to Centre of Sec 16
T24 N R22 West of 4th principle
Meridian

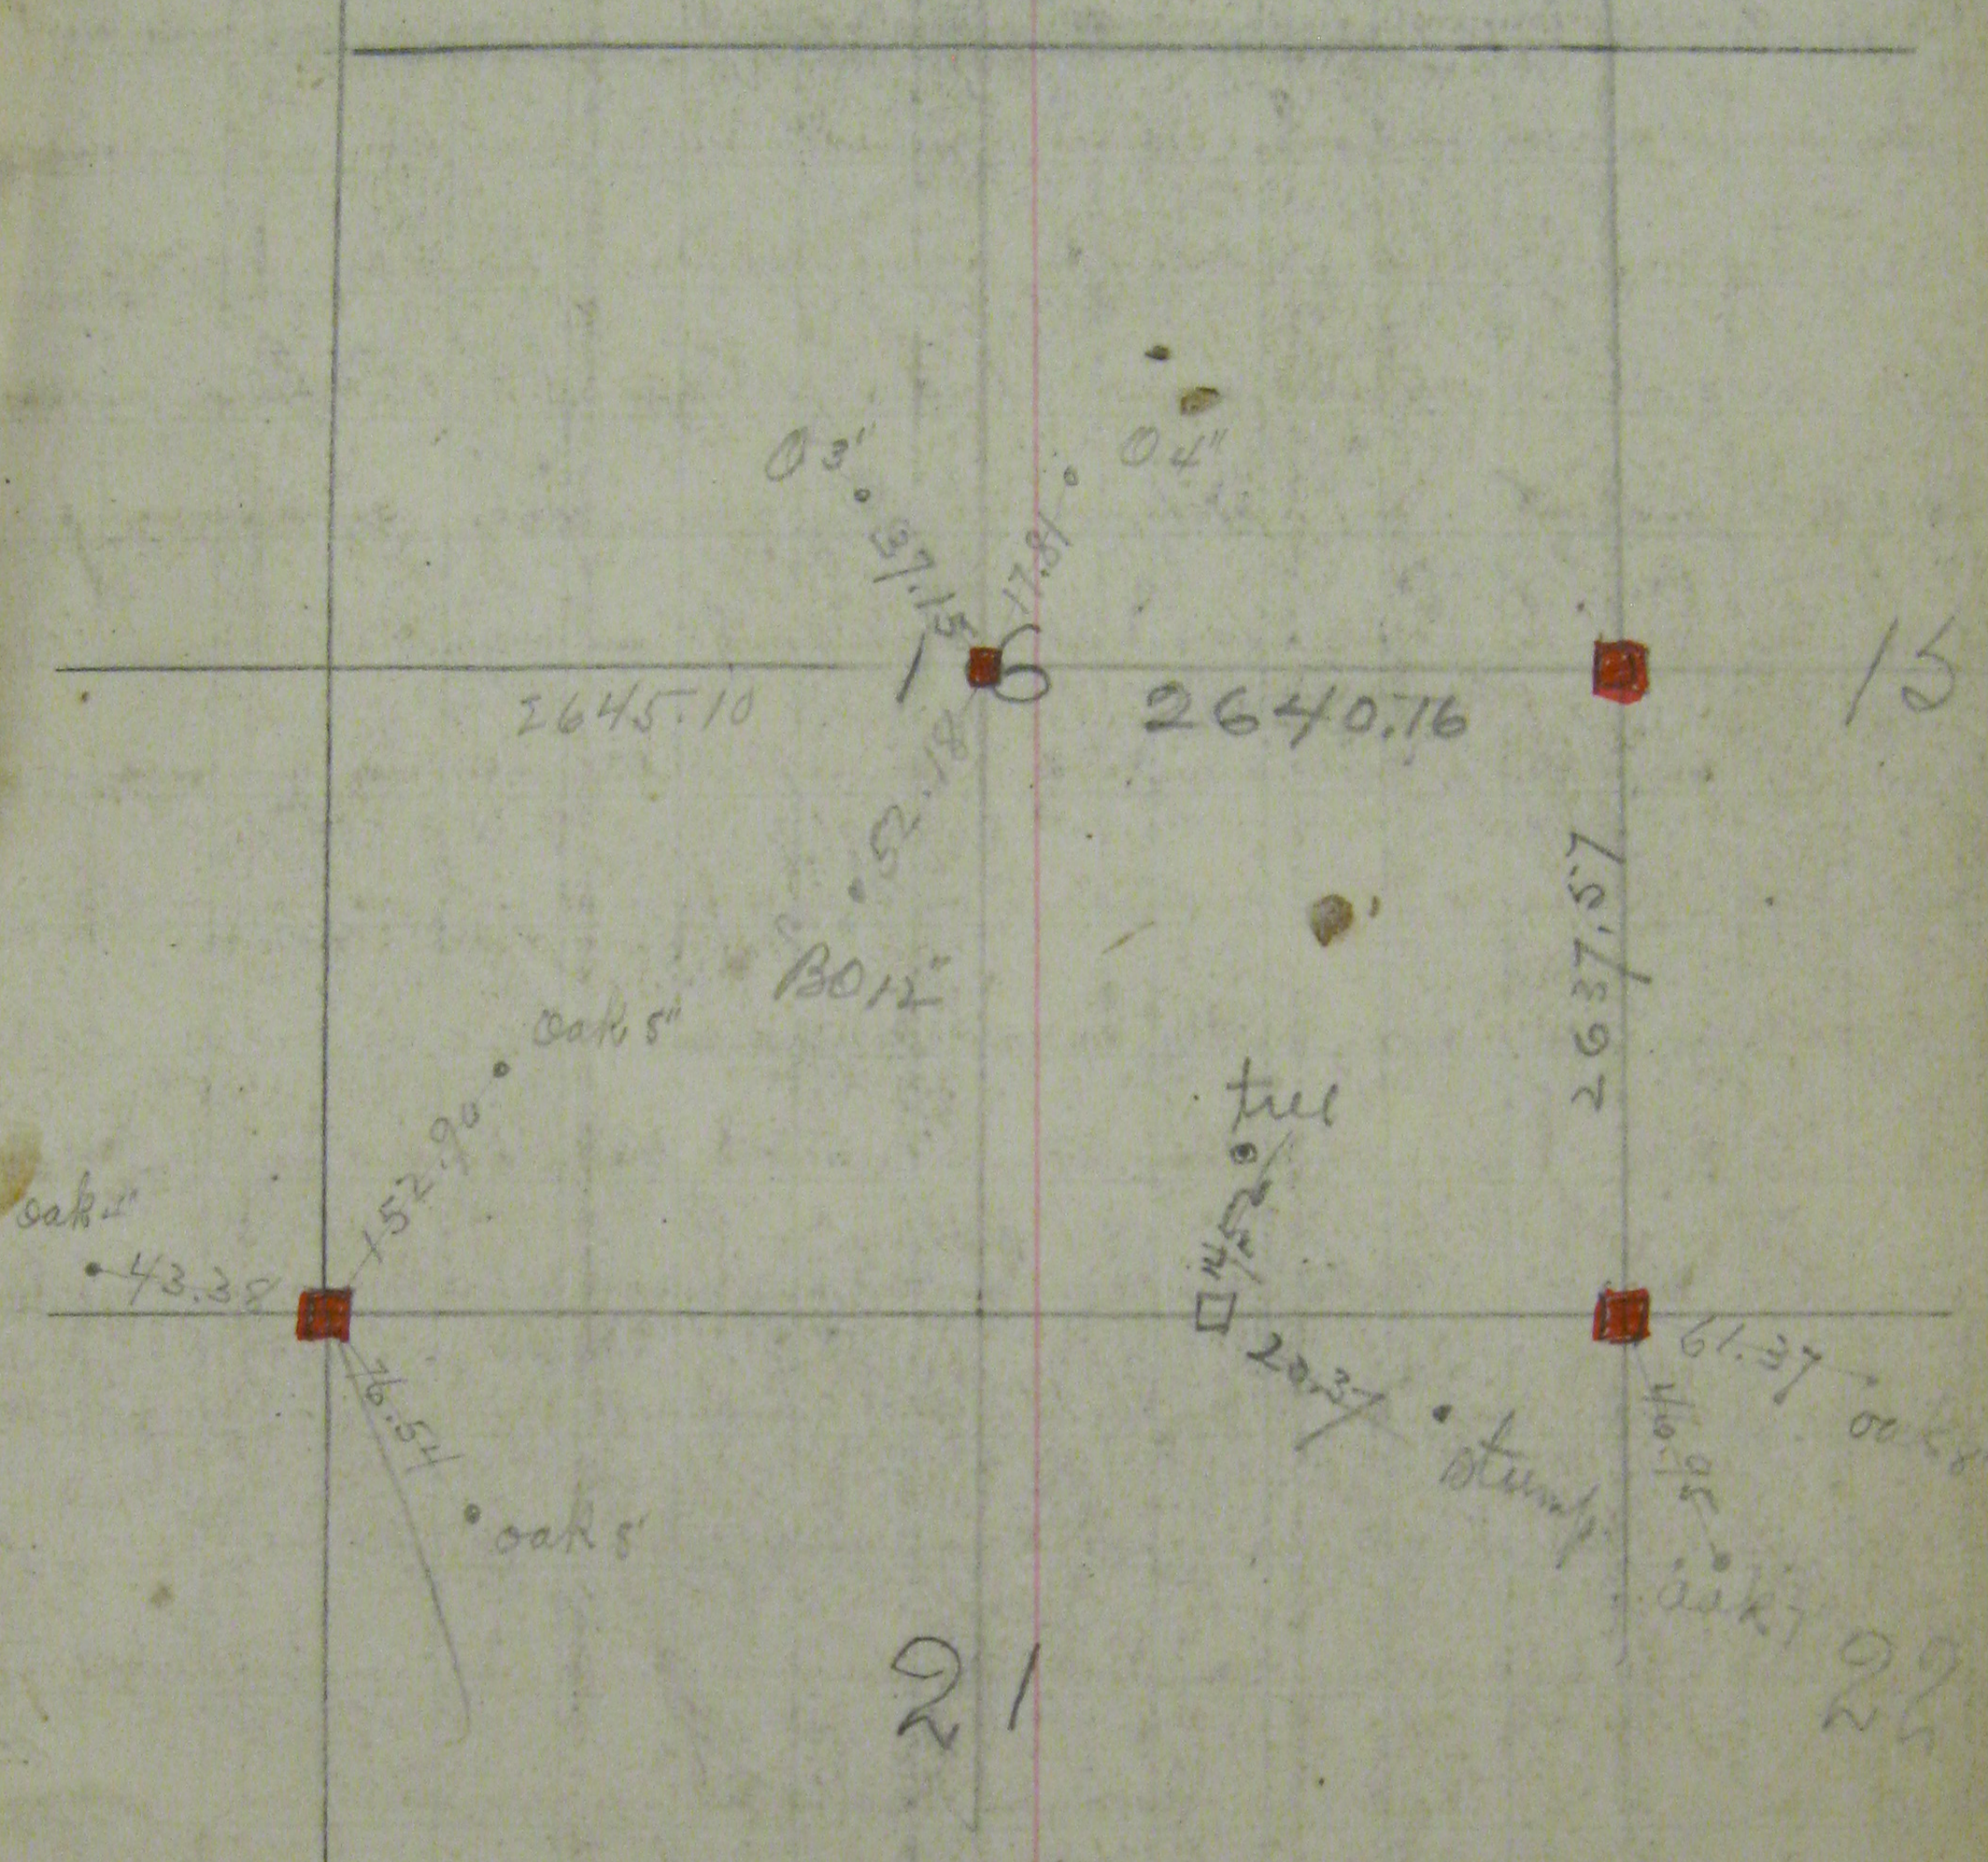

21

15

22
26

A = 3 Nails in Base of Blk O (5') 5523
 B = 3 " " " two feet from ^{ground} White O (4") 42.00

Taken Oct-13th 1886 Corrected May 28th 1888