


17

Cor Between Sec 20 + 21 T29

this point is Centre of Corns and phalan  
and Areadl

SEPT 23

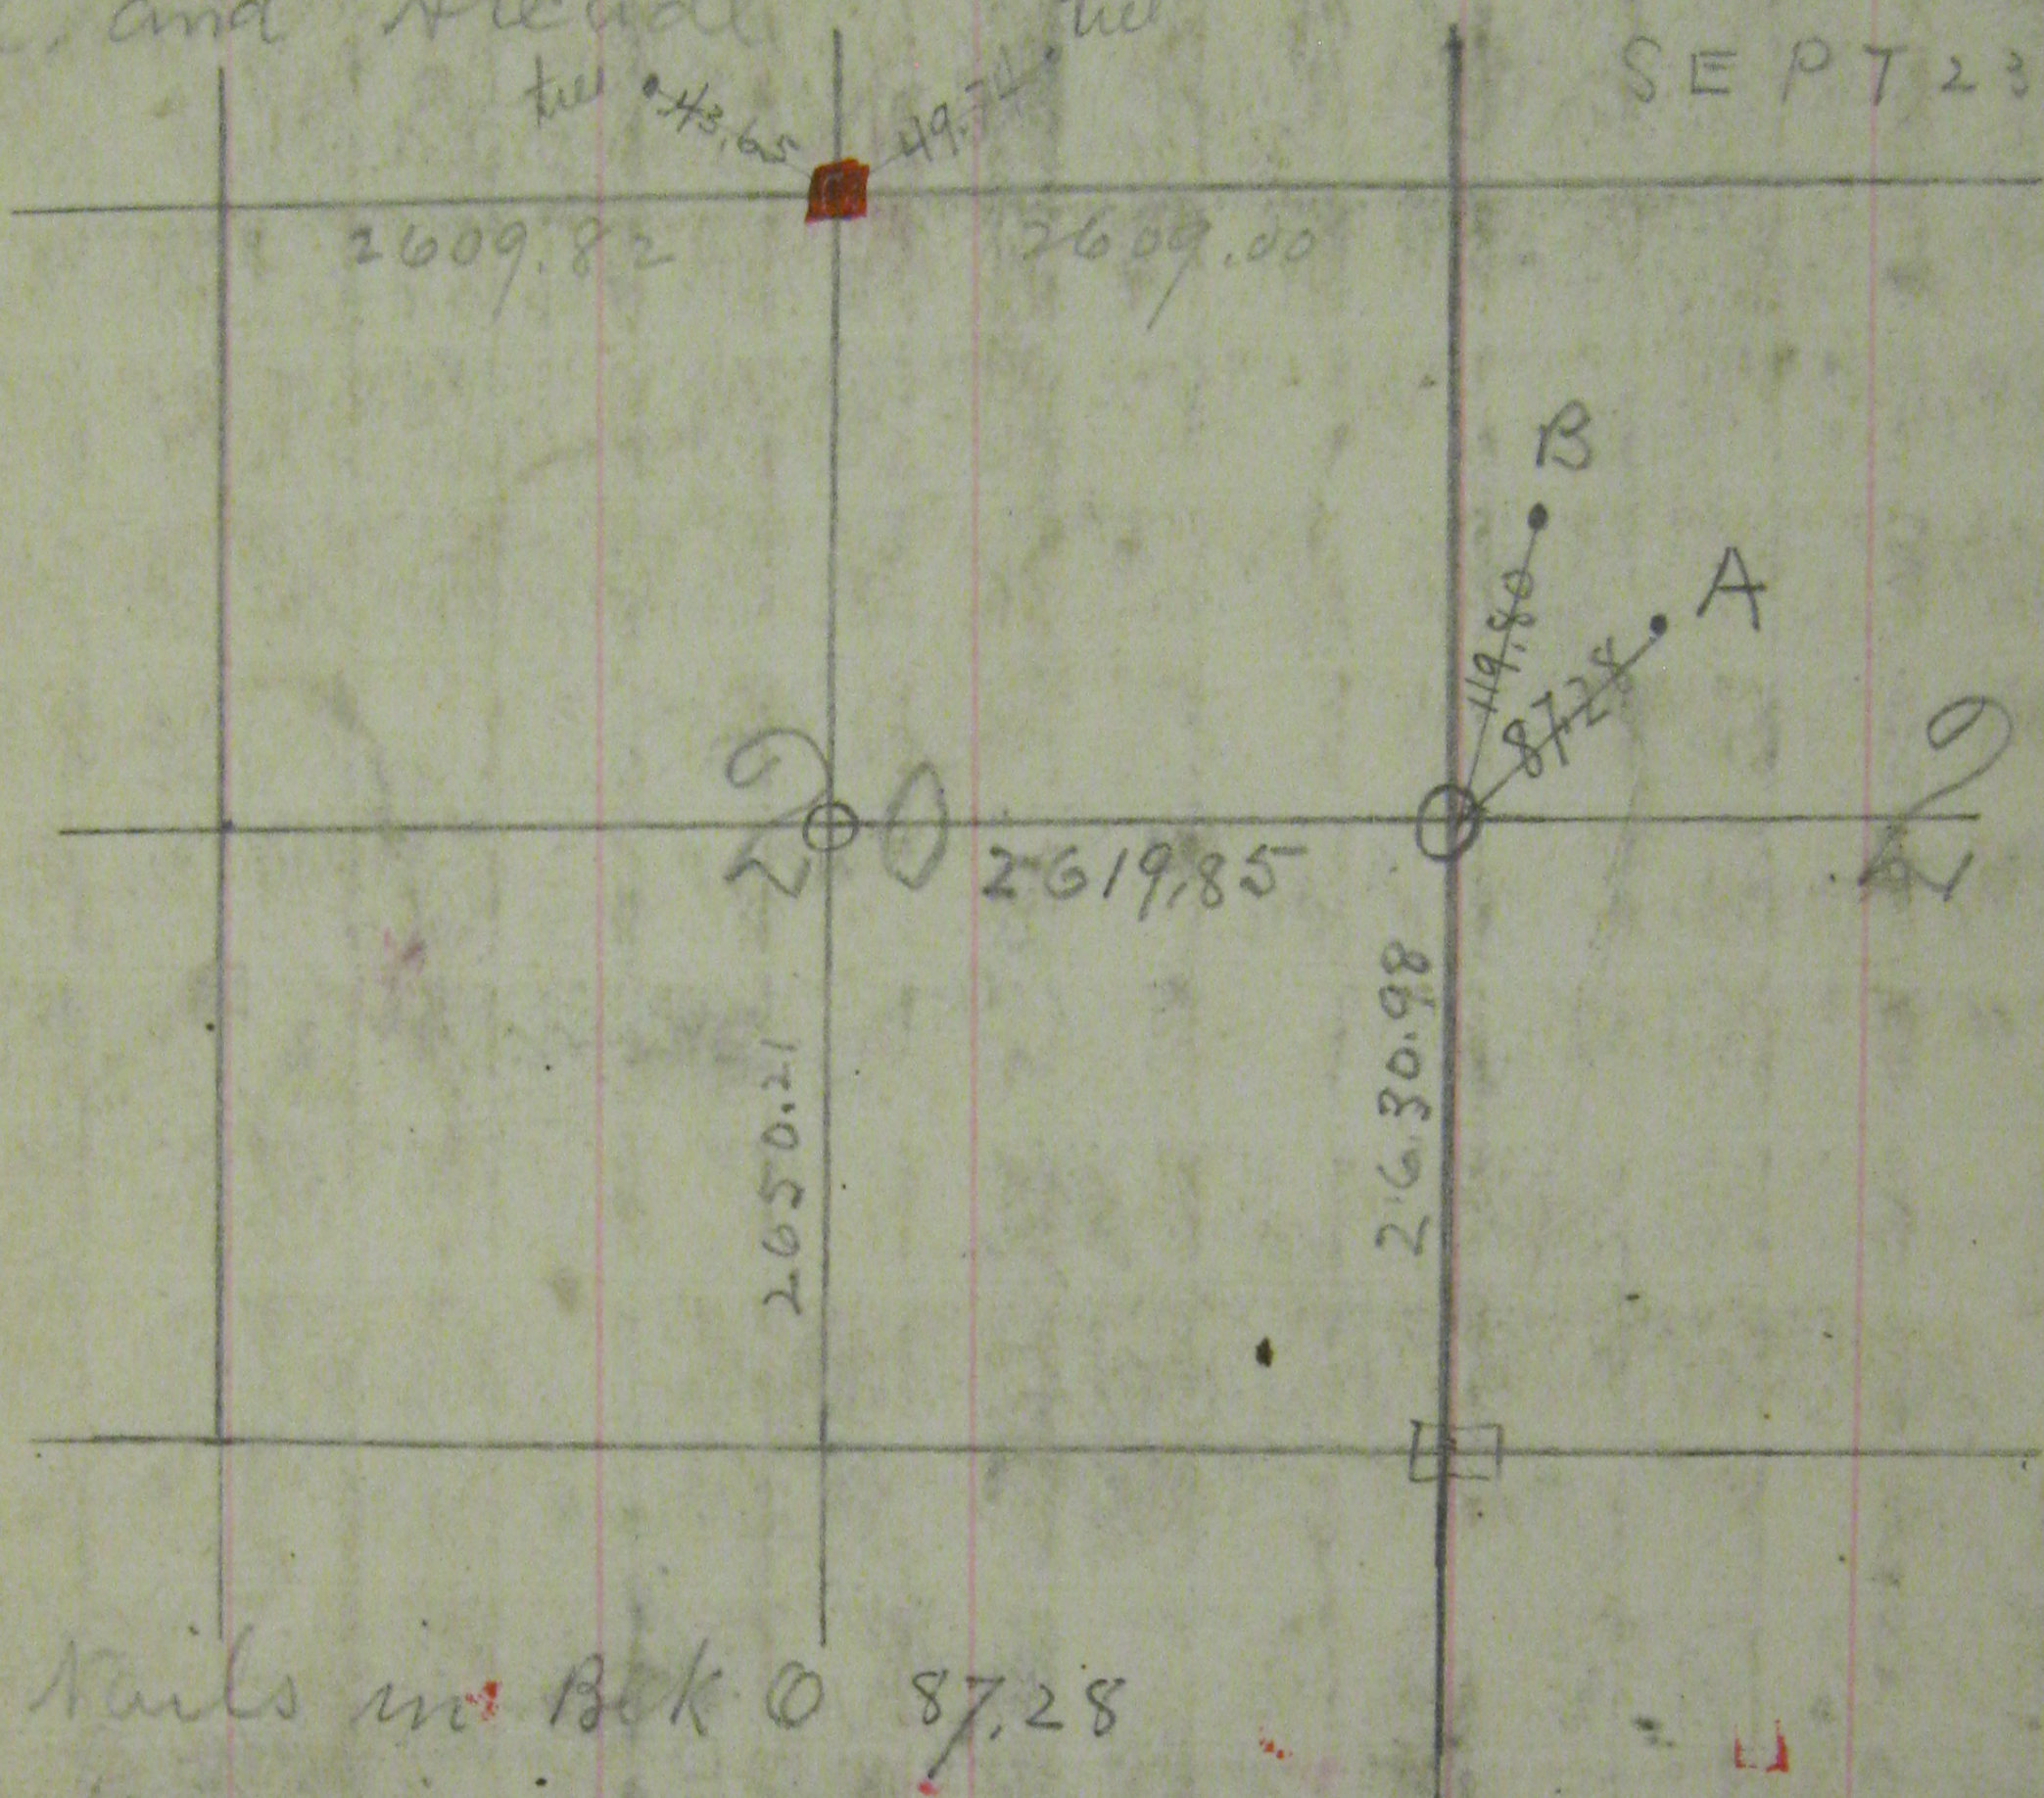

A = 3 rails in Bek 0 87.28  
 B = 3 rails in Bek 0 119.80