


9 R22
5th fence
10th

Guards to Centre of Sec 22 T29 R22

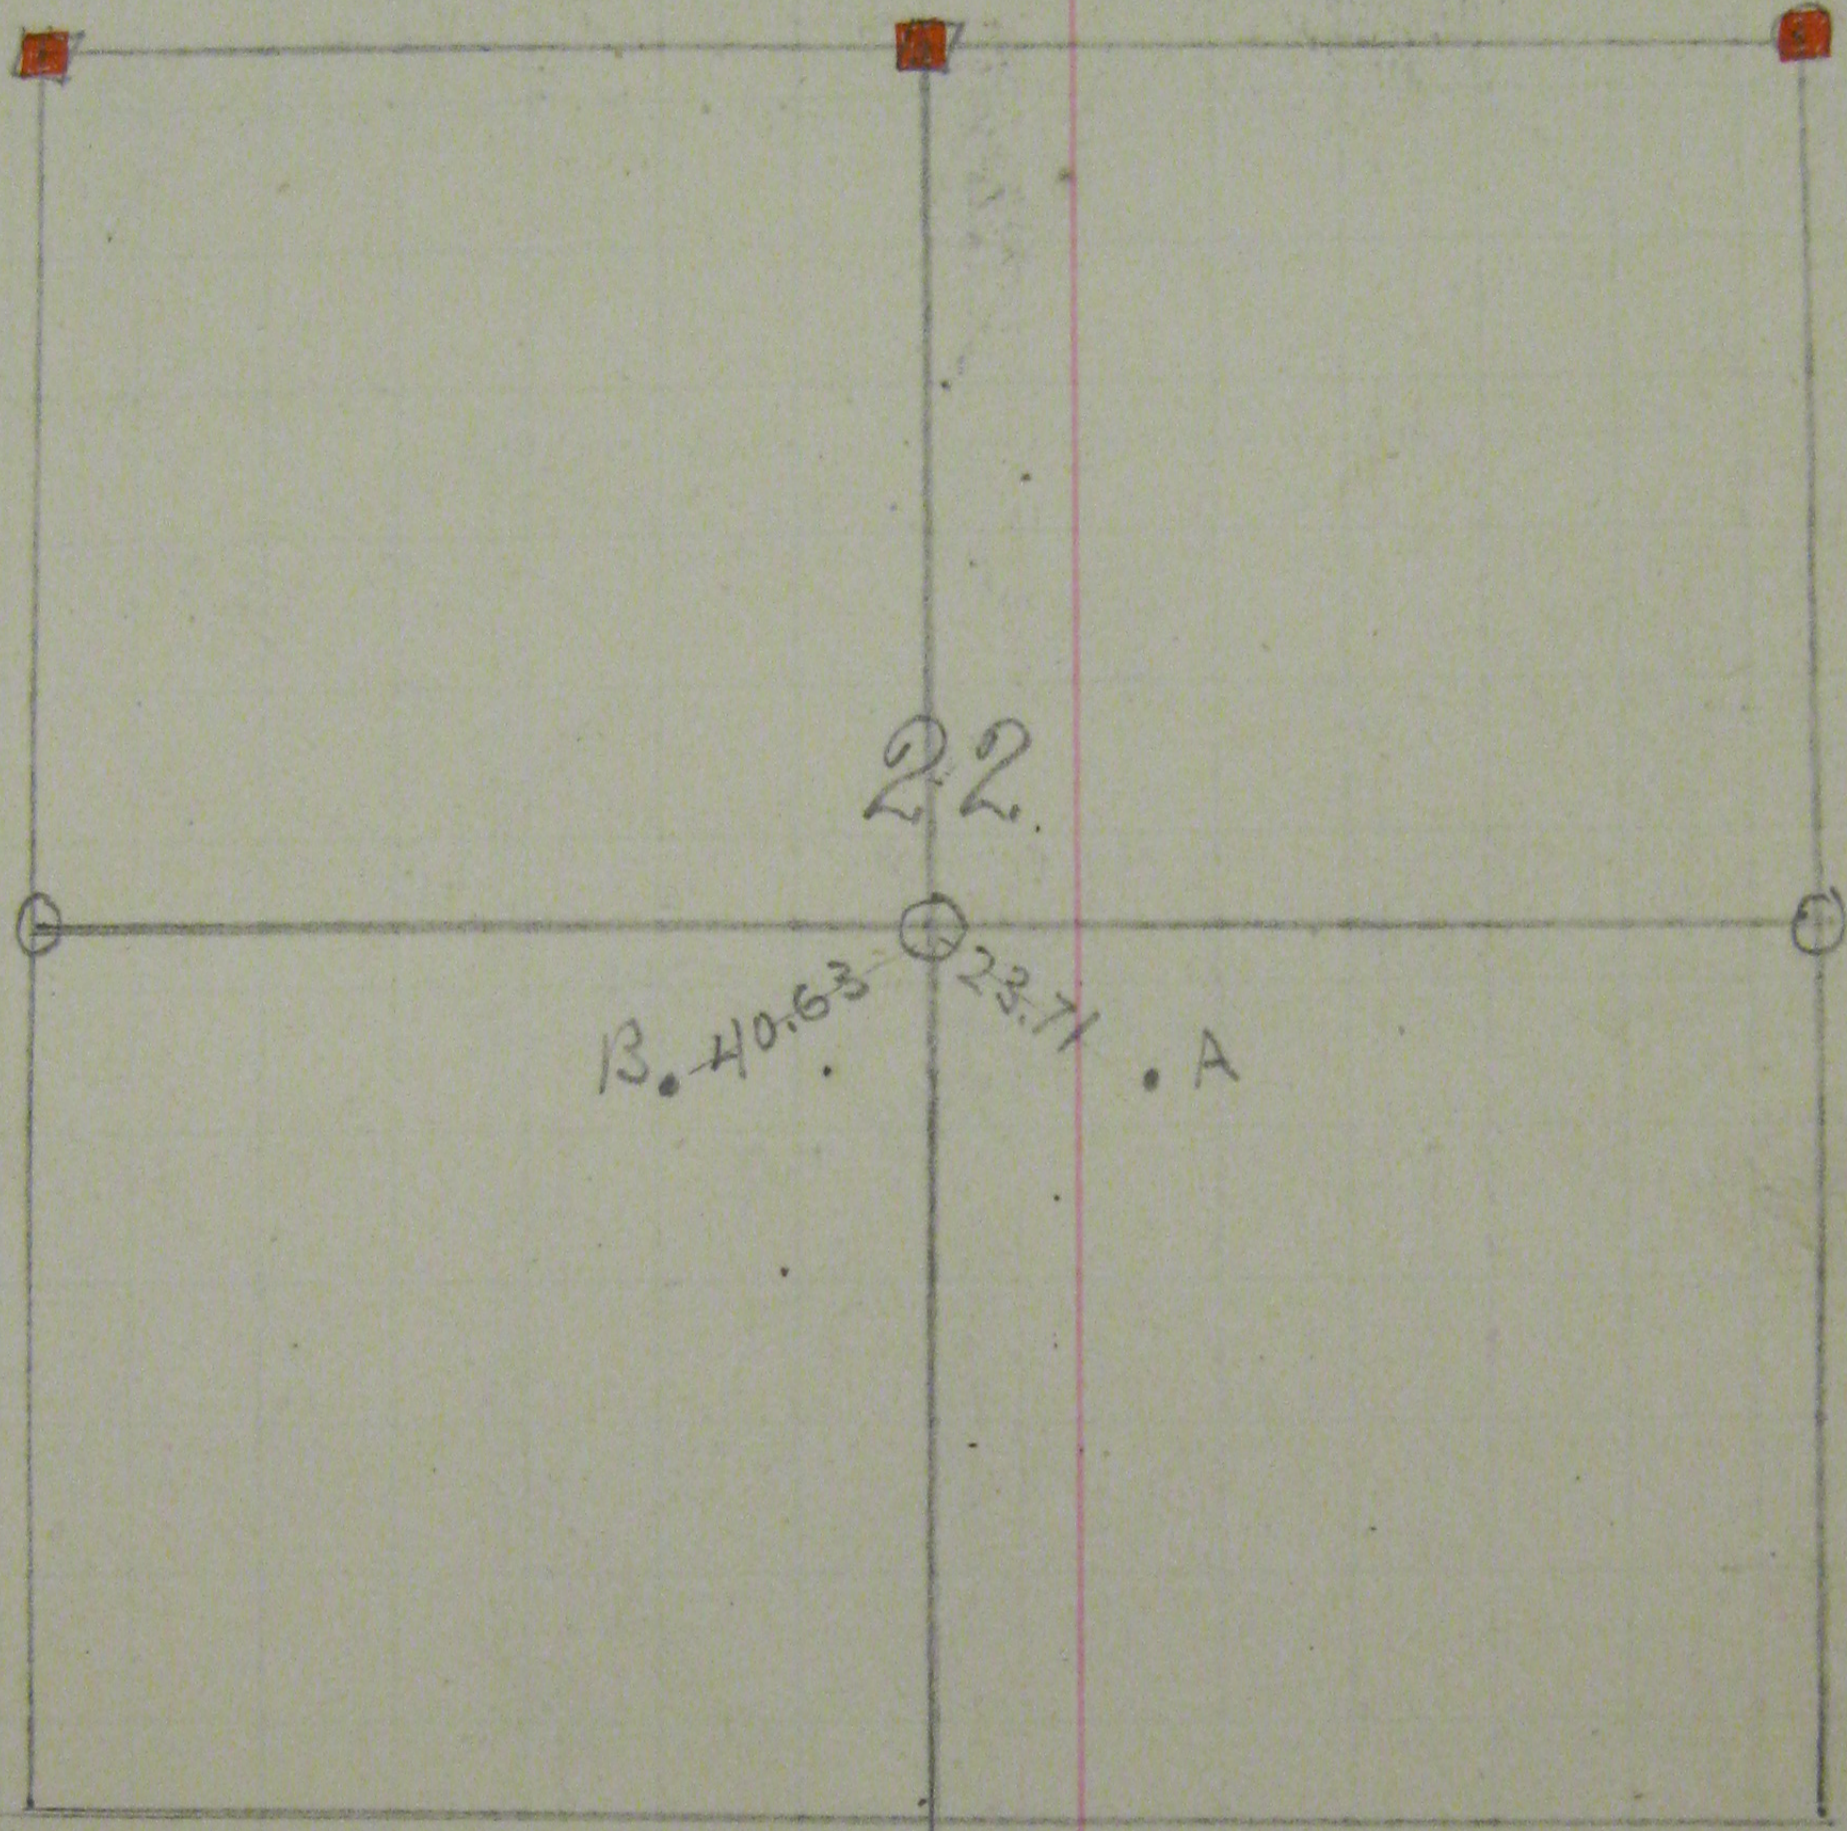

A = 3 Nails in base of BLK (16") 23.71

B = 3 " " " " " (8") 40.63