


guards to a point - 662.68 feet 20
 East of Section Corner Between
 Sections 15, 16, 21 + 22 @ S 29 R 22

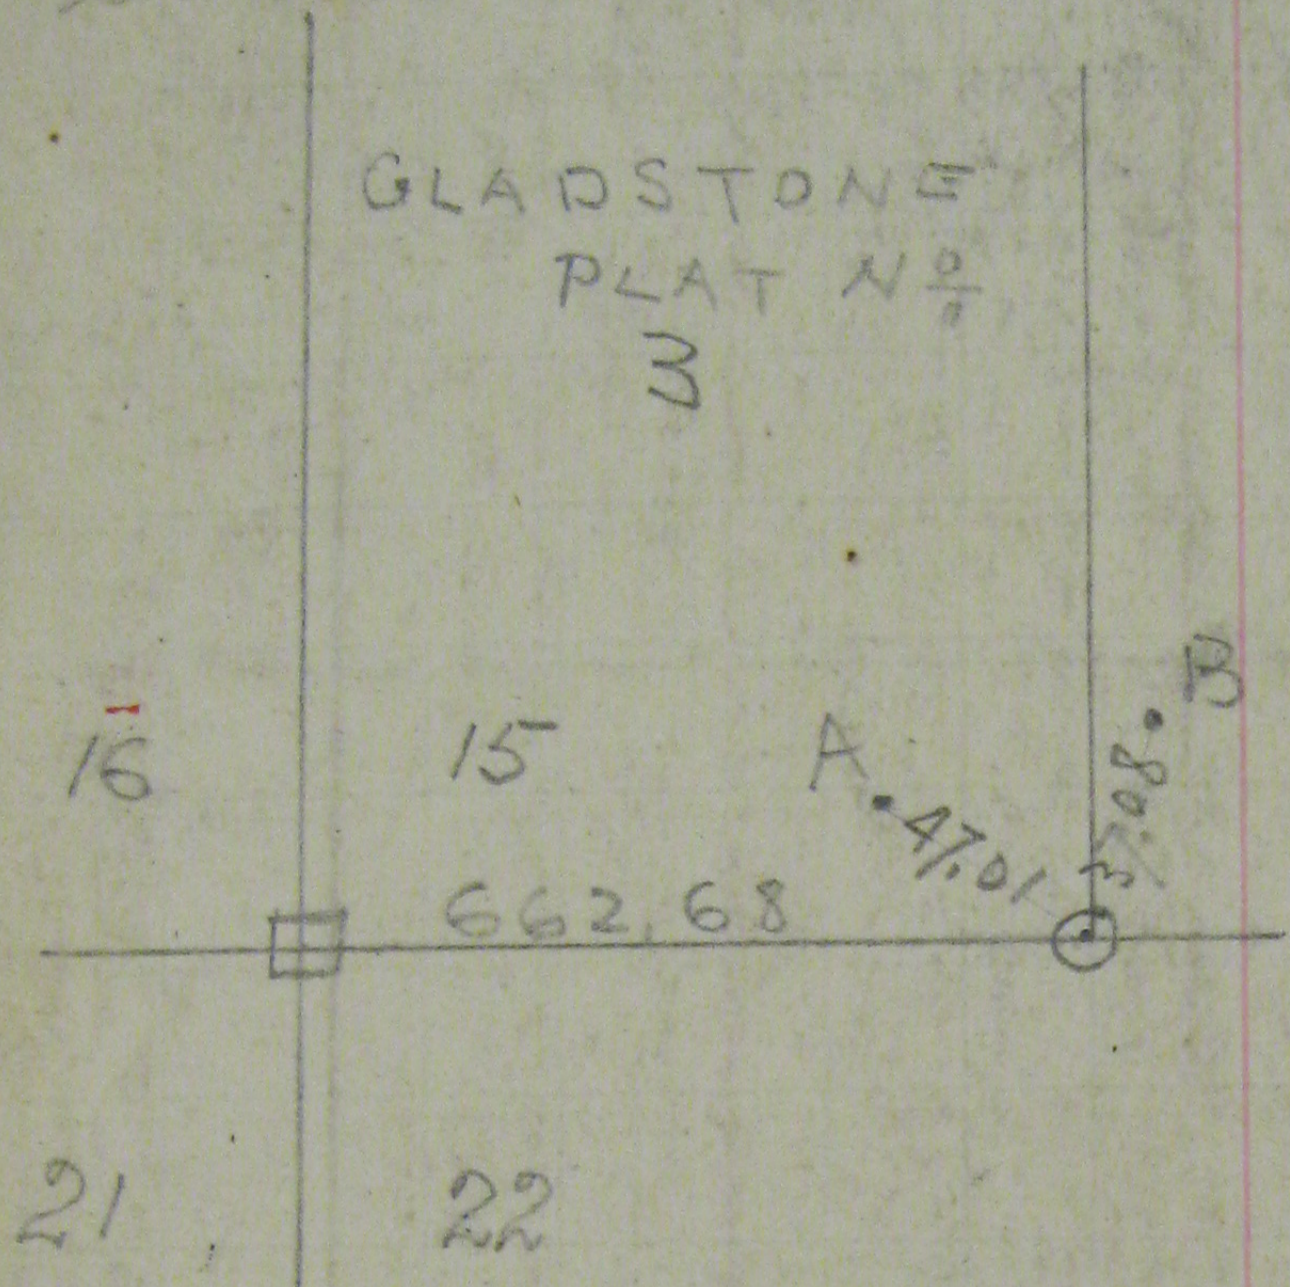

A = 3 tacks in scrub oak NW 47.01
 B = 3 tacks in Belk oak N 37.08

