


SEC 21 TOWN 29 N RANGE 22 W

24

SEPT. 1887

Notes furnished by Armstrong; one of City Engineers
16

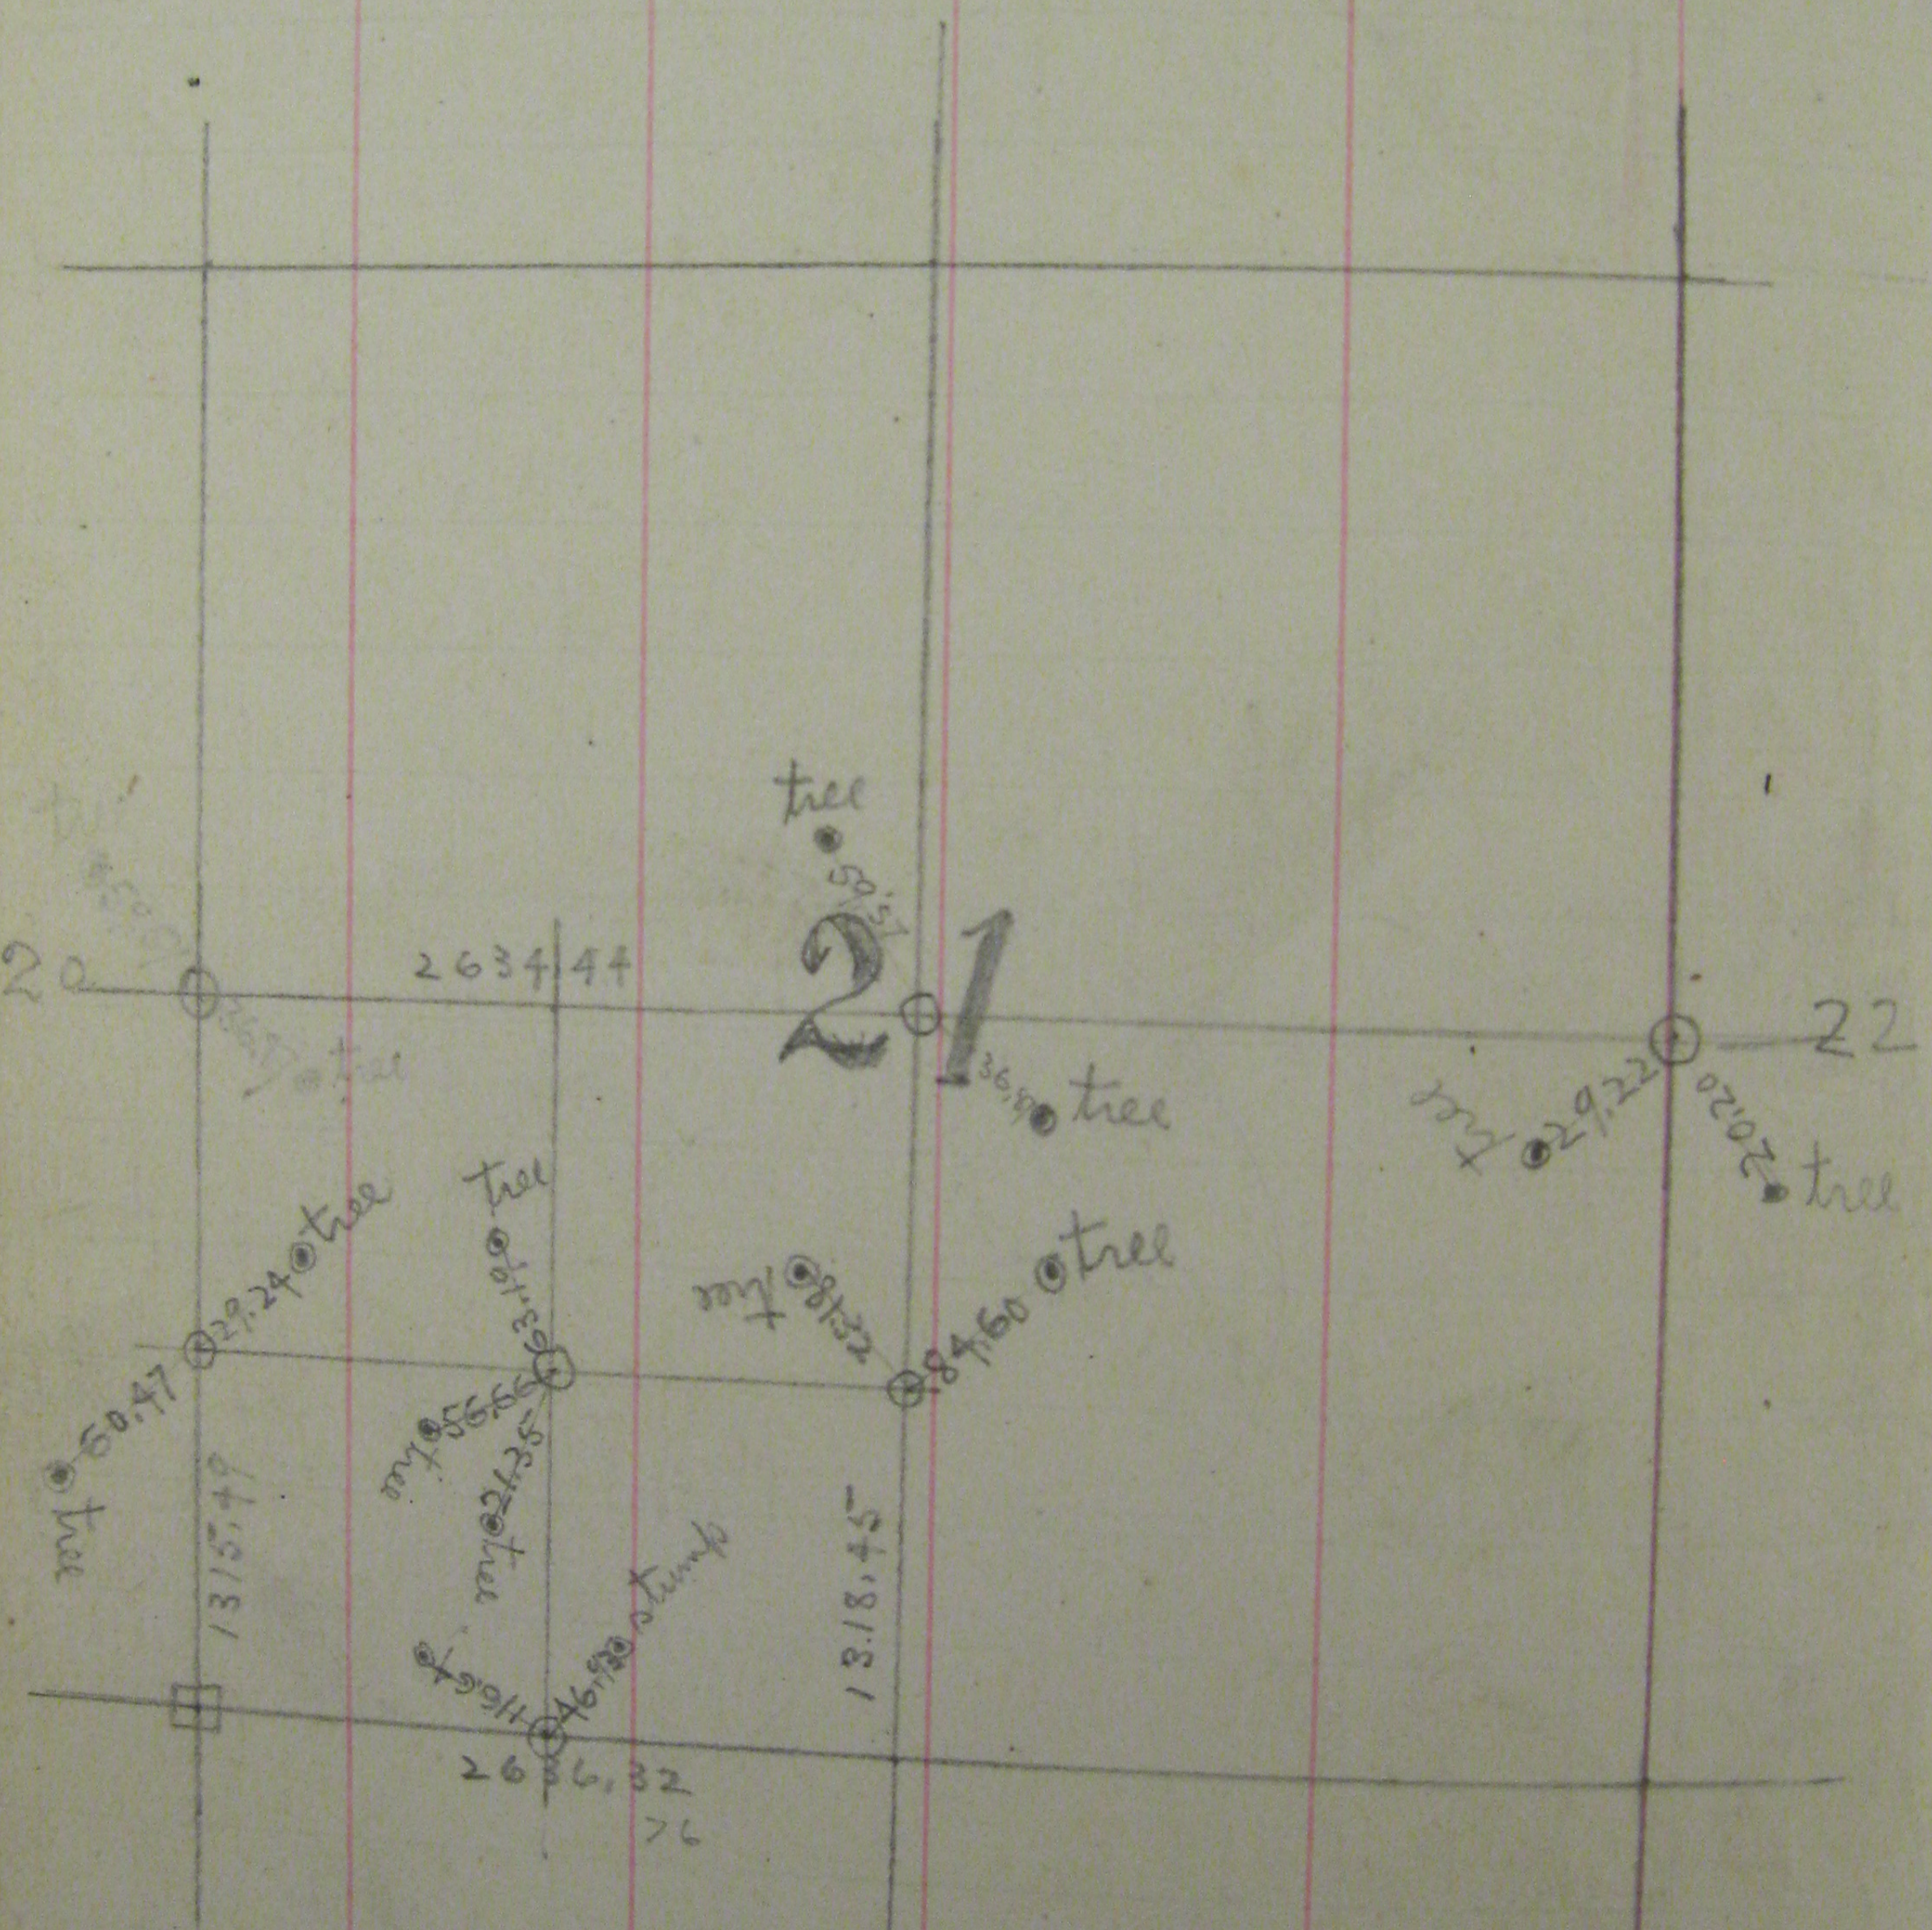

J.A. AND W.M. STEES ADD 28