


Guards to center of Sec 28 T29 Range 22^N
 Granite monument placed by City
 10.50 ft S of center of Q1 base
 and 33 feet from West side of Earl.

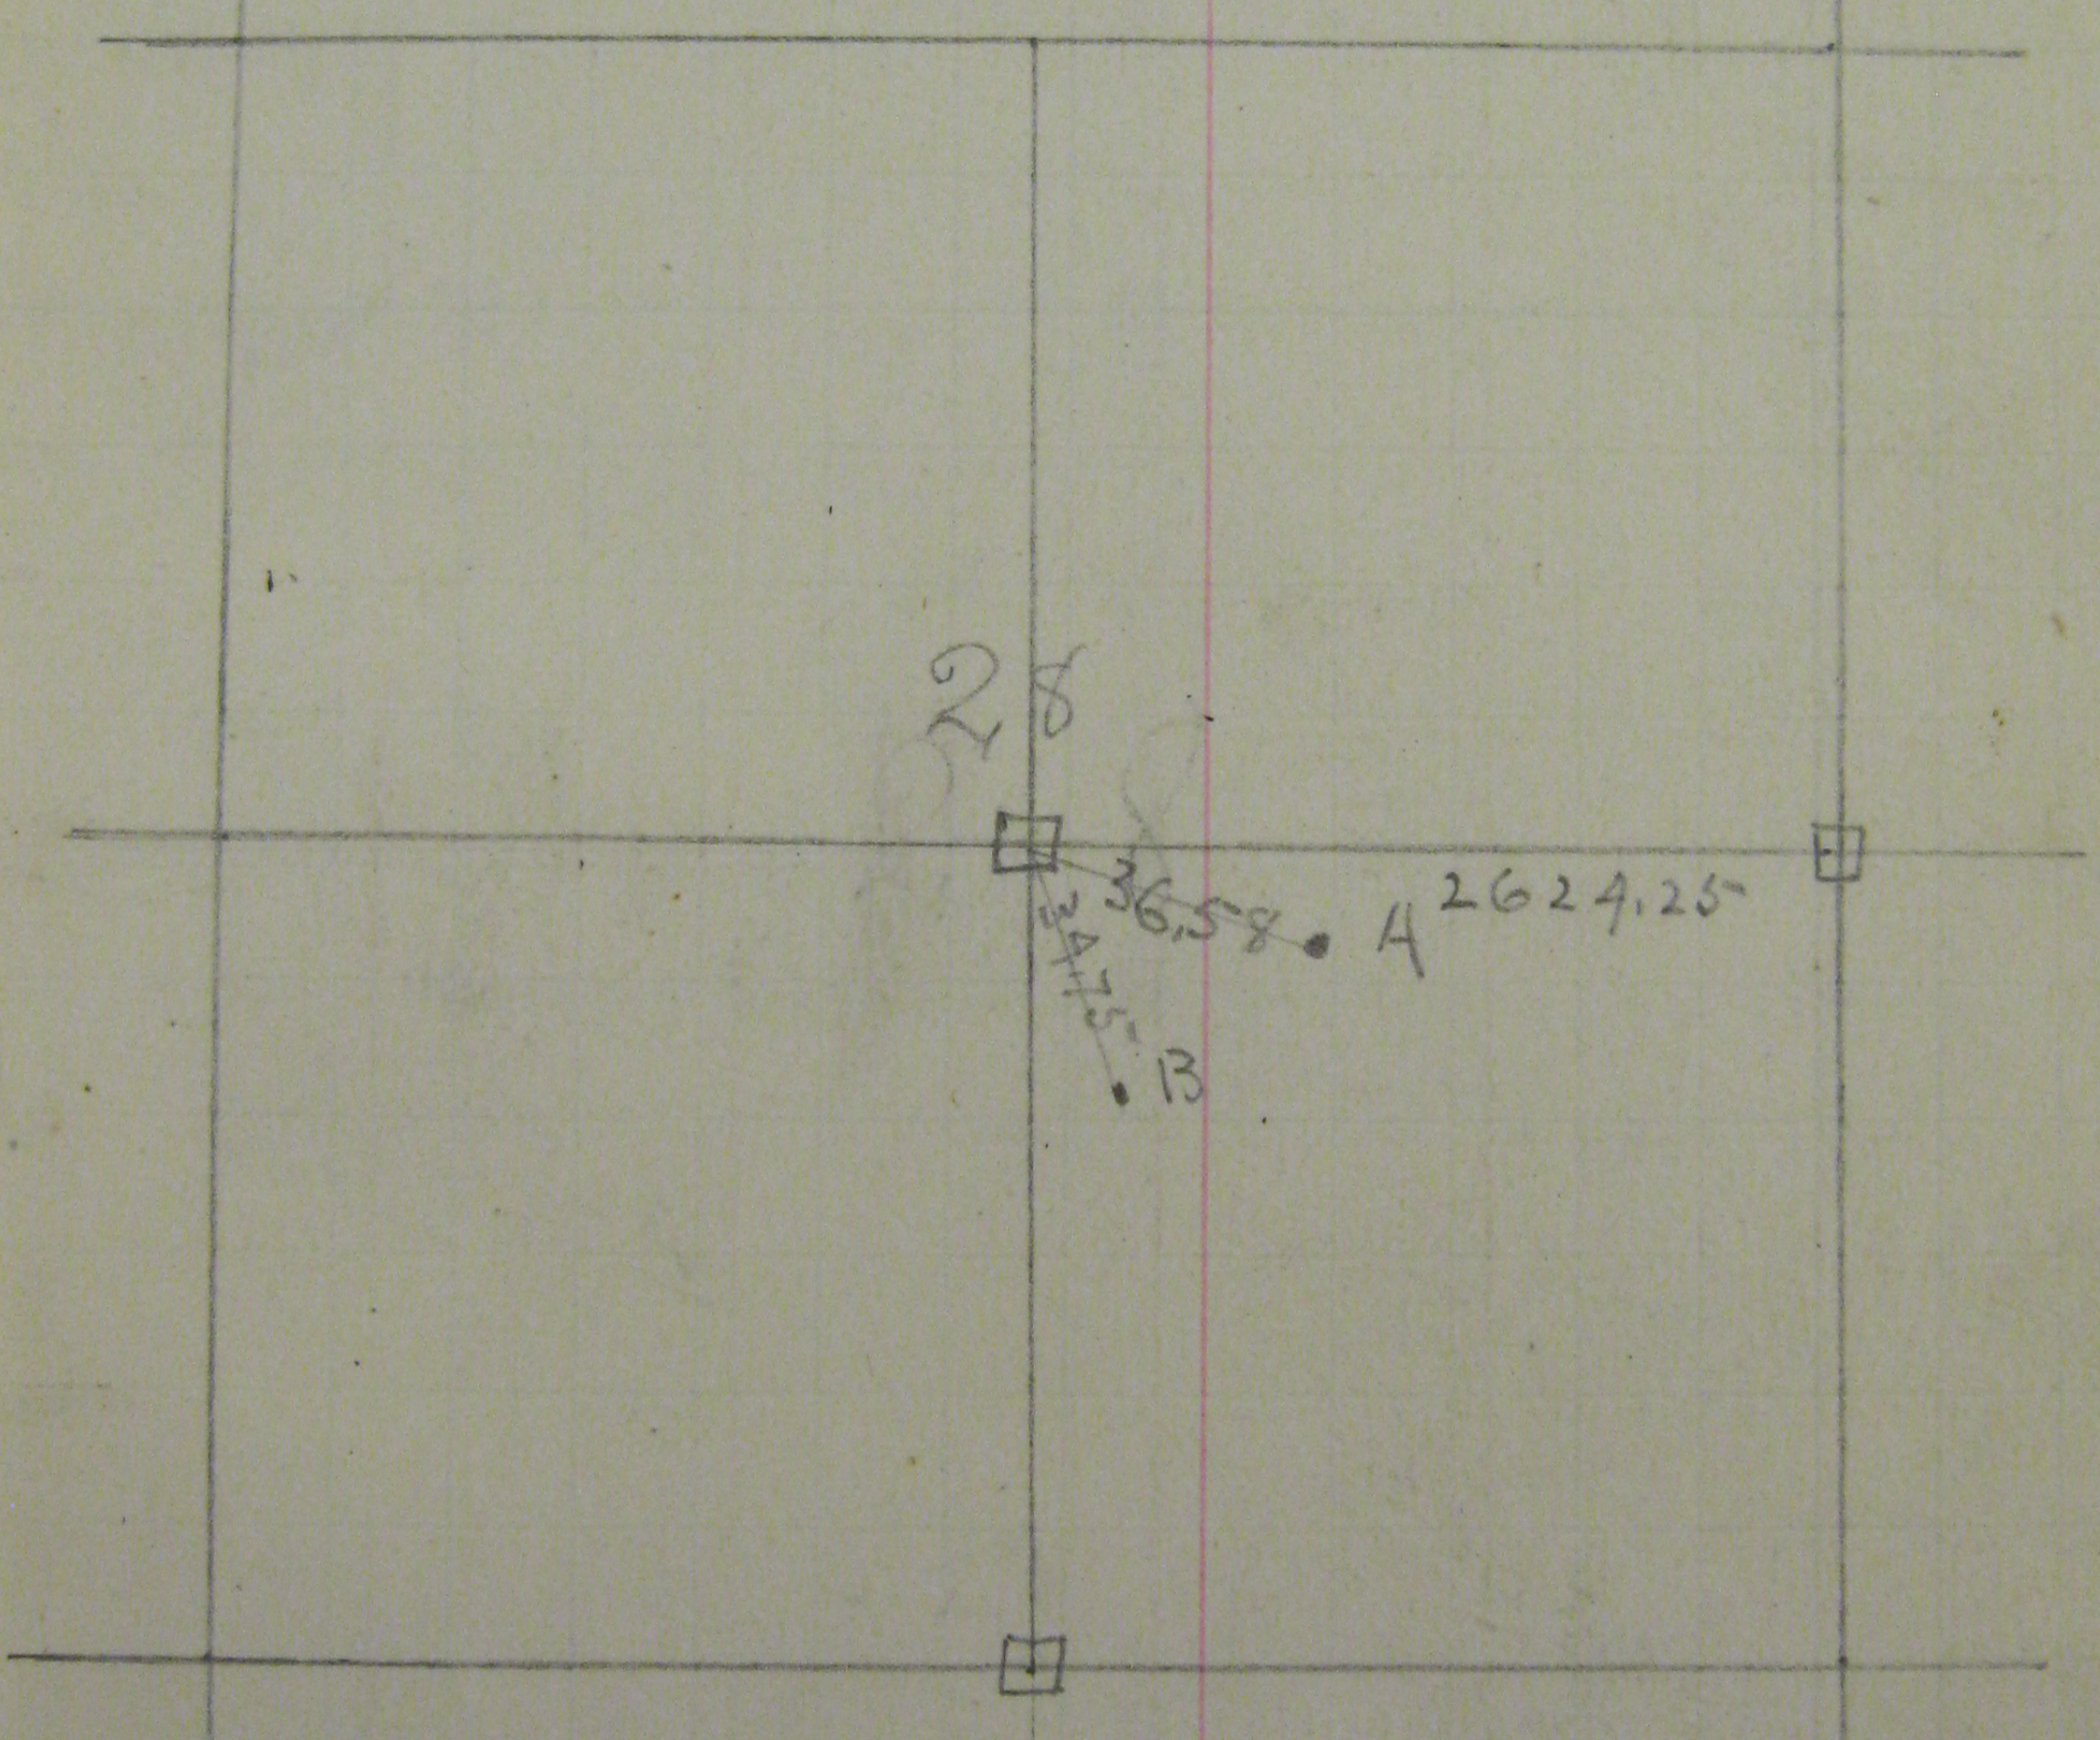

A = 3. tacks in base of BEK 0 36.58
 B = 3 " " " " " "