


April 10th 1895

Section 29 R 22

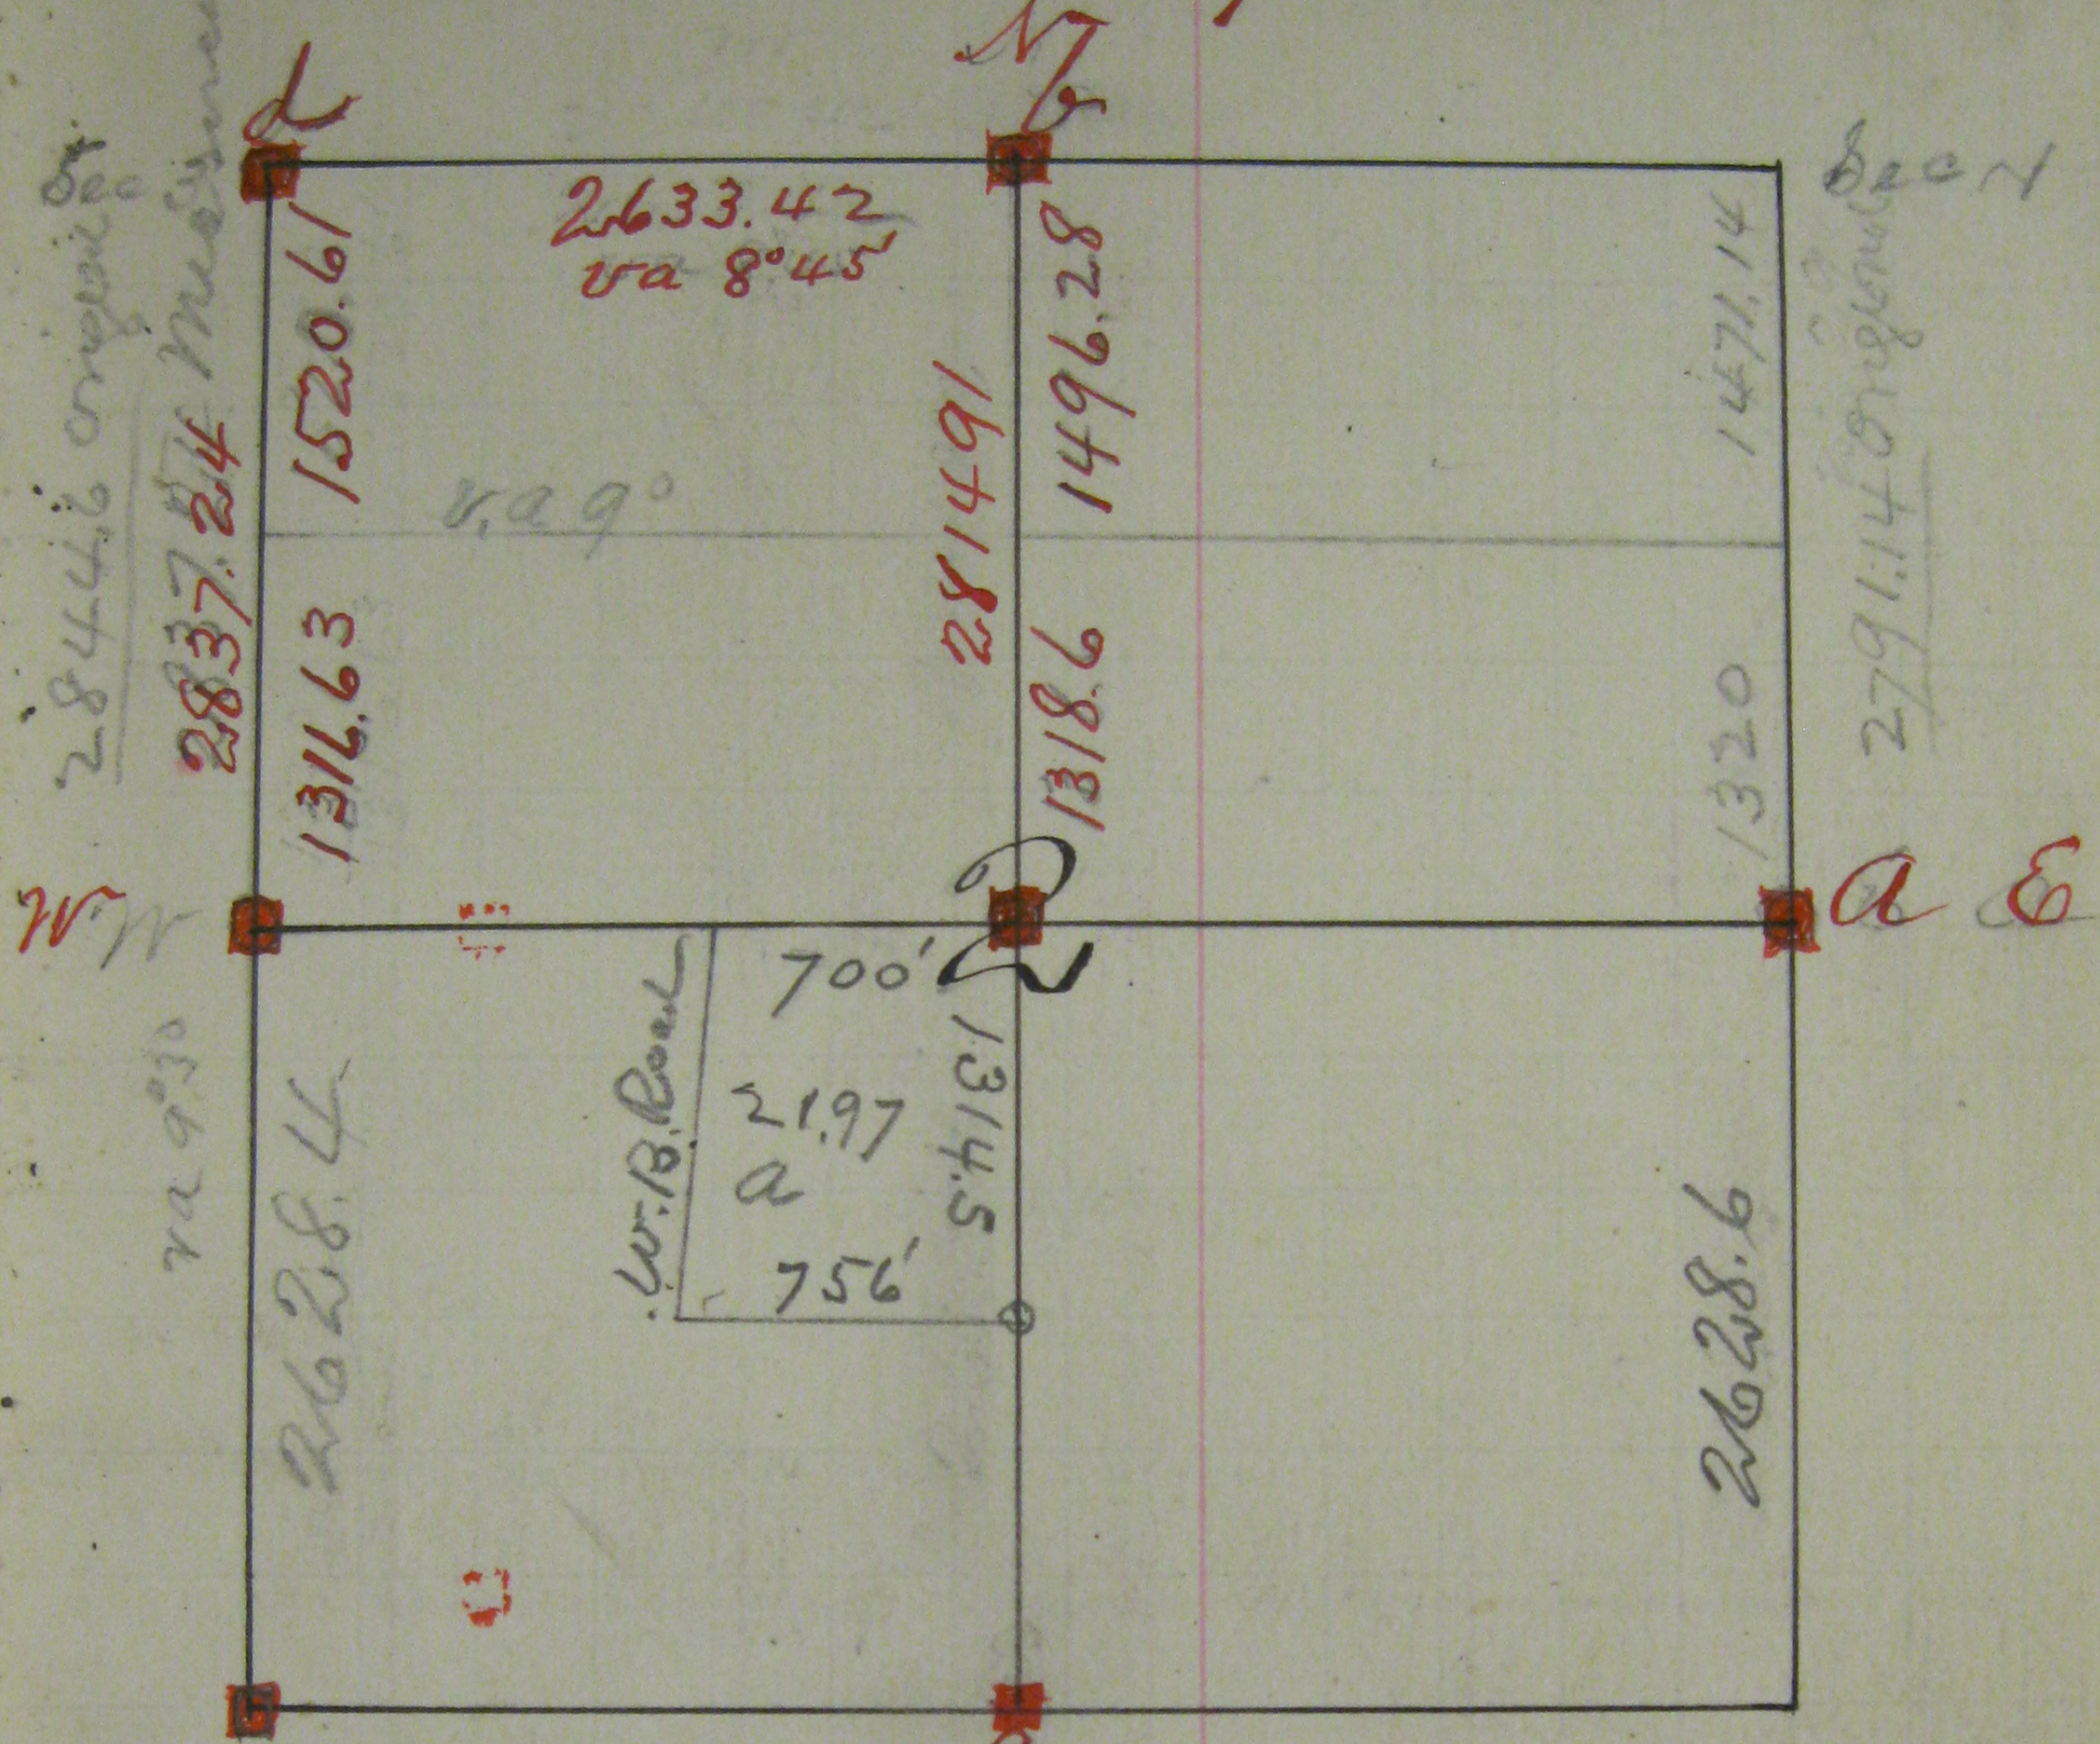

- a wit tree Br Oak S 35° W 67.98 ft
- b wit Stump Br Oak N 12° E 34.98 "
- c wit tree Brook S 54° E 71.28 "
- d wit Stump Br Oak N 83° W 38.28 "