


# Sec 2

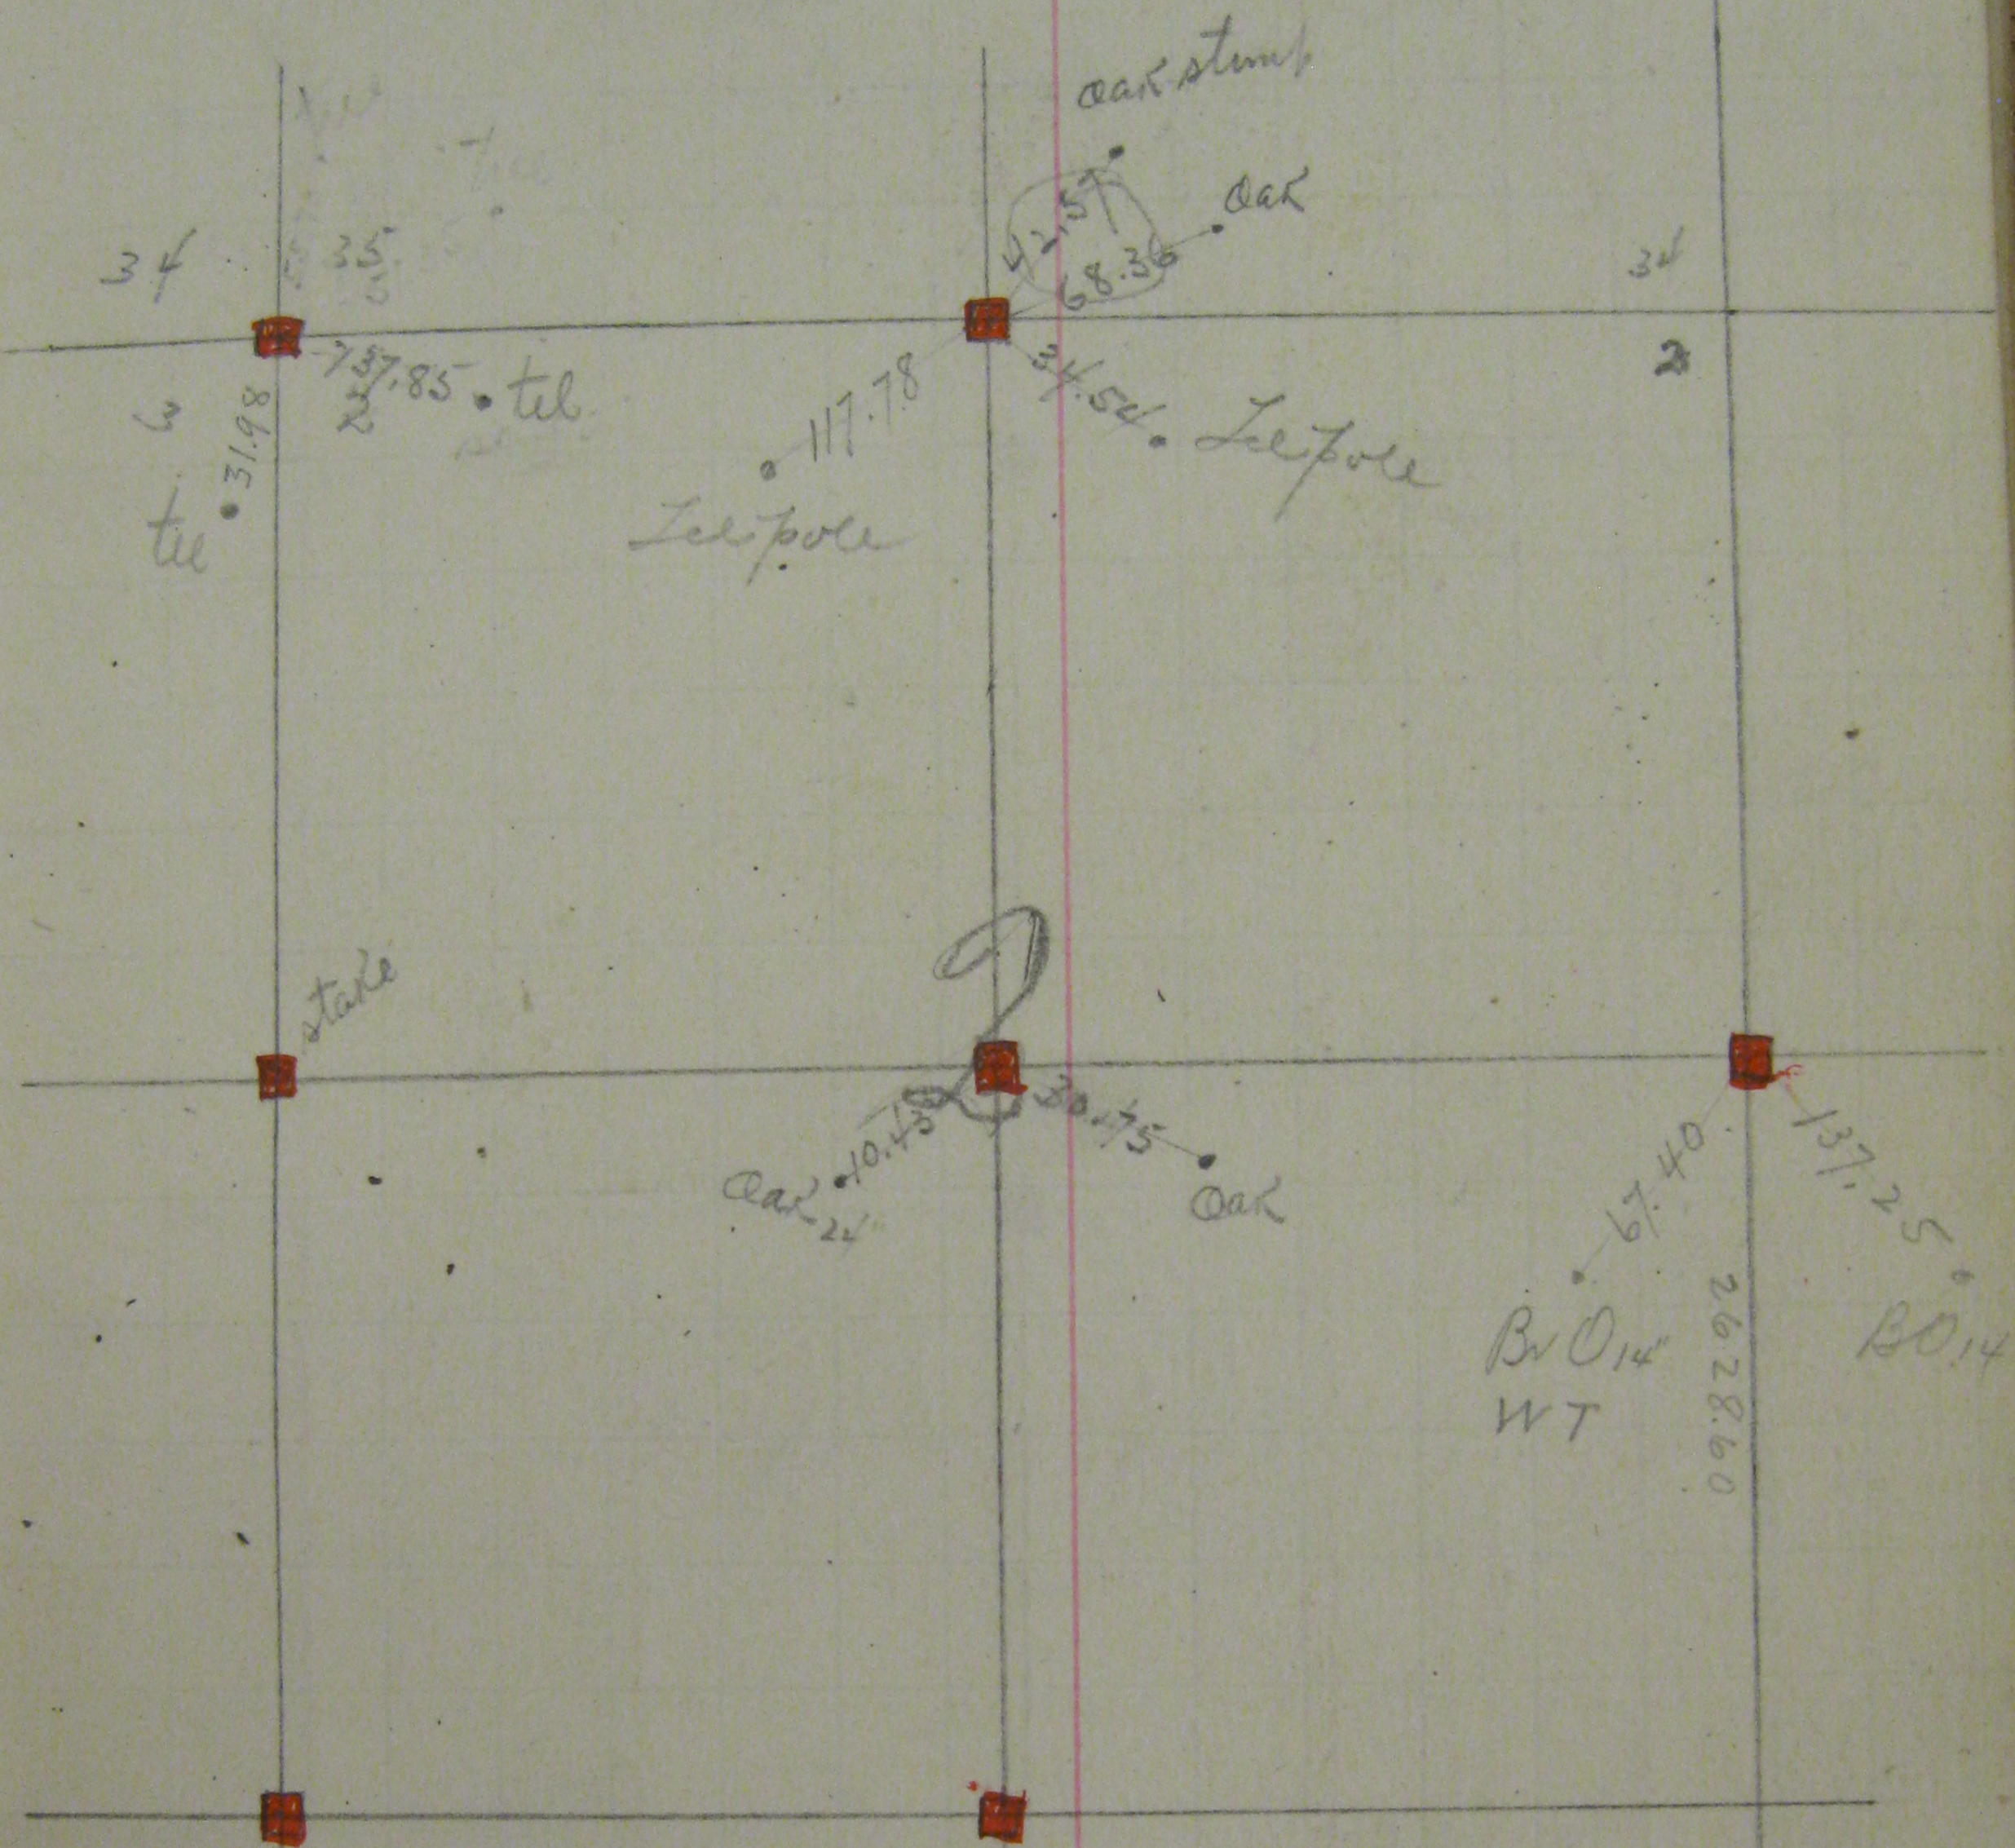

Mont N Y Cor sec 2. Covered up one foot.