


Sec 6

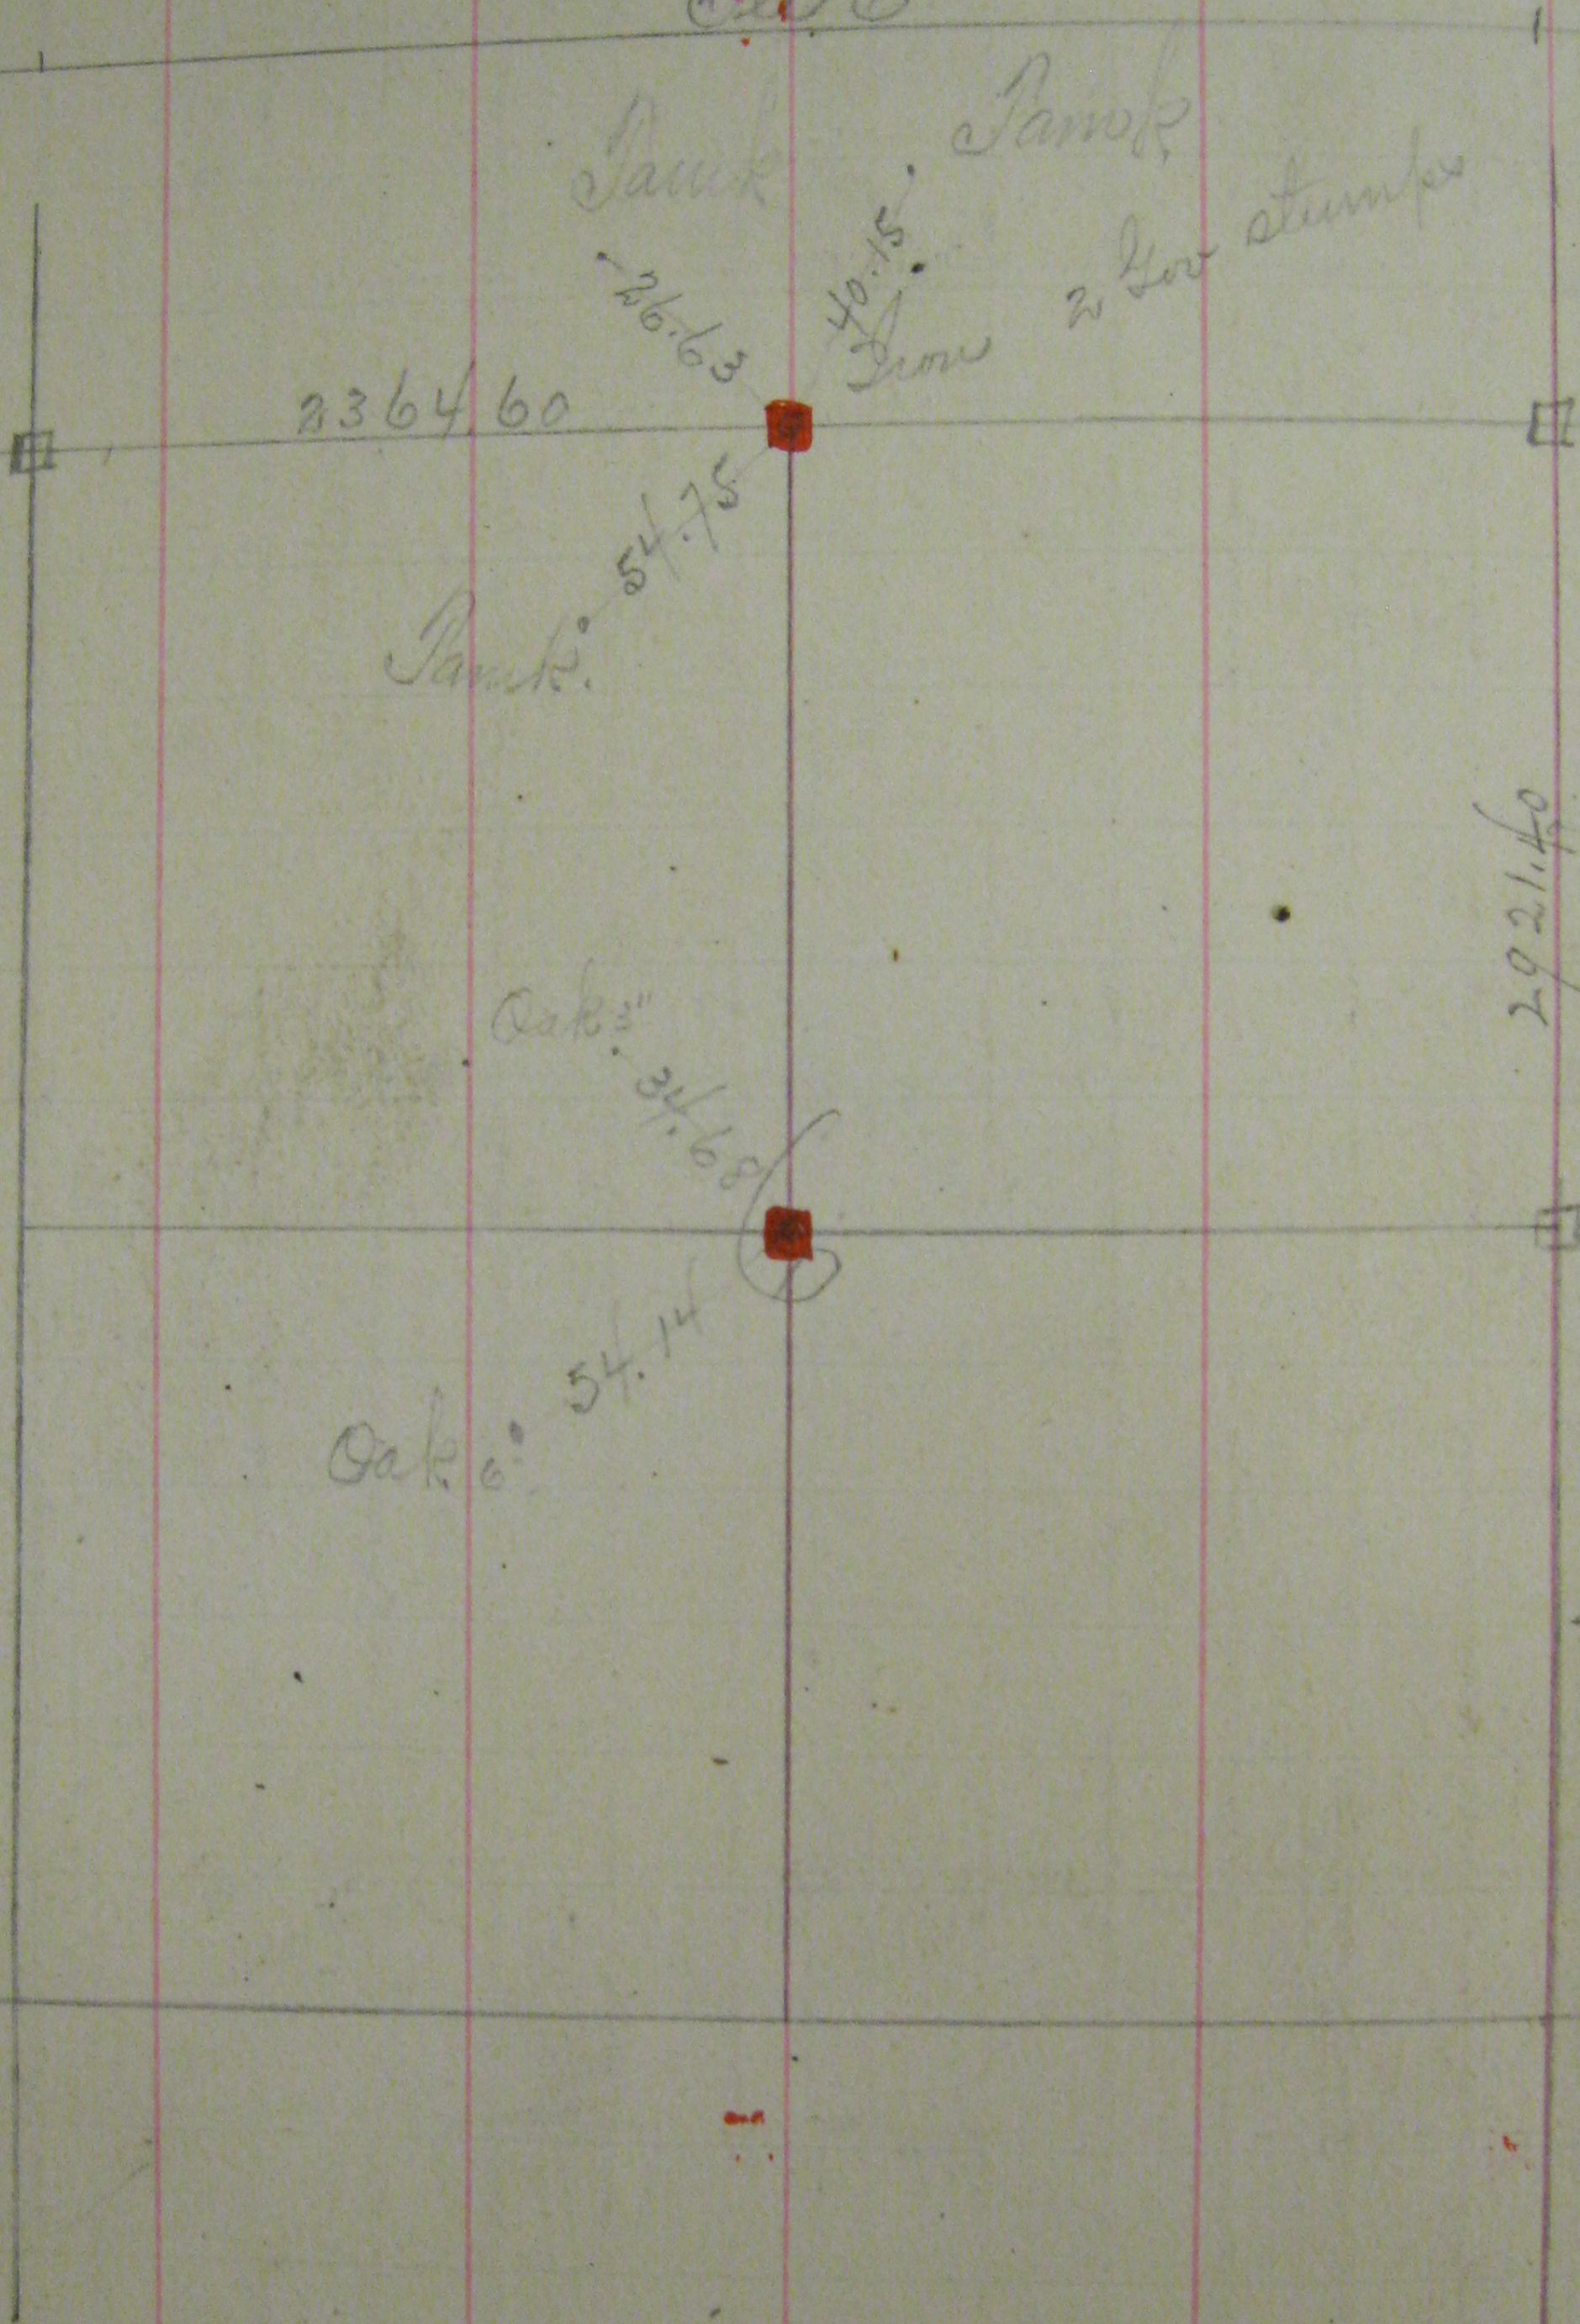

June 1st 1892 find 1/4 Sec on N. of Sec 6 found
 two low stumps and June Month