


Quarrels 1/4 corners on N & S sides  
of Sec 5. T29 R22

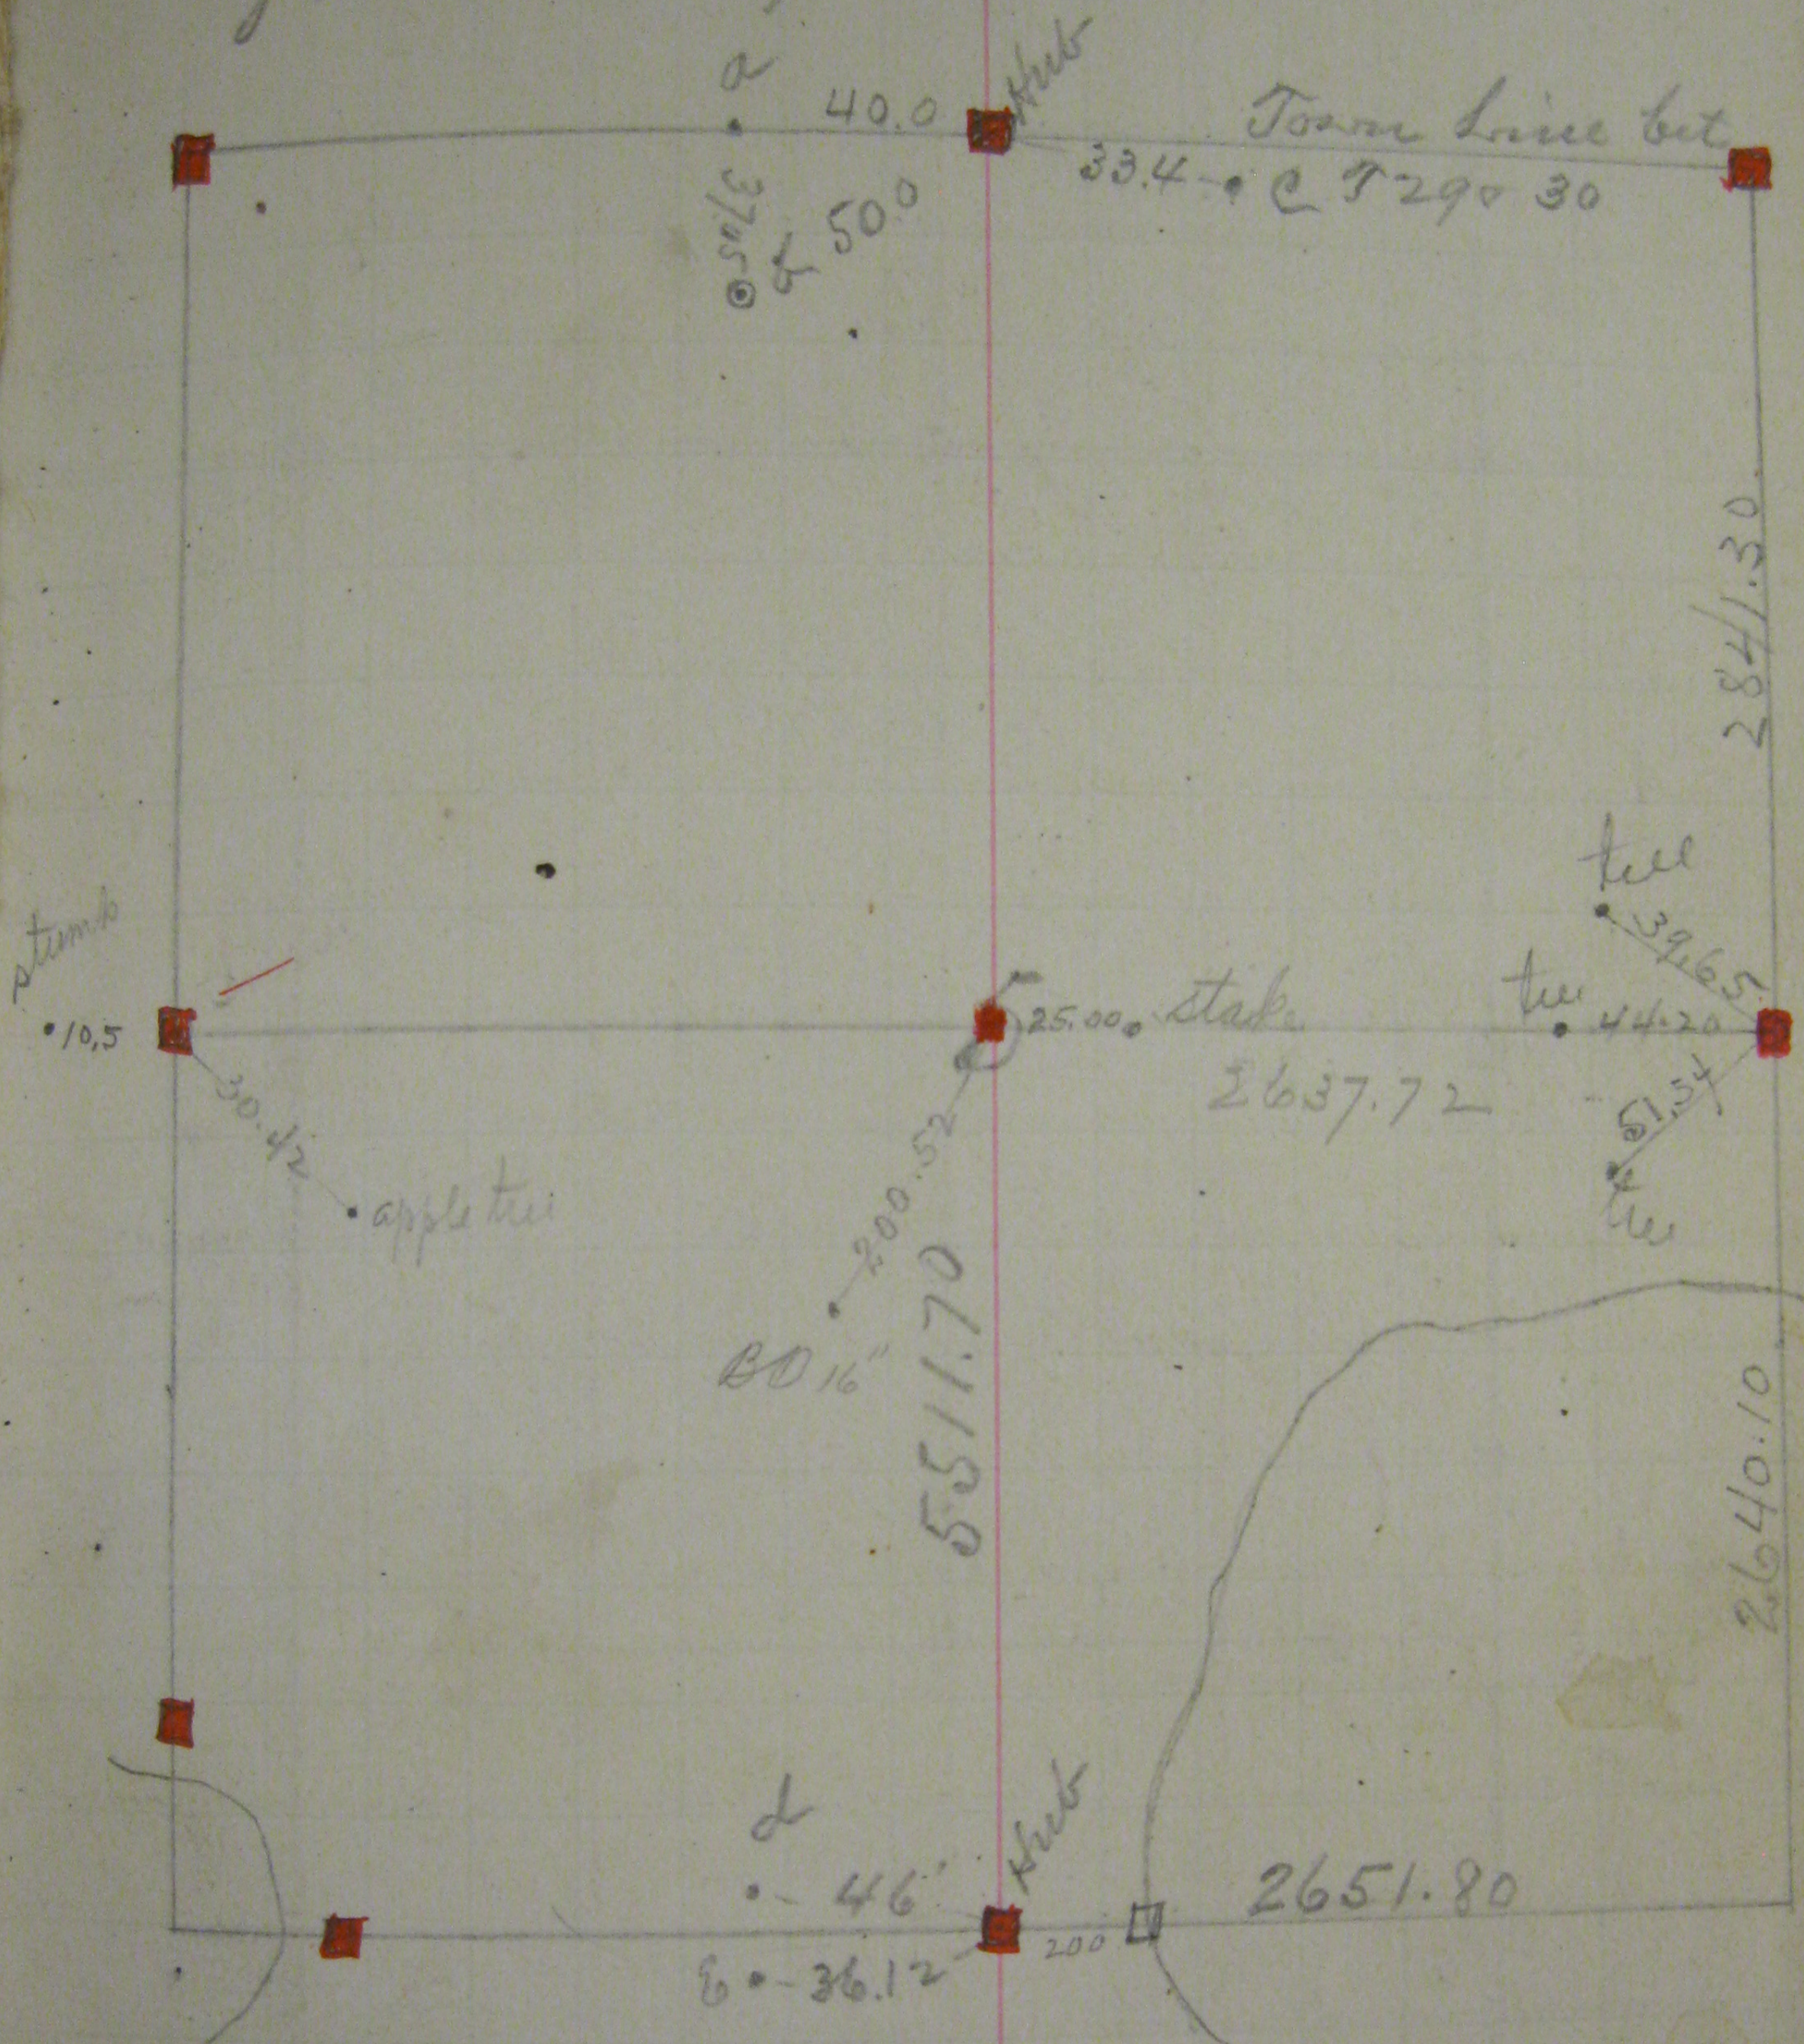

- a Black Walnut Stake west 40.0
- b Oak Stake South of line 50.00
- c Short oak tree broken off 33.4
- d Willows Near Road N side 46.0
- e " " " " S d 36.12