


31.

July 28th 1896 Filed 1/4 Cor of Sec 11
found old iron stake

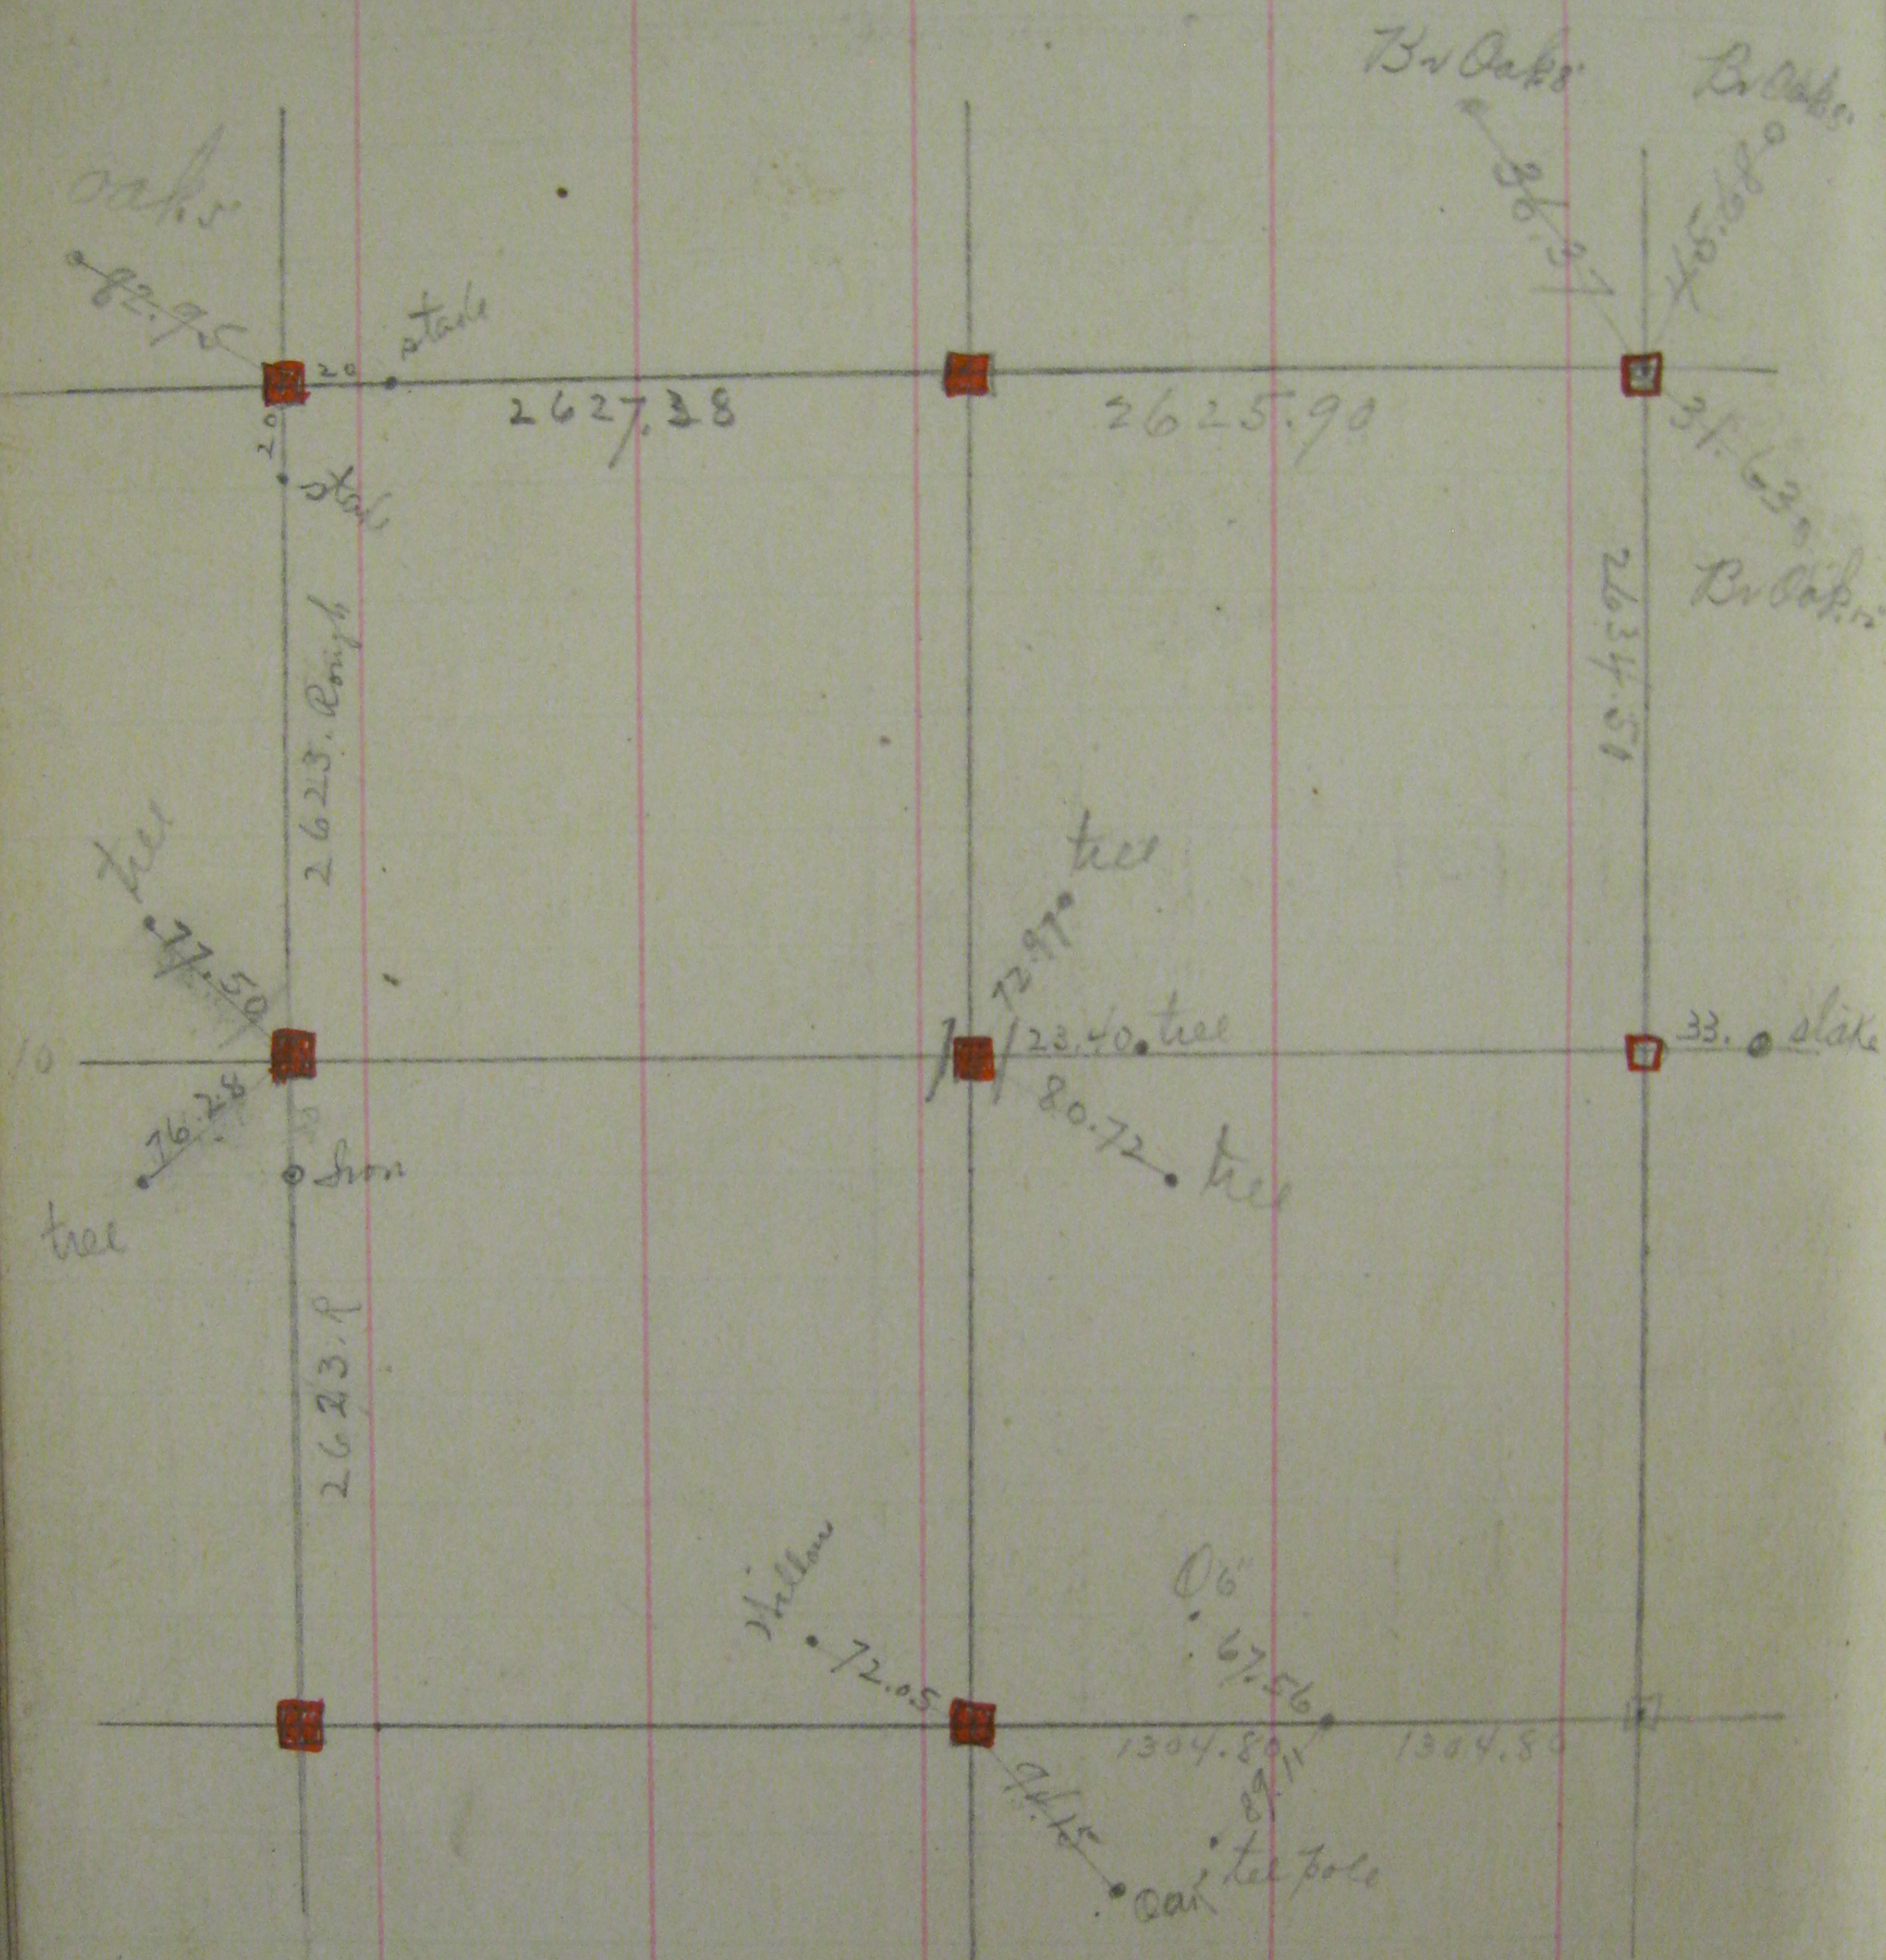

1/4 sec cor between 11 & 14 one foot witness stump
standing aug 22/96
Dec 22-98 filed Sec Cor 1-2-11-12 found
2 low trees
Dec 29-98 filed 1/4 Cor bet Sec 11 & 12 found iron
at Bk corner