Guards to 1/4 1/4 post North of 1/4 section 4
Cor between Sections 14 & 15 T 29 R 22

and 10 Aug 1887 { A = 3 Nails in base of Scrub Oak S.W. 17.43
B = 3 " " " " " Blk Oak S.E. 51.27

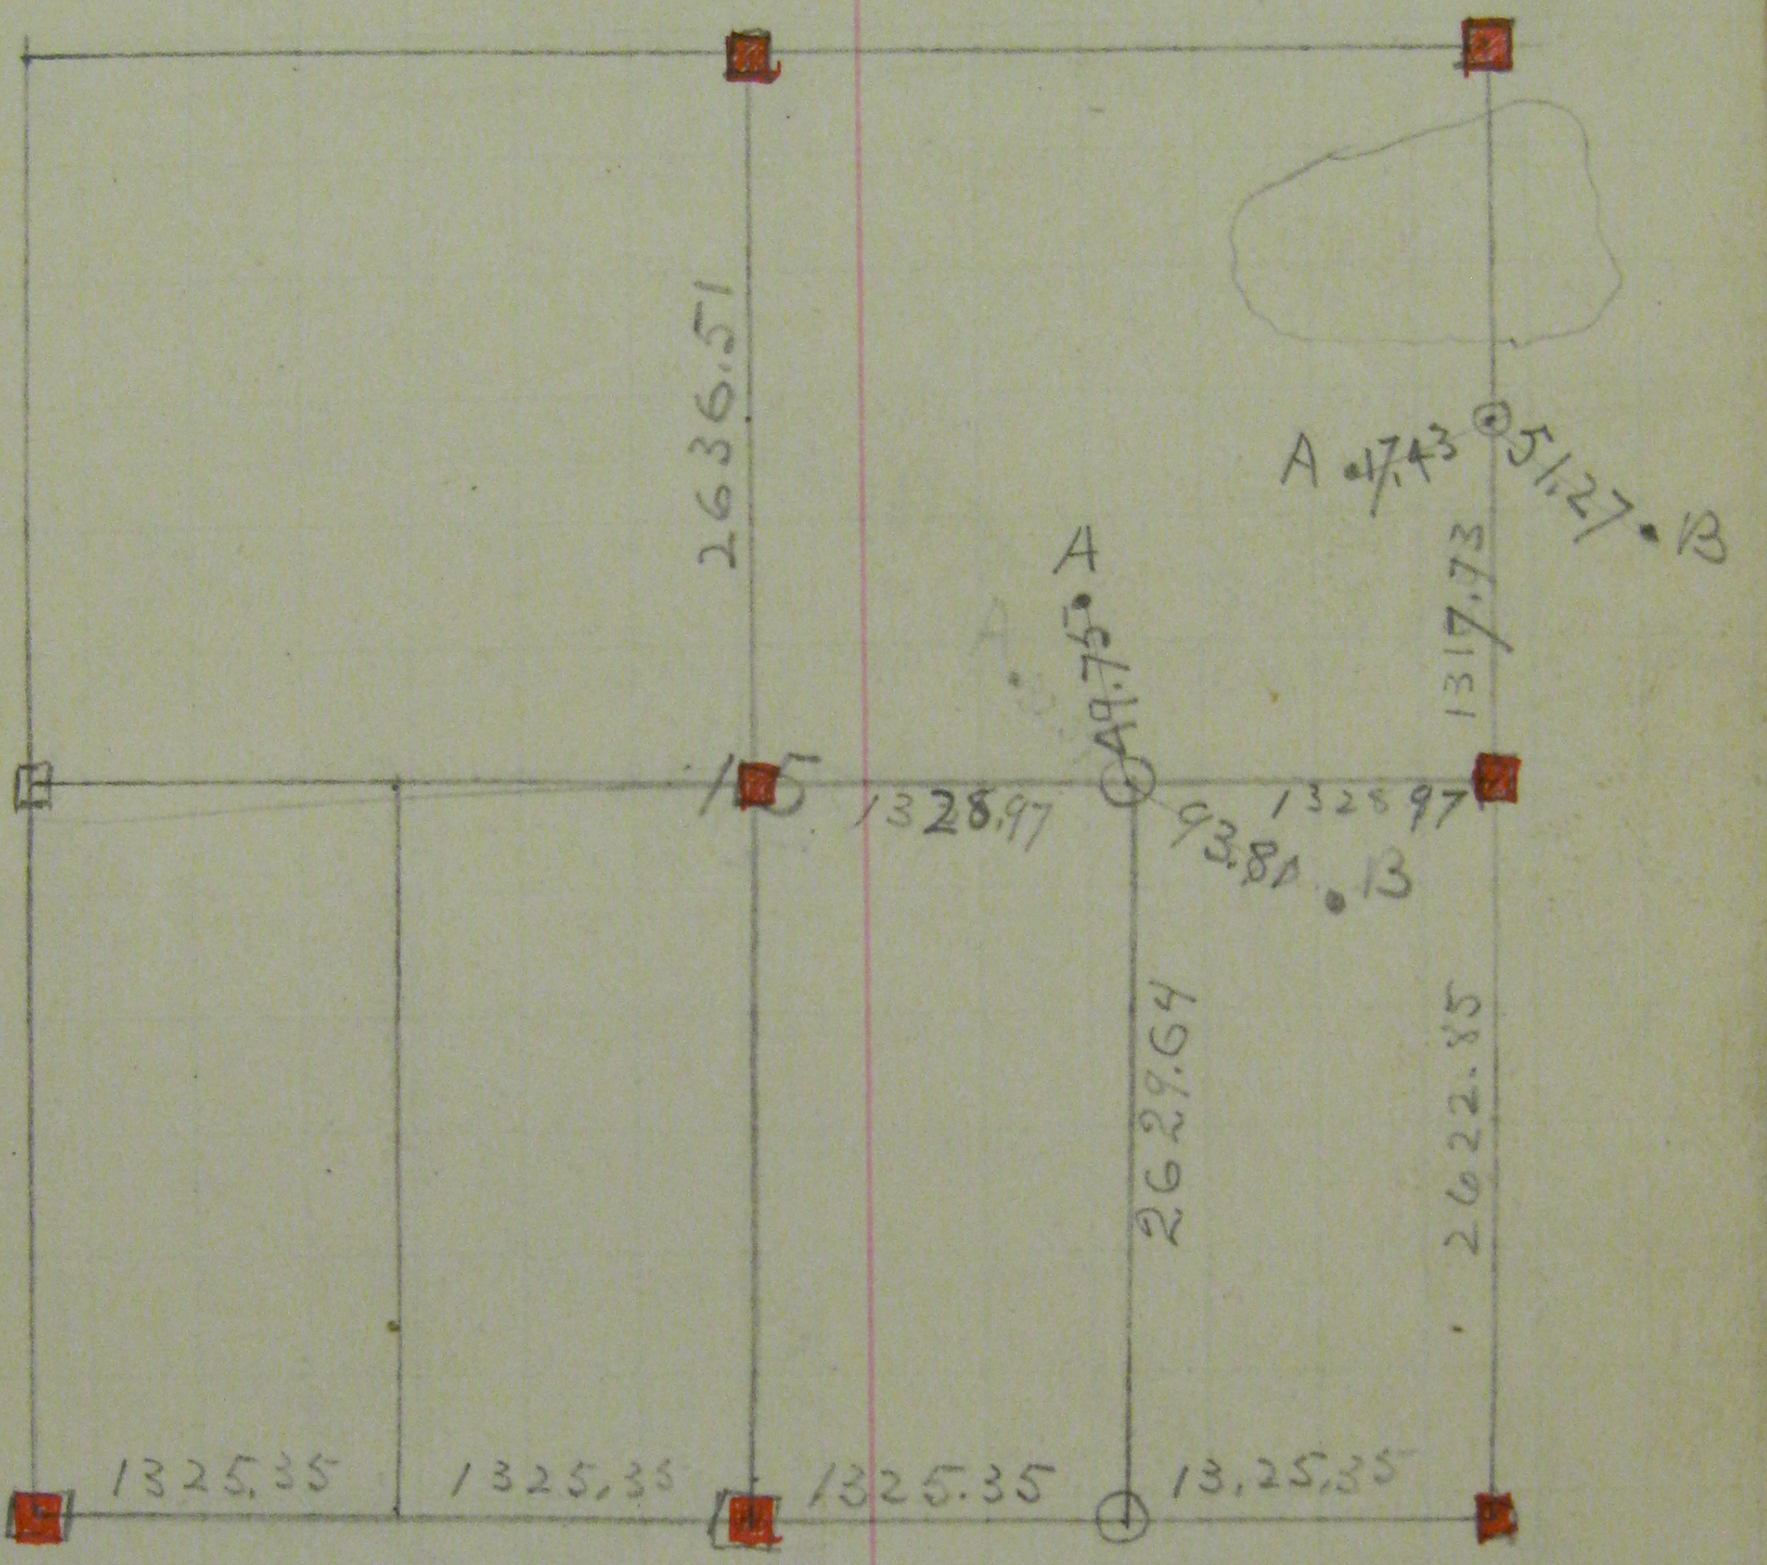


60
22

A = 3 Nails in Base of Blk O (4") 49.75
B = 3 " " " " White O (5") 93.81