Sec 25

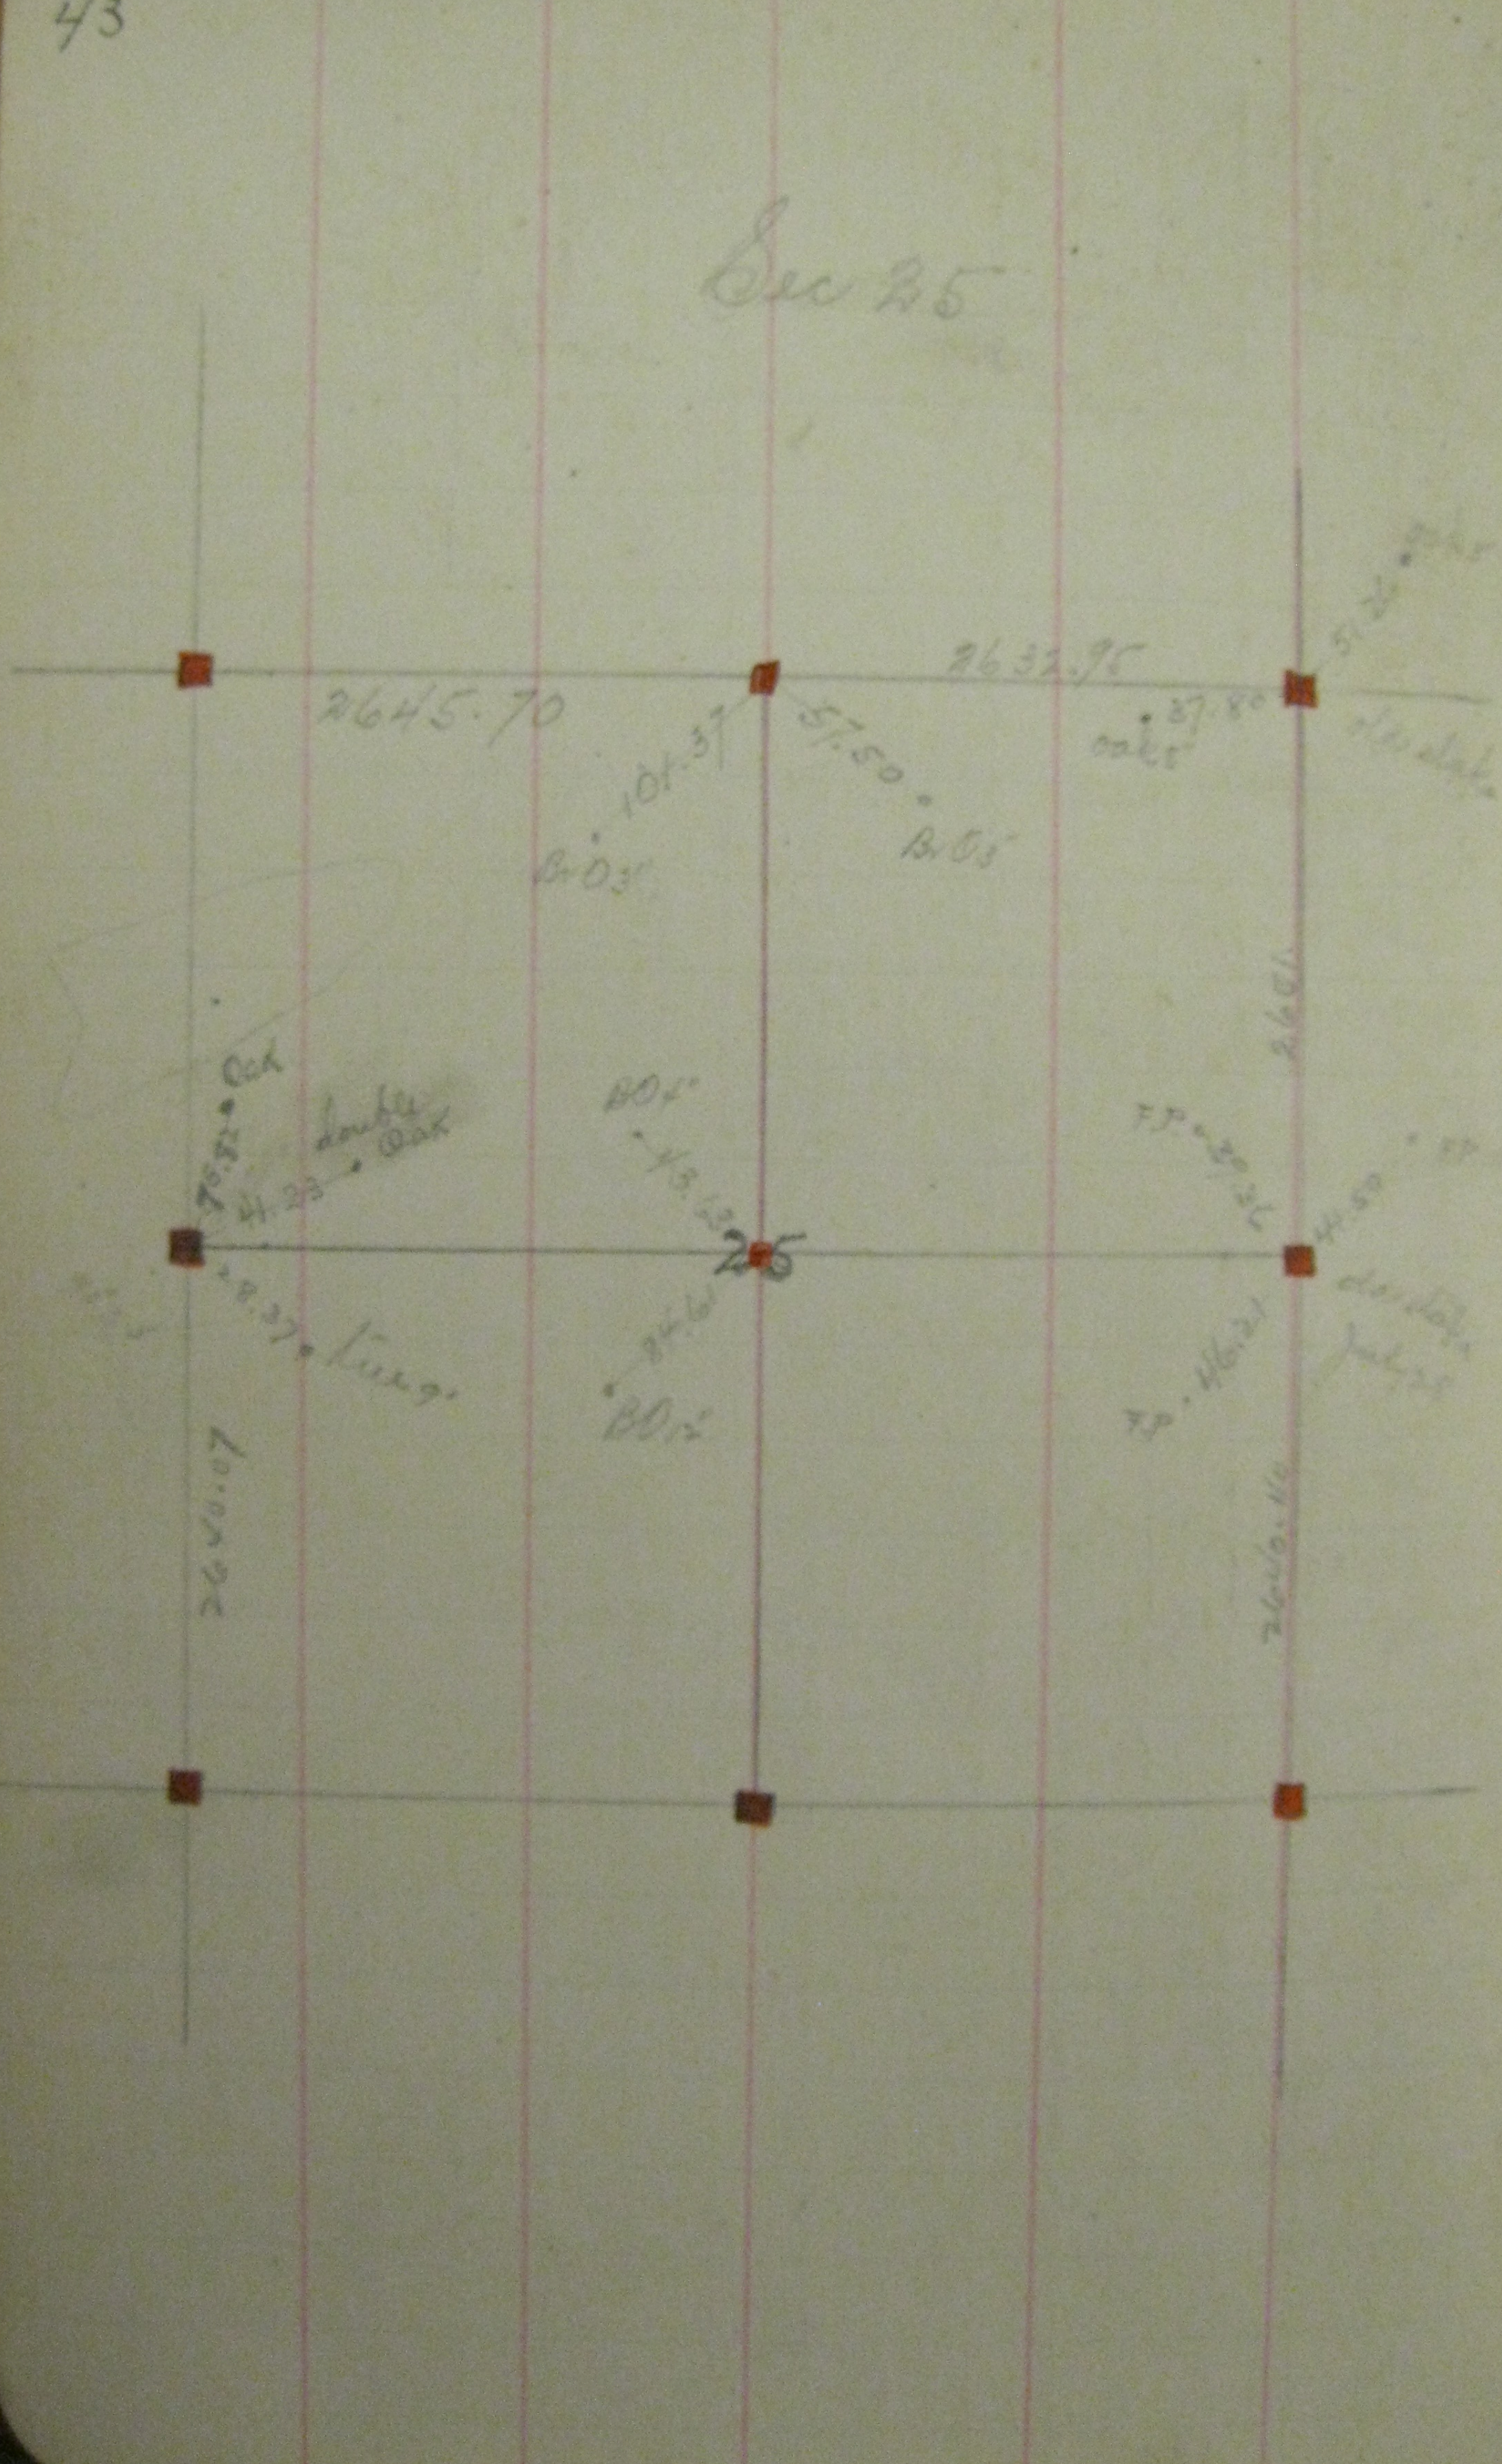
2645.70
2632.96
25
Oak
Double Oak
B.O.
B.O.
B.O.