


Variation of Elm 12 = 8° 30'

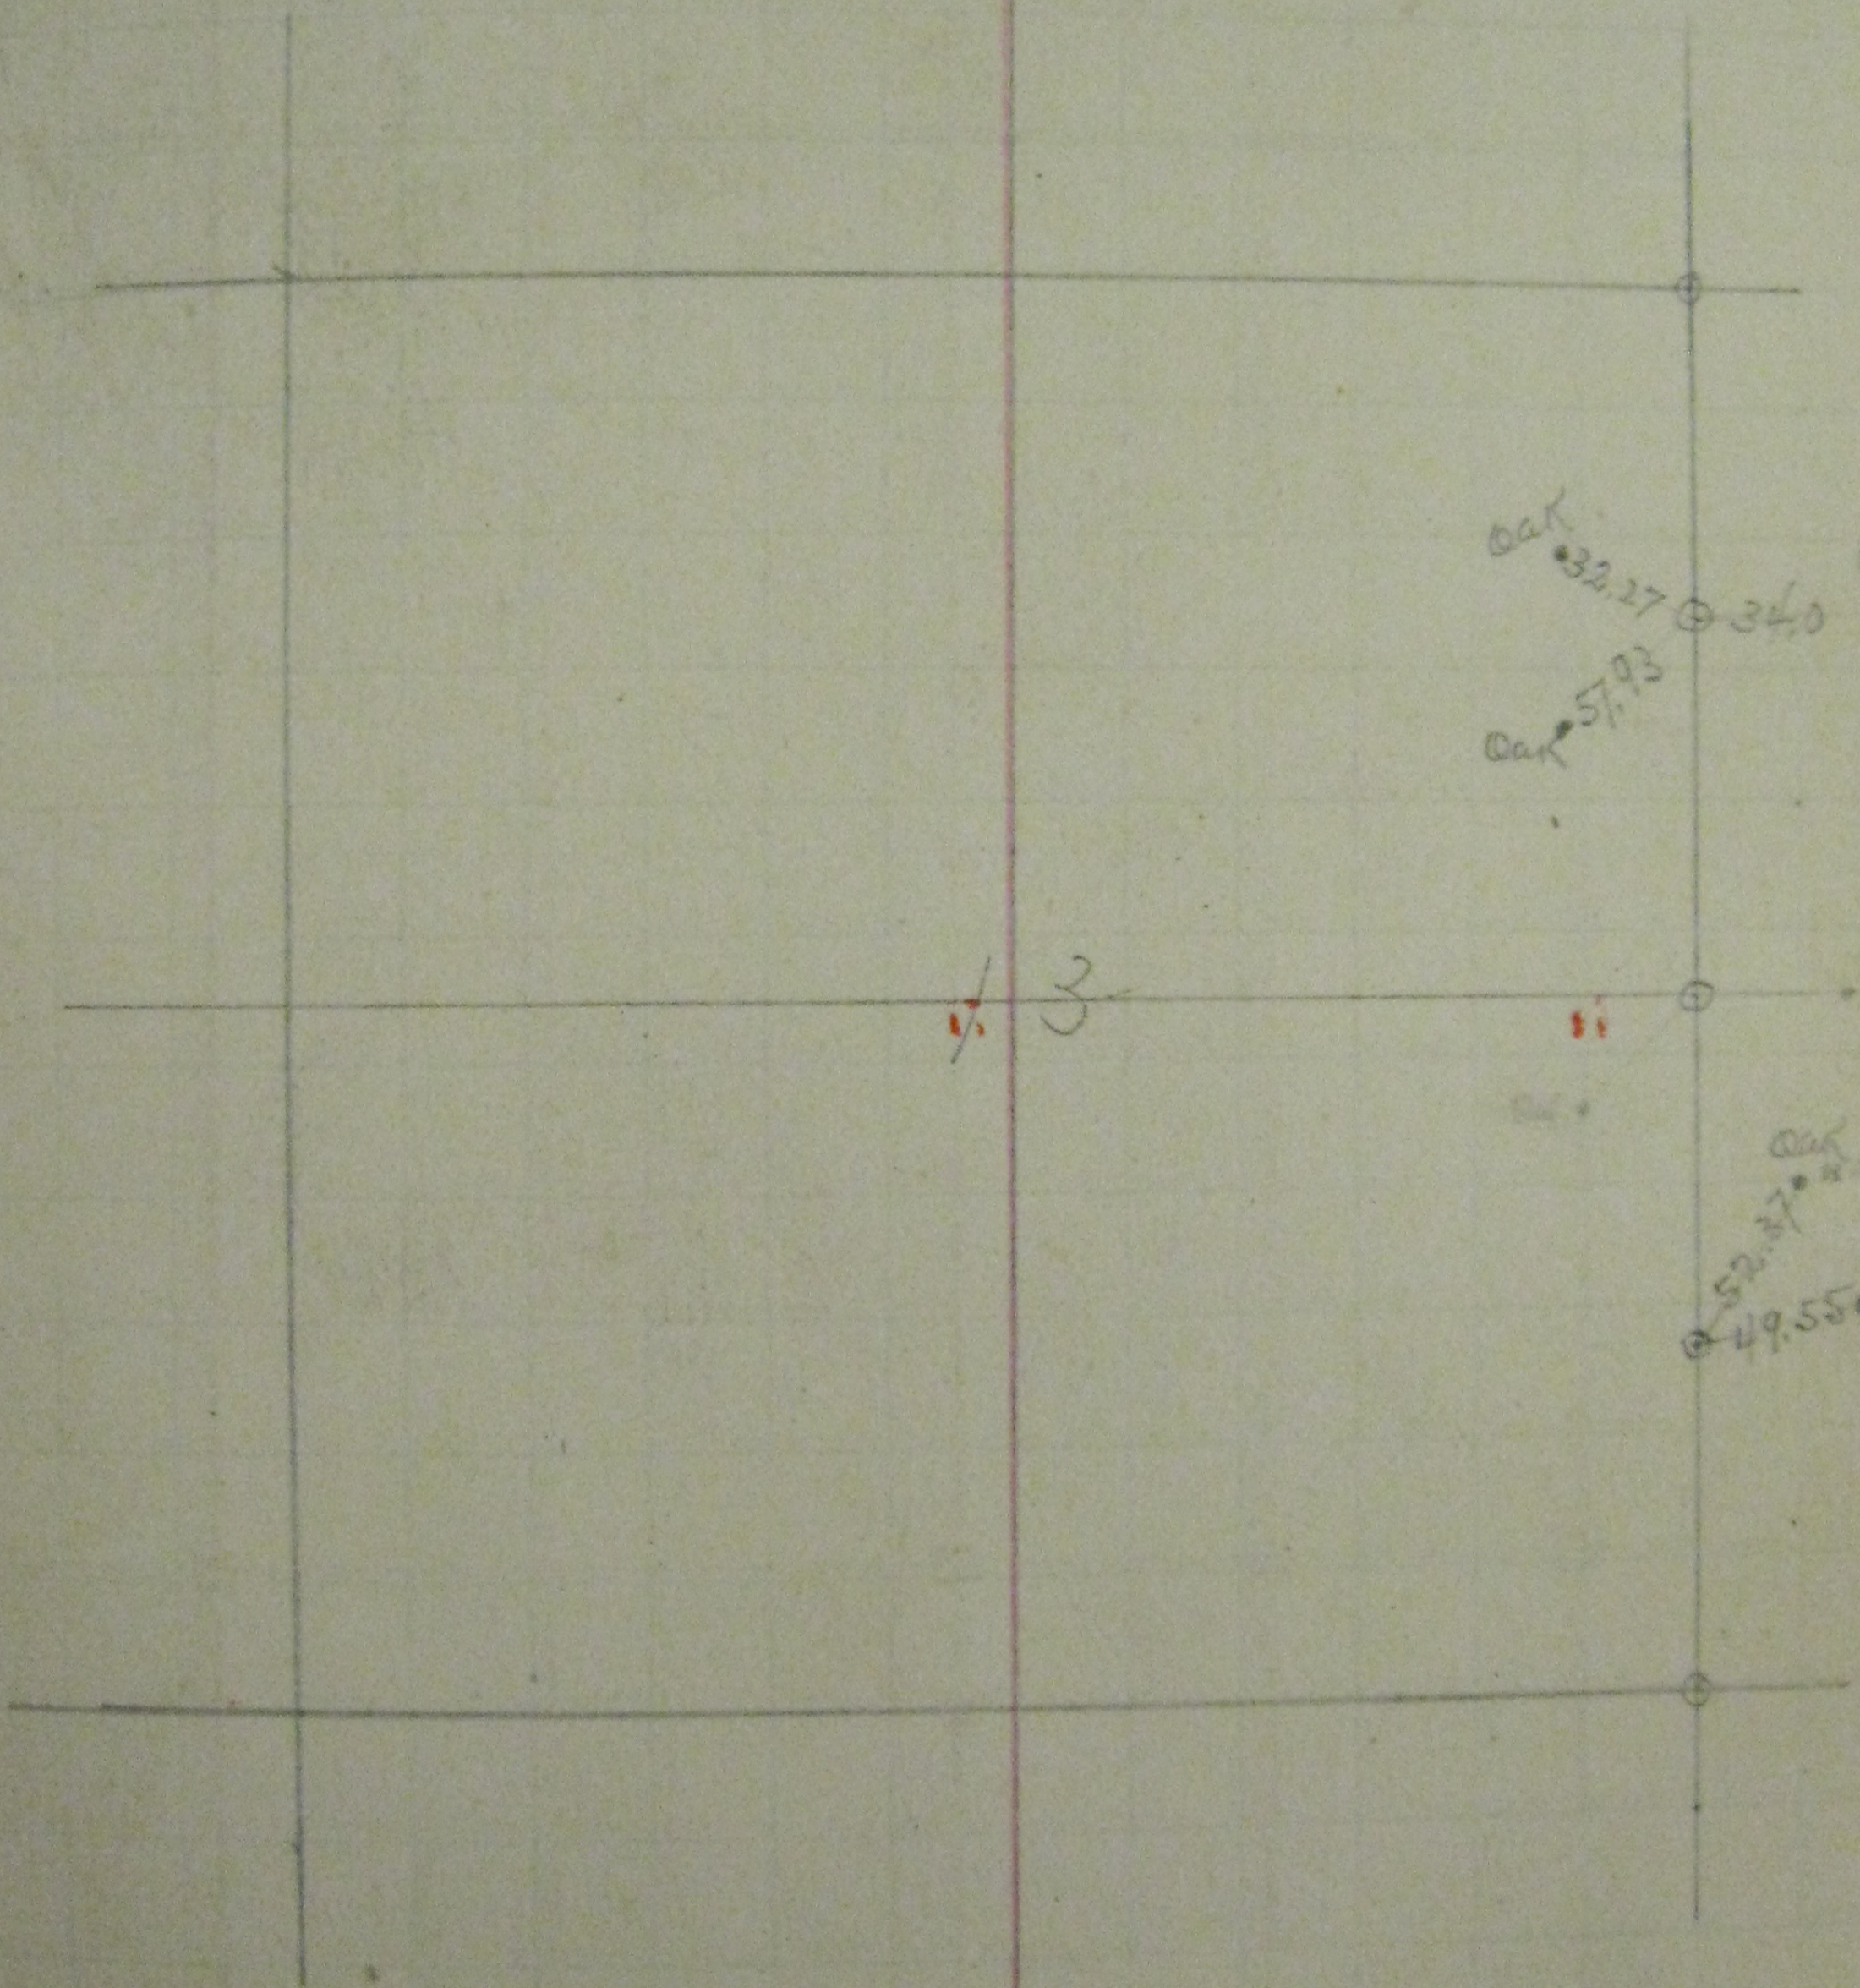

Oak 32.27
 Oak 34.0
 Oak 57.93

3

Oak 52.27
 Oak 49.55