


July 19

Sec 4

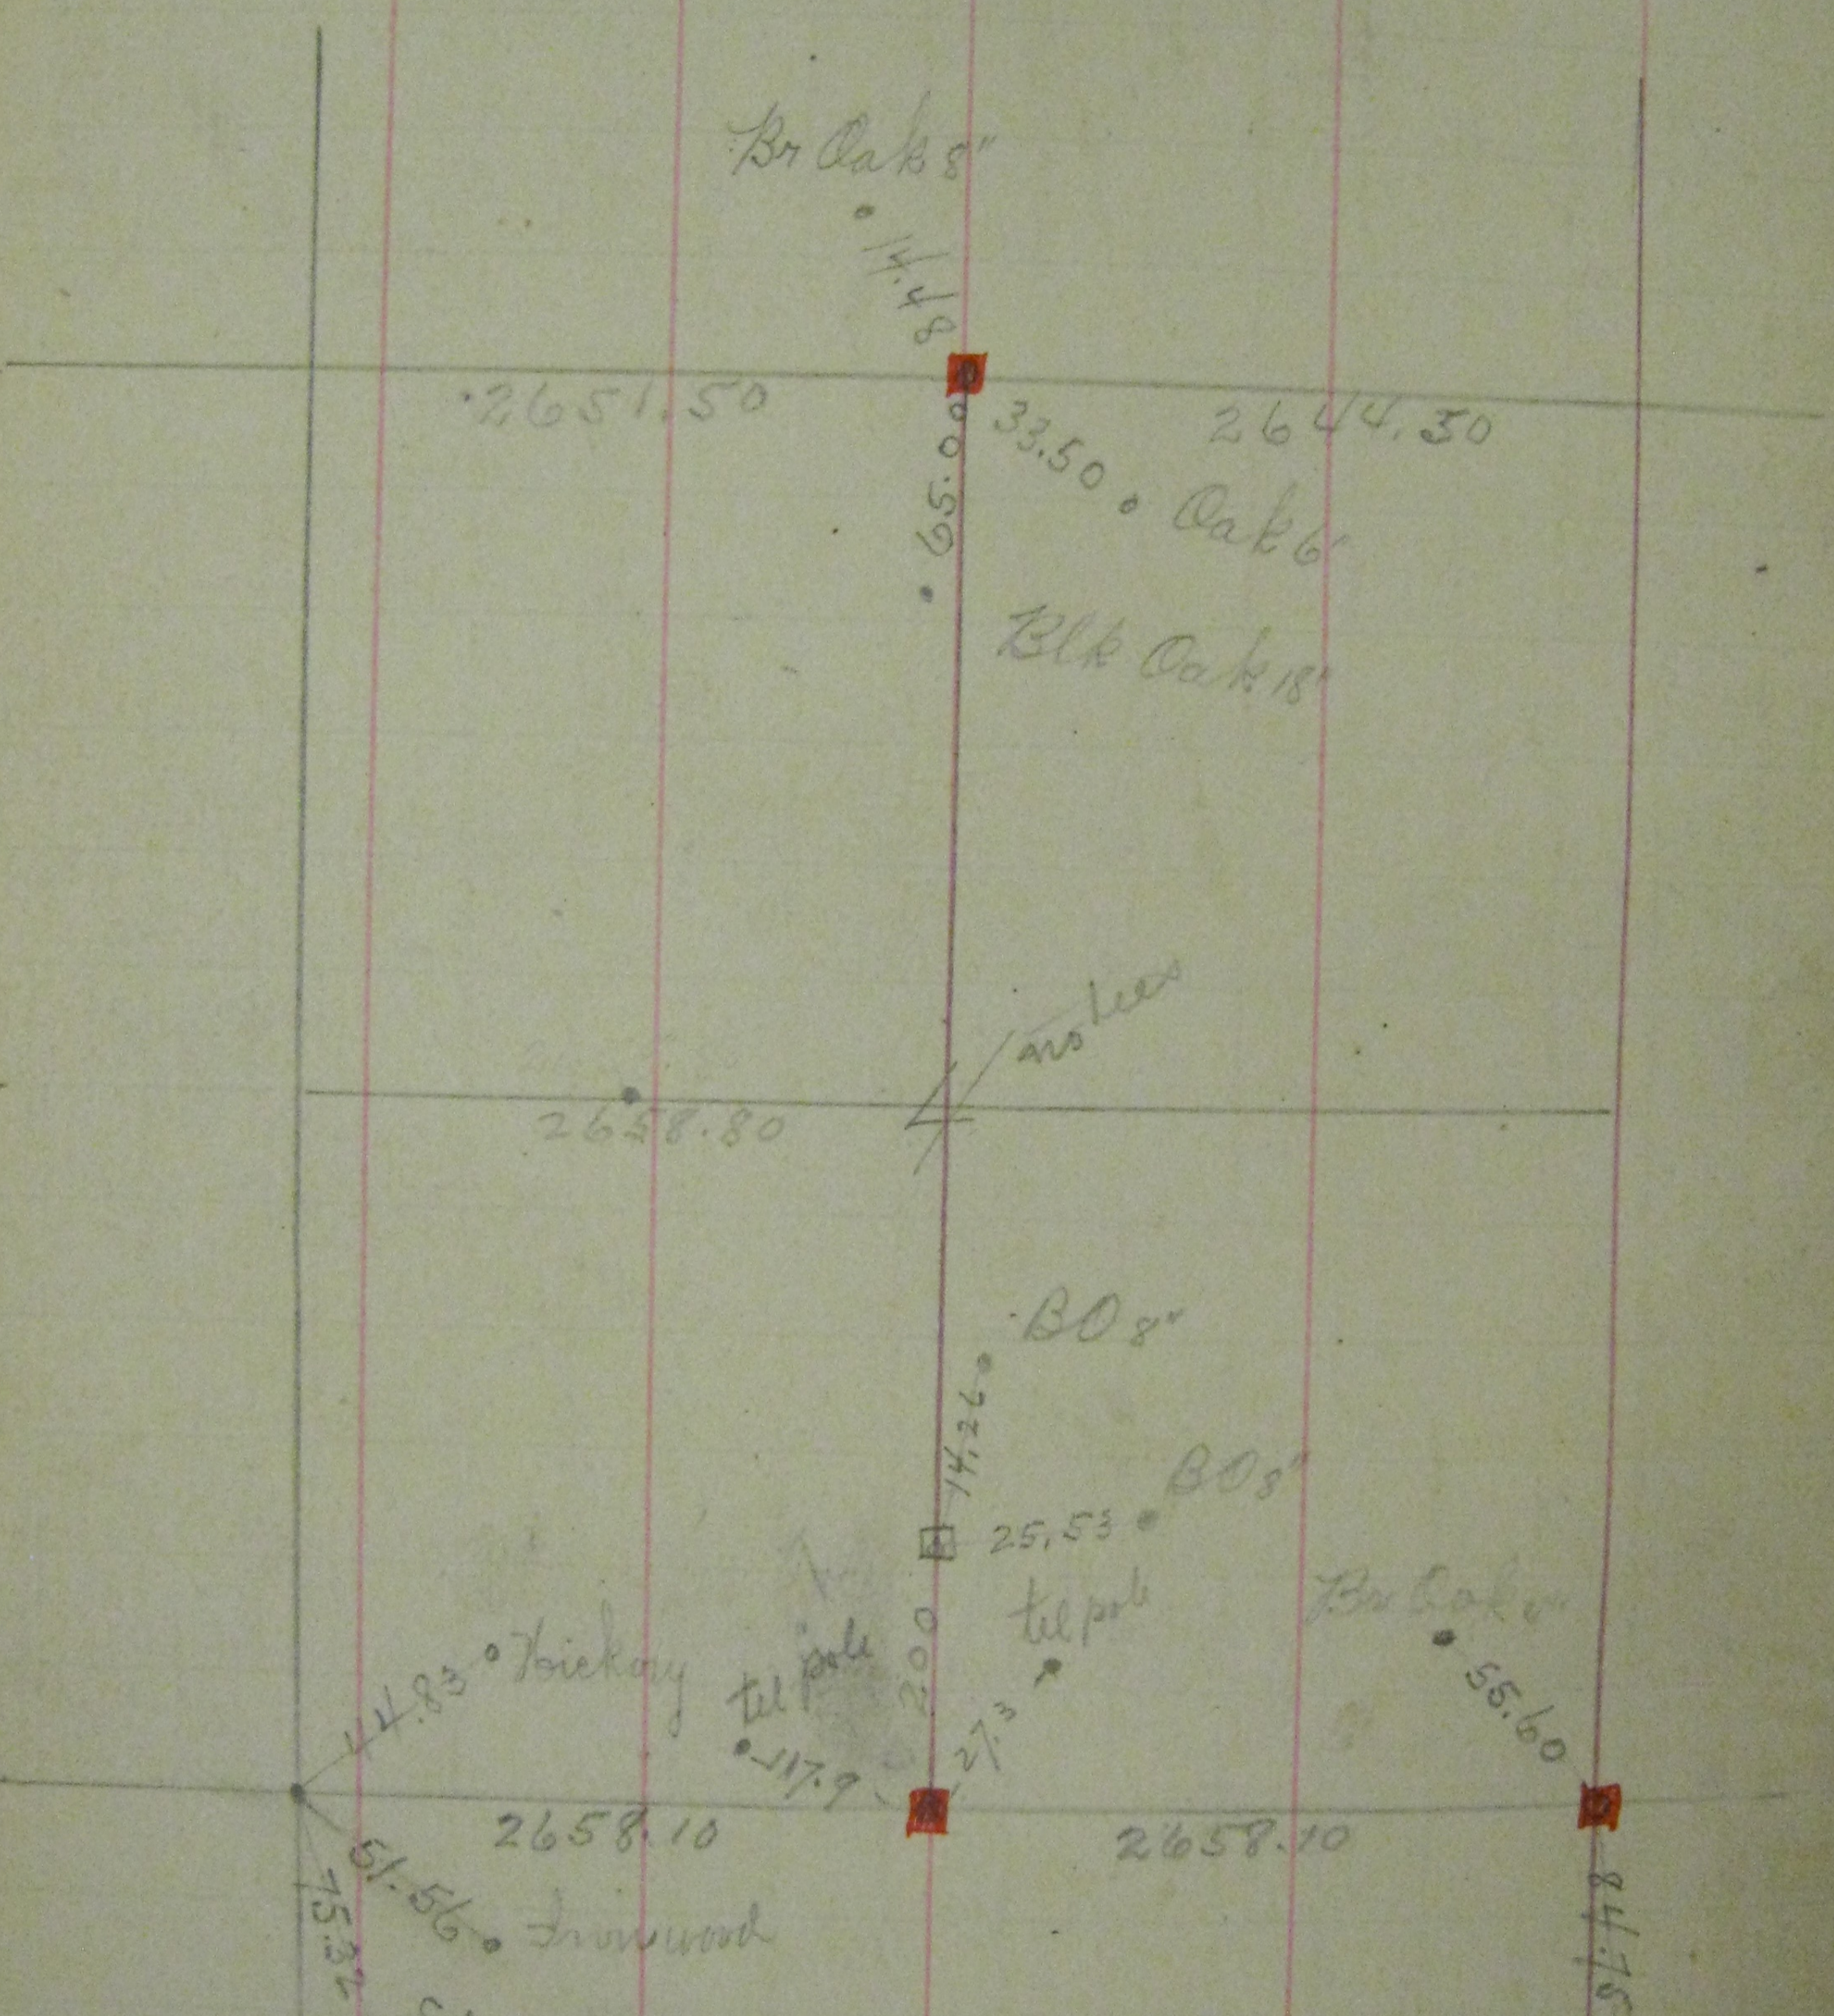

Aug 4 98 found two old ties at S.E. cor B. Oak
 found Old Boulder Mont at 1/4 cor on E

Jan 13 99 Sec 4 cor 4-5-8-9 found stump
 1/4 cor on N of Sec 4 found old tie