


Dec 10

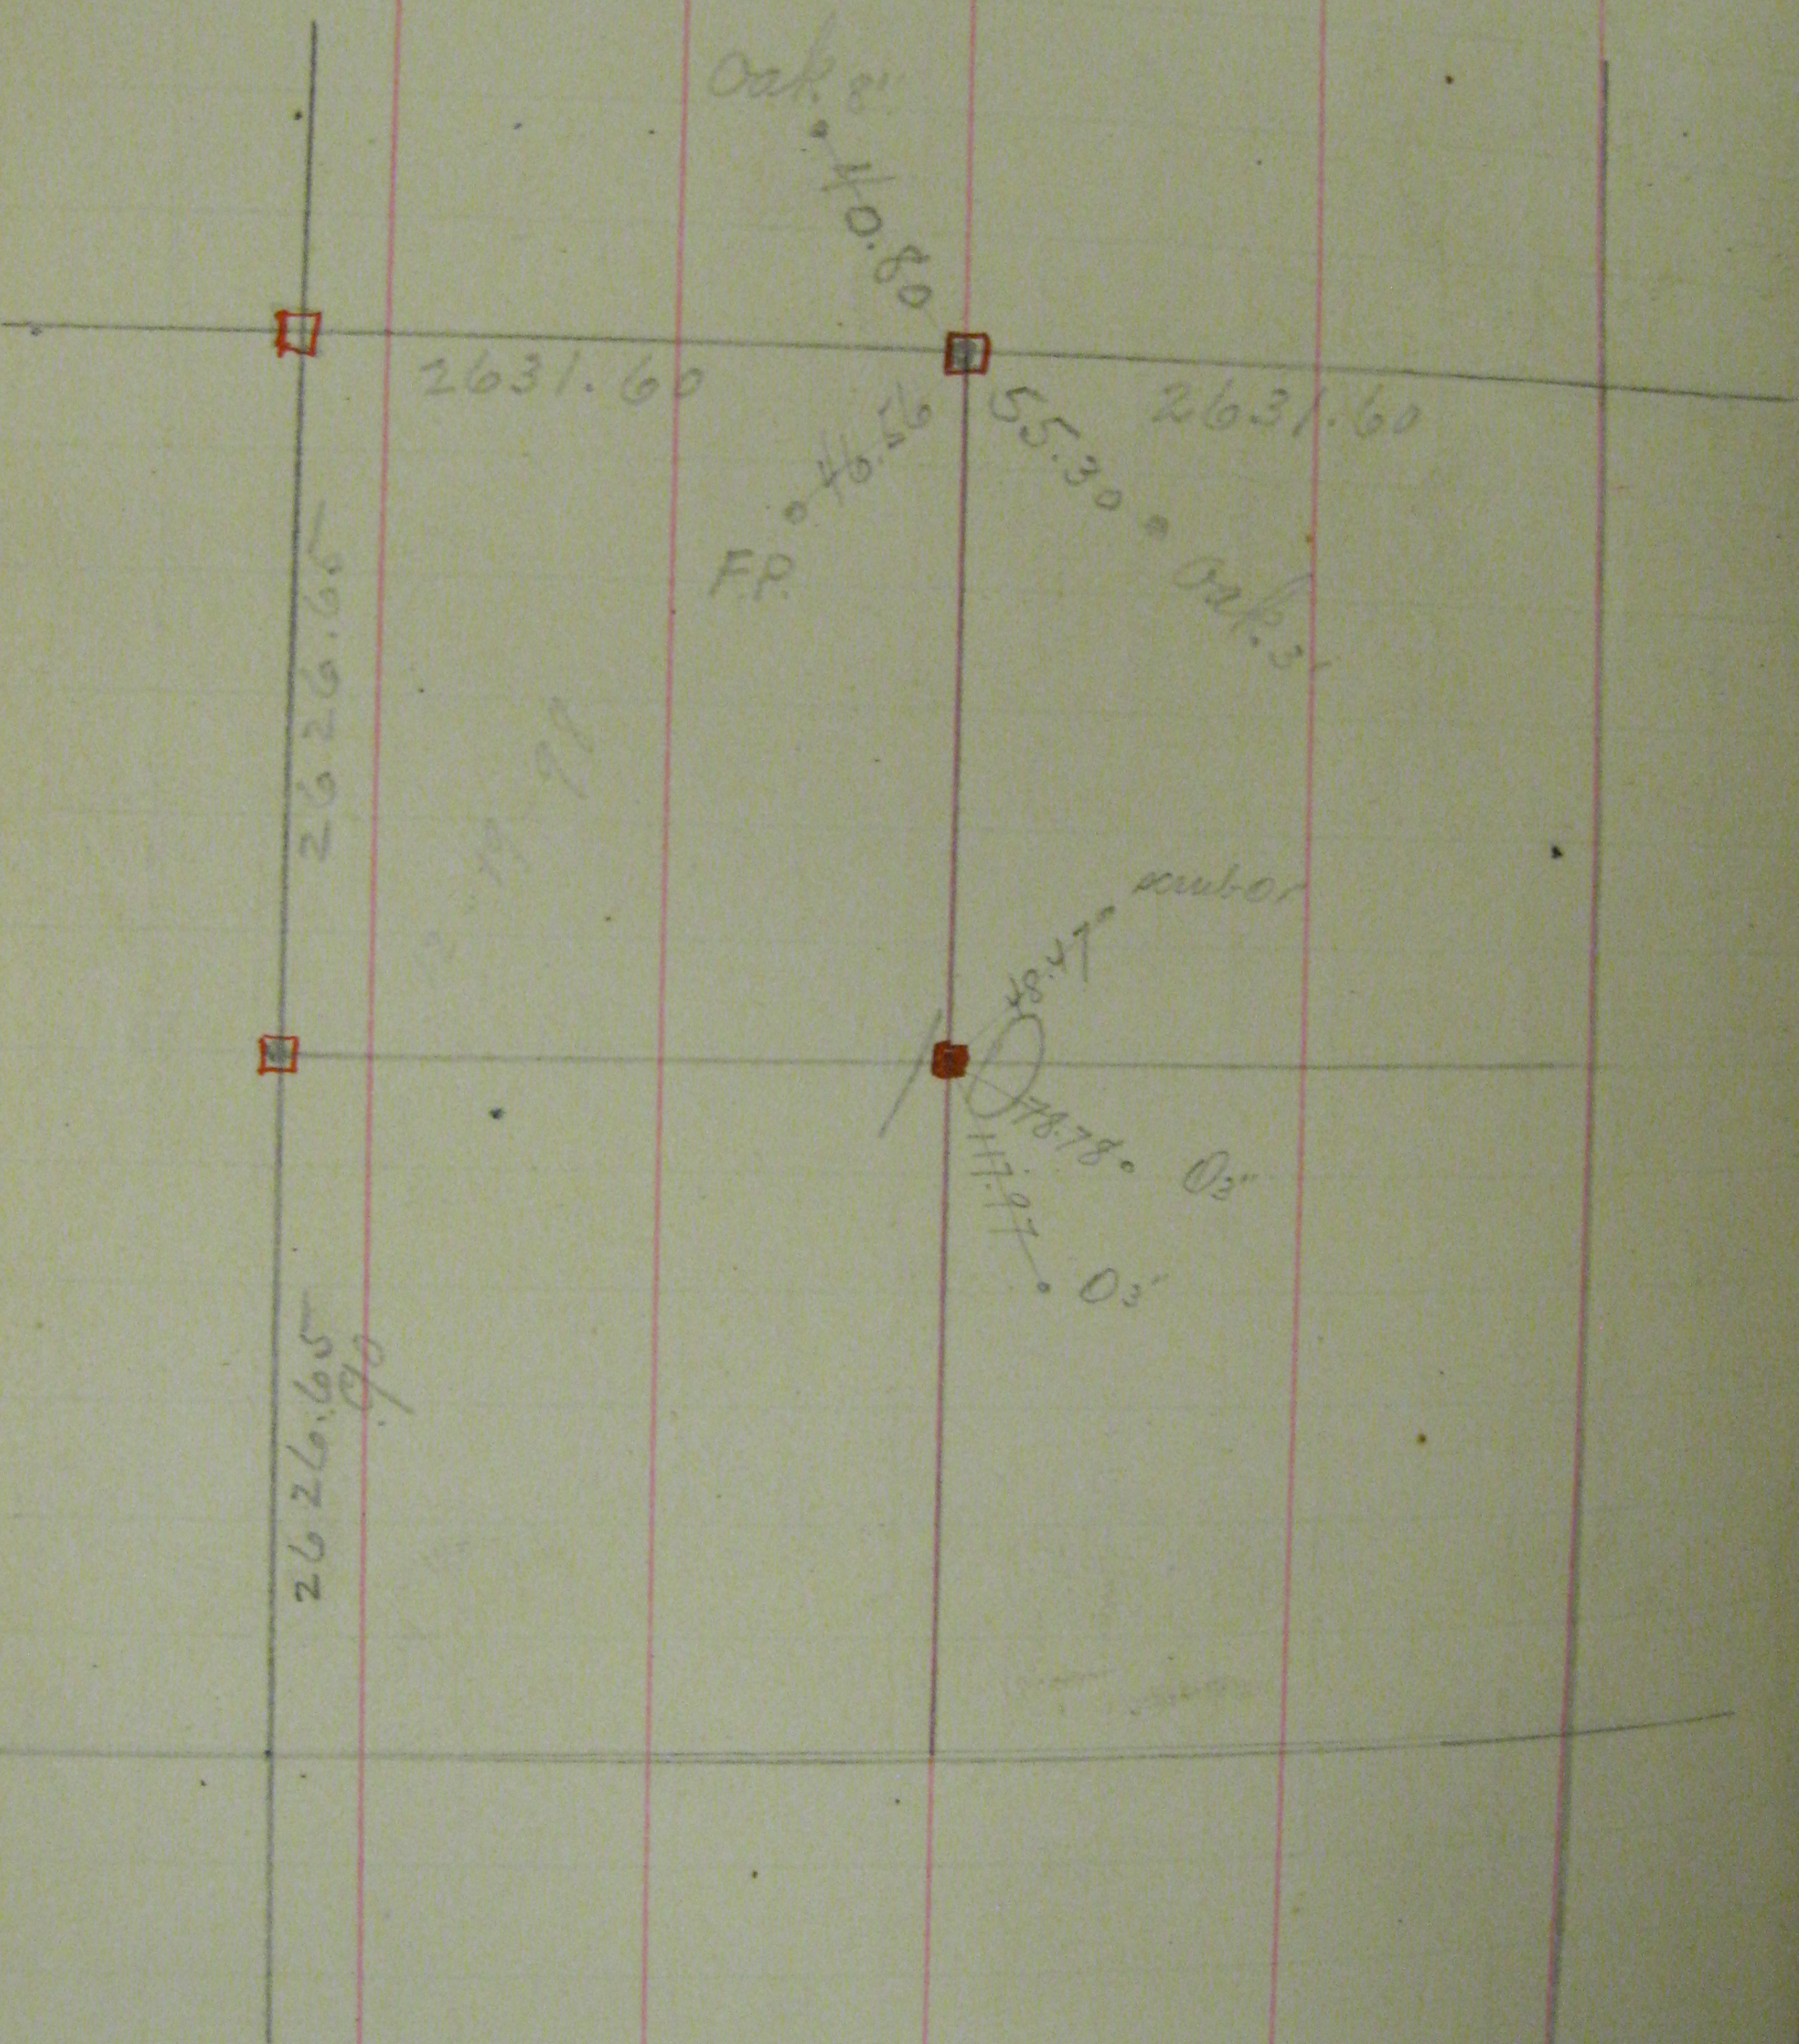

Oak 8'

40.80

2631.60

2631.60

55.30

FP

Oak 3'

2626.60

26.19 79

sub-or

48.47

78.78 03'

77.97 03'

2626.65  
90