




N

Dec 14-98 1/4 cor bet Sec 16 & 17 found old ties
Dec 12-98 1/4 cor bet Sec 17 & 18 found old ties


Centre sec 17

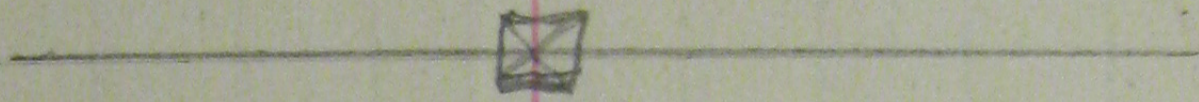

1313.4

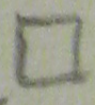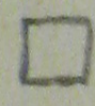

Base of stone gate post

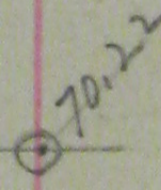

F.P. 32.68

15+43 to R.R.

1313.4

17



20

