
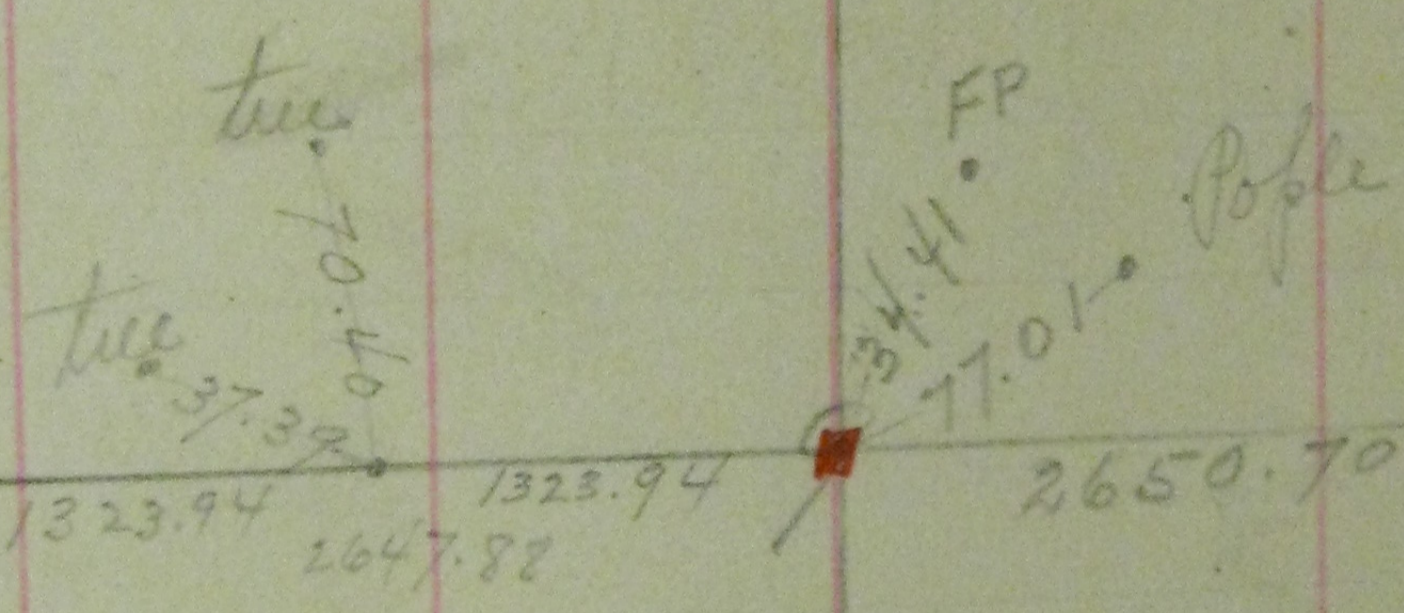


Sec 9

Tel pole

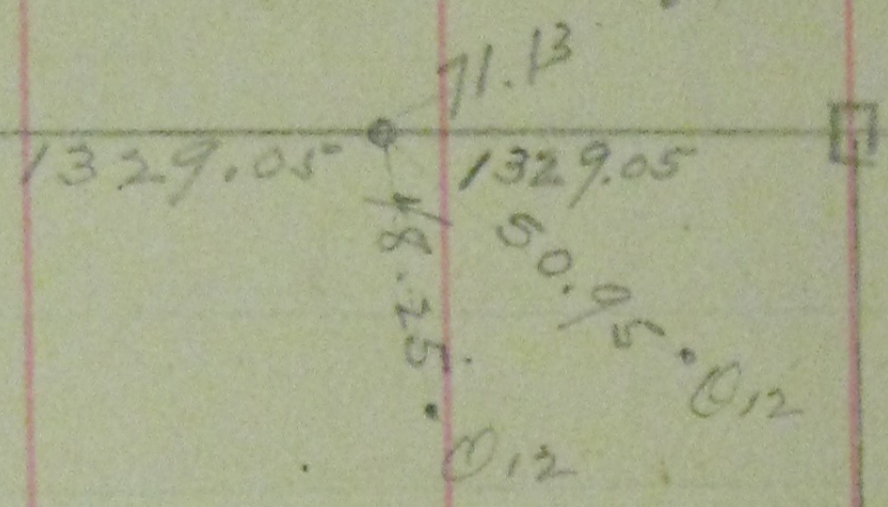

2628.06