


Centre of Sec 7 T29R22

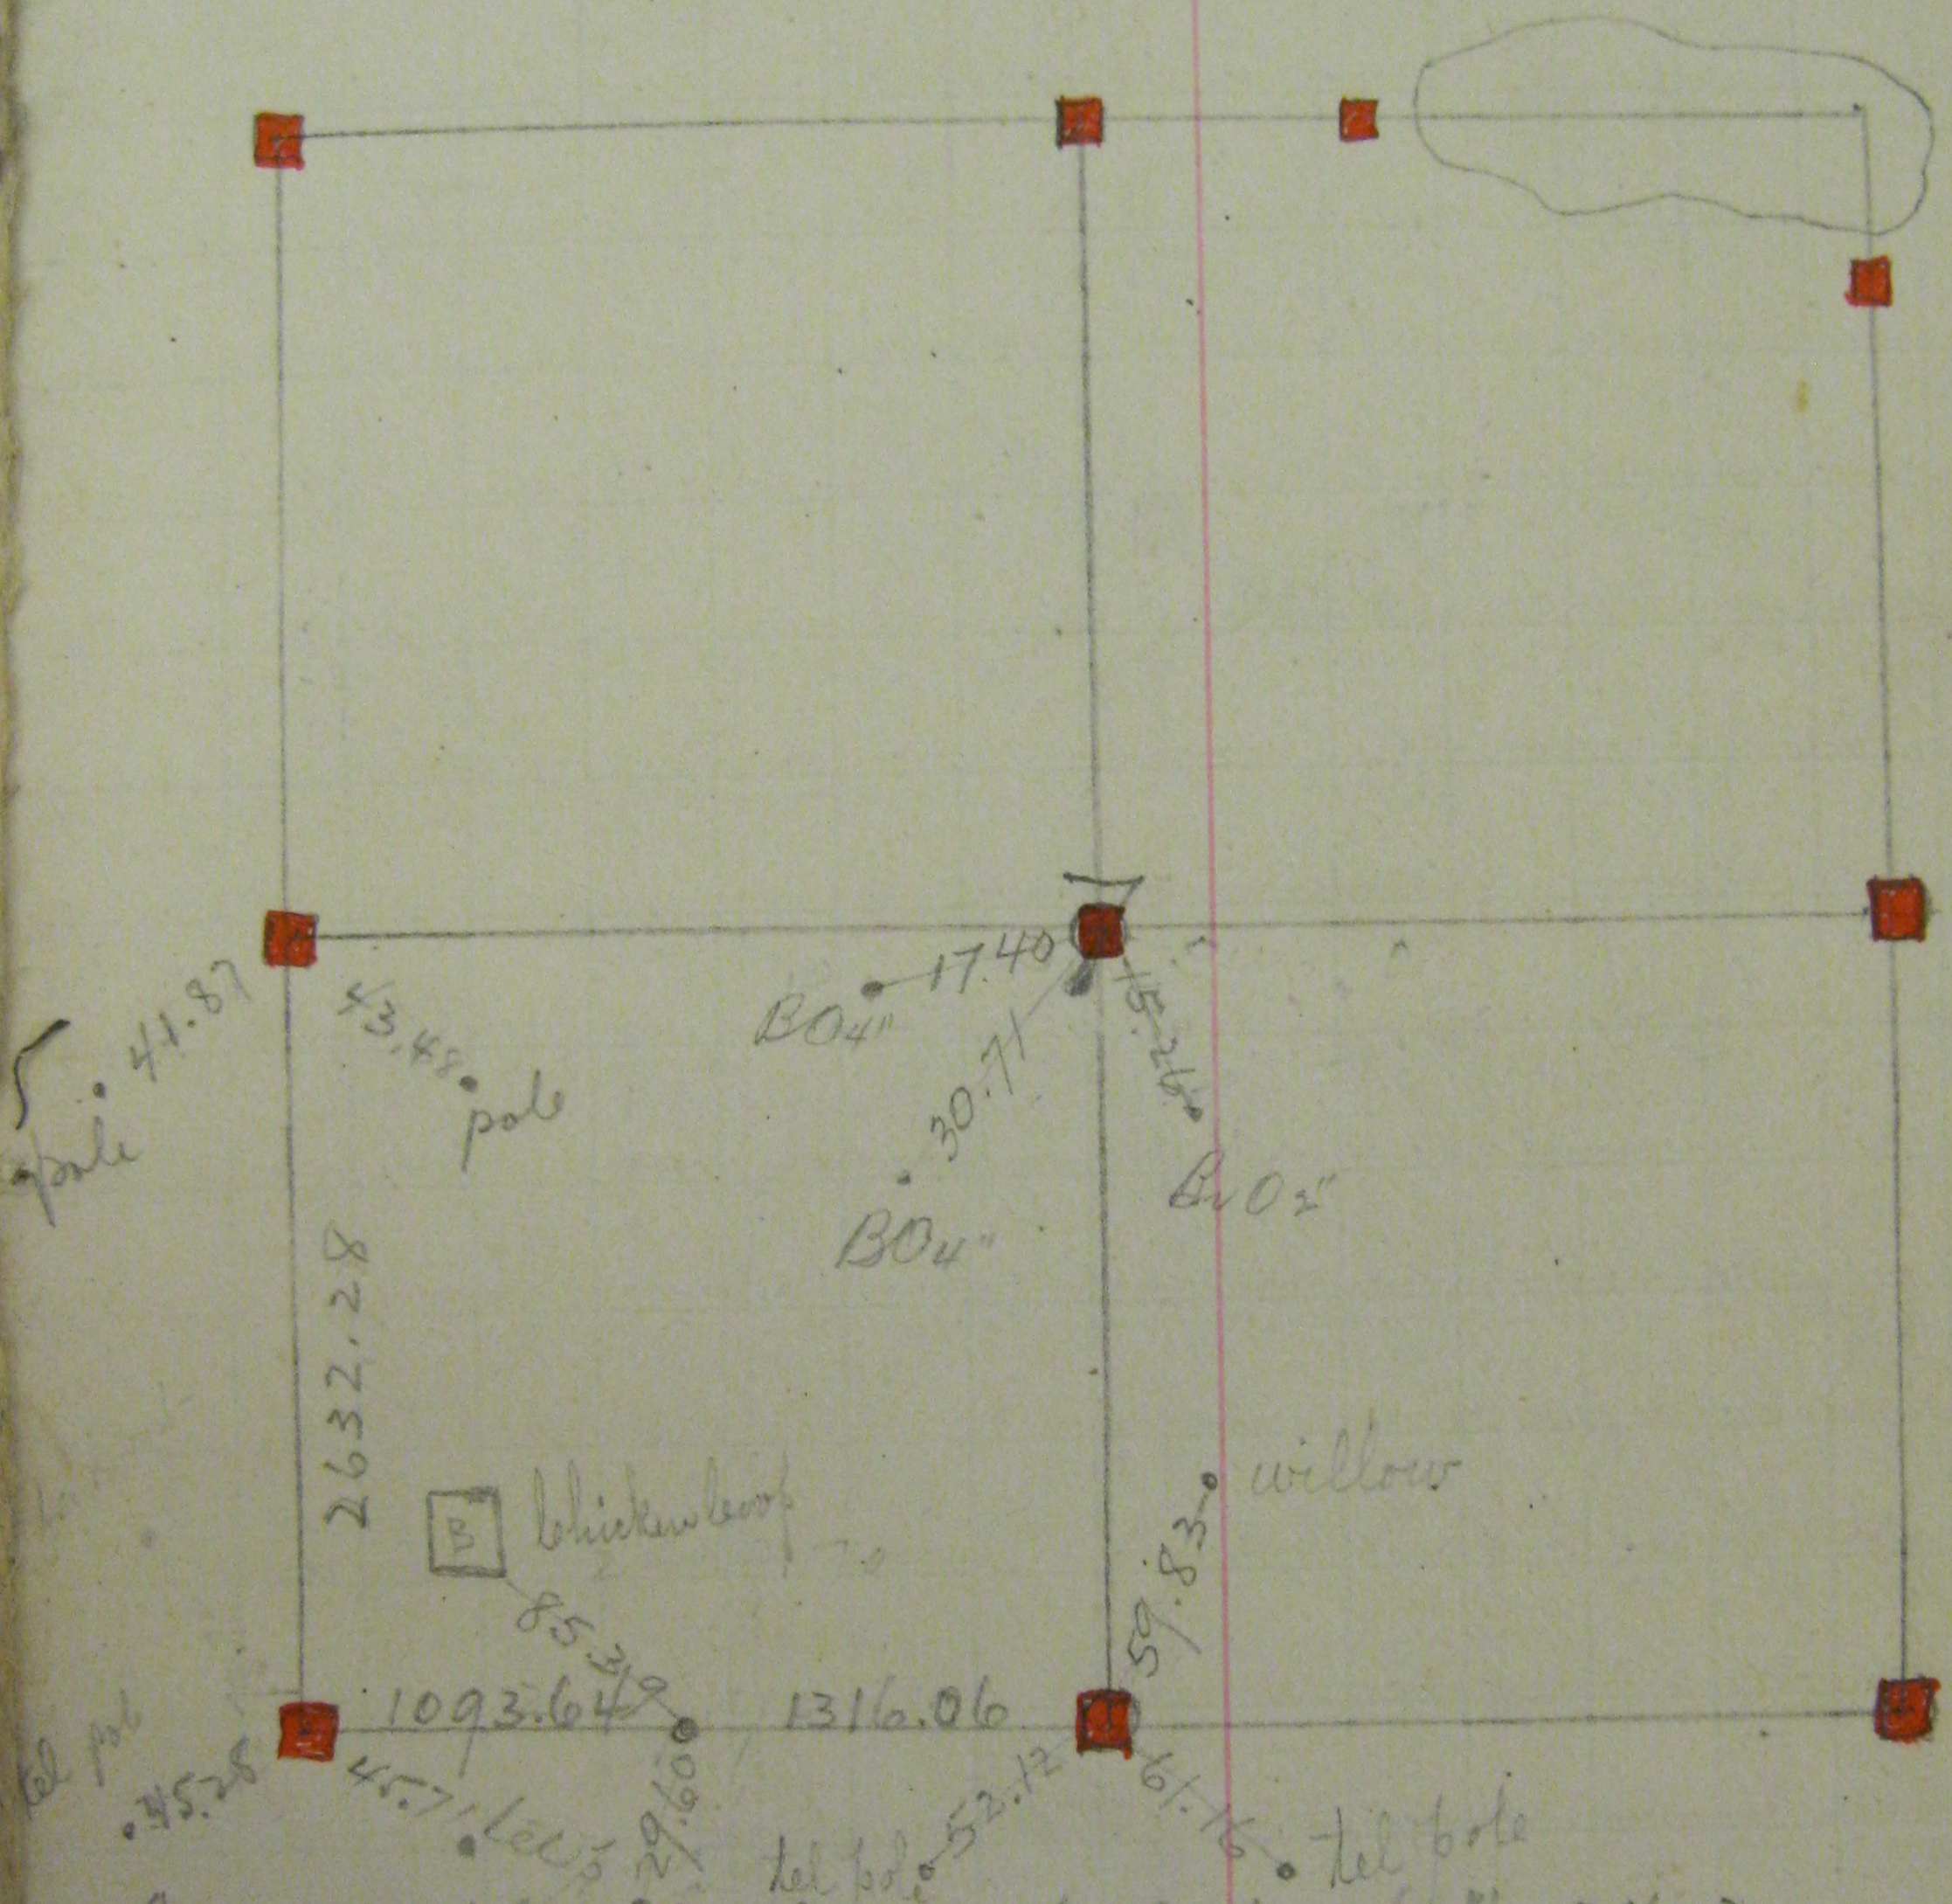

A = 3 Nails in Base of Blk 0 (4") 54.13

B = 3 " " " " " Lumb 0 (13") 36.63

○ = Iron stake at N.W. cor Blk 8 }
 Lawsons Suburban acre lots } 43.13