9

1/4 Cor Between Sec 7 and 8 T29 R22

Oct 13th 1885

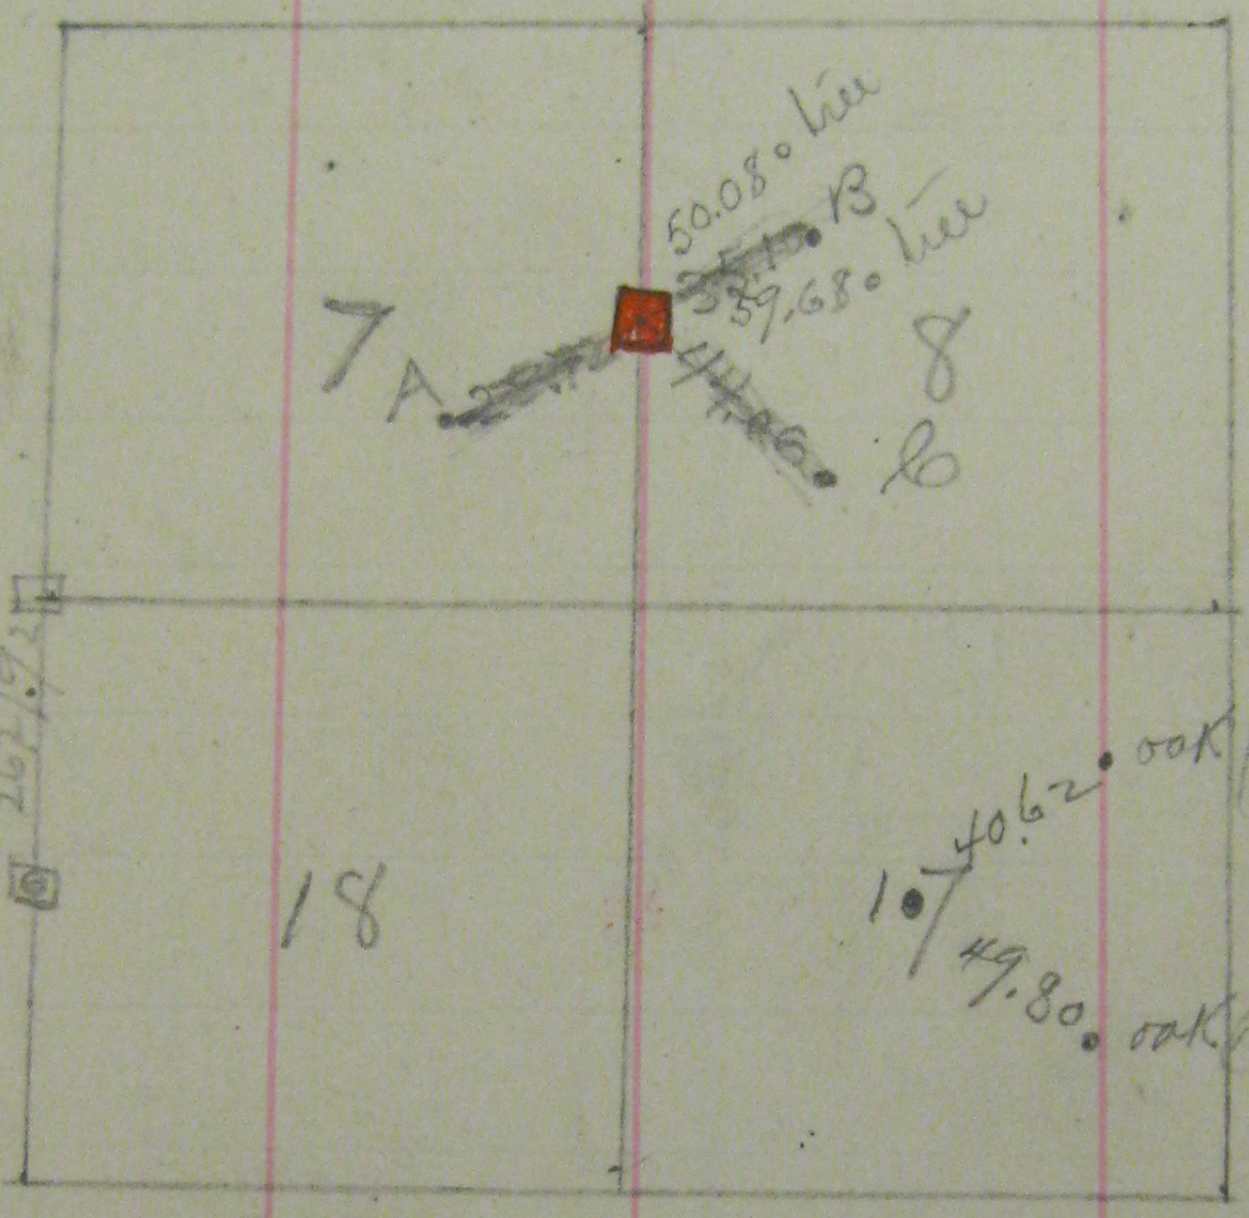

A = 3 Nails in Base of Tamarack (16") S 47° 30' W 25.72

B = 3 " " " Burr Oak (6") N 60° 30' E 35.10

lo = 3 " " " Tamarack (12") S 21° 35' E 44.06

The Center of Sec 17 fixed and Tied by N. L. Eurdice May 13 — 1891

Oct 13th 1885