


11

1/4 cor between sec 10<sup>nd</sup> & 3 found both witness stumps fixed new ties Oct 14<sup>th</sup> 1896 also found old stake at corner fixed by shepherd

Sec 10

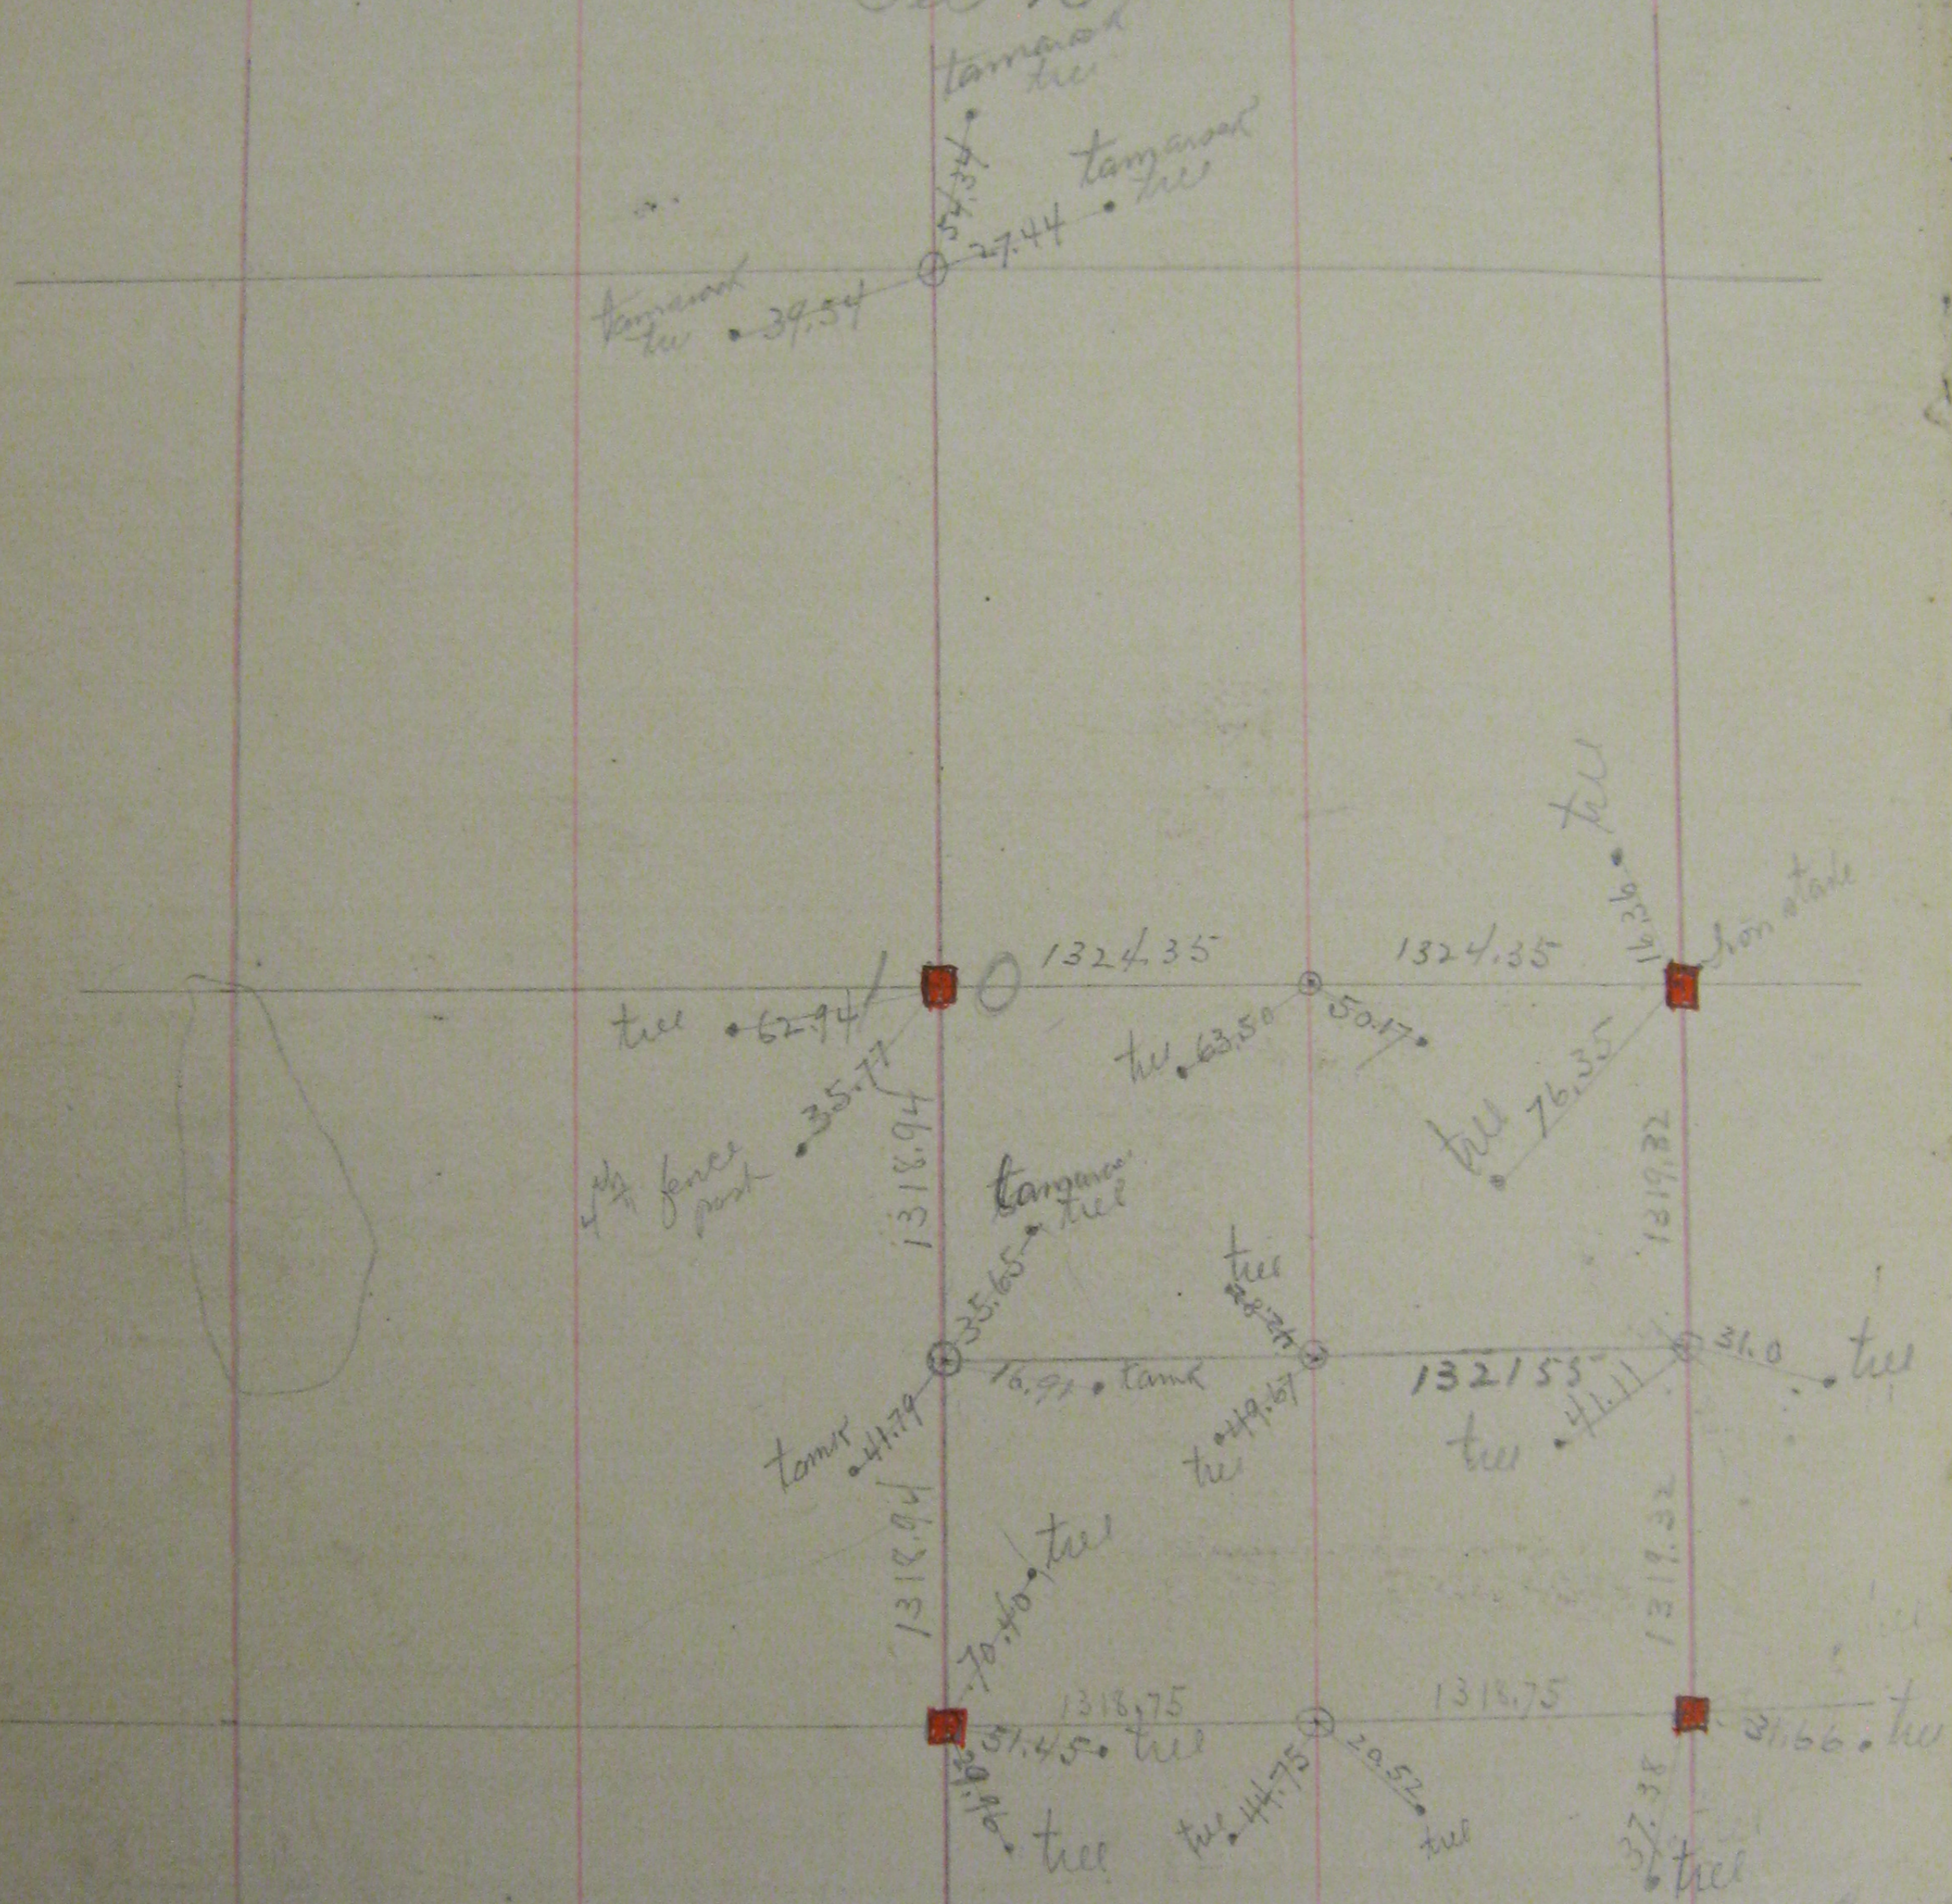

1/4 cor between 10 & 11 = Old stake one knot tree standing Apr 29<sup>th</sup> 1896

1/4 cor between 16<sup>th</sup> & 15 found Boulder Mint. 1 knot witness tree & one stump Oct 13<sup>th</sup> 1896 fixed new ties

at center of sec 10 found Shepherd's old center