


Sec 31

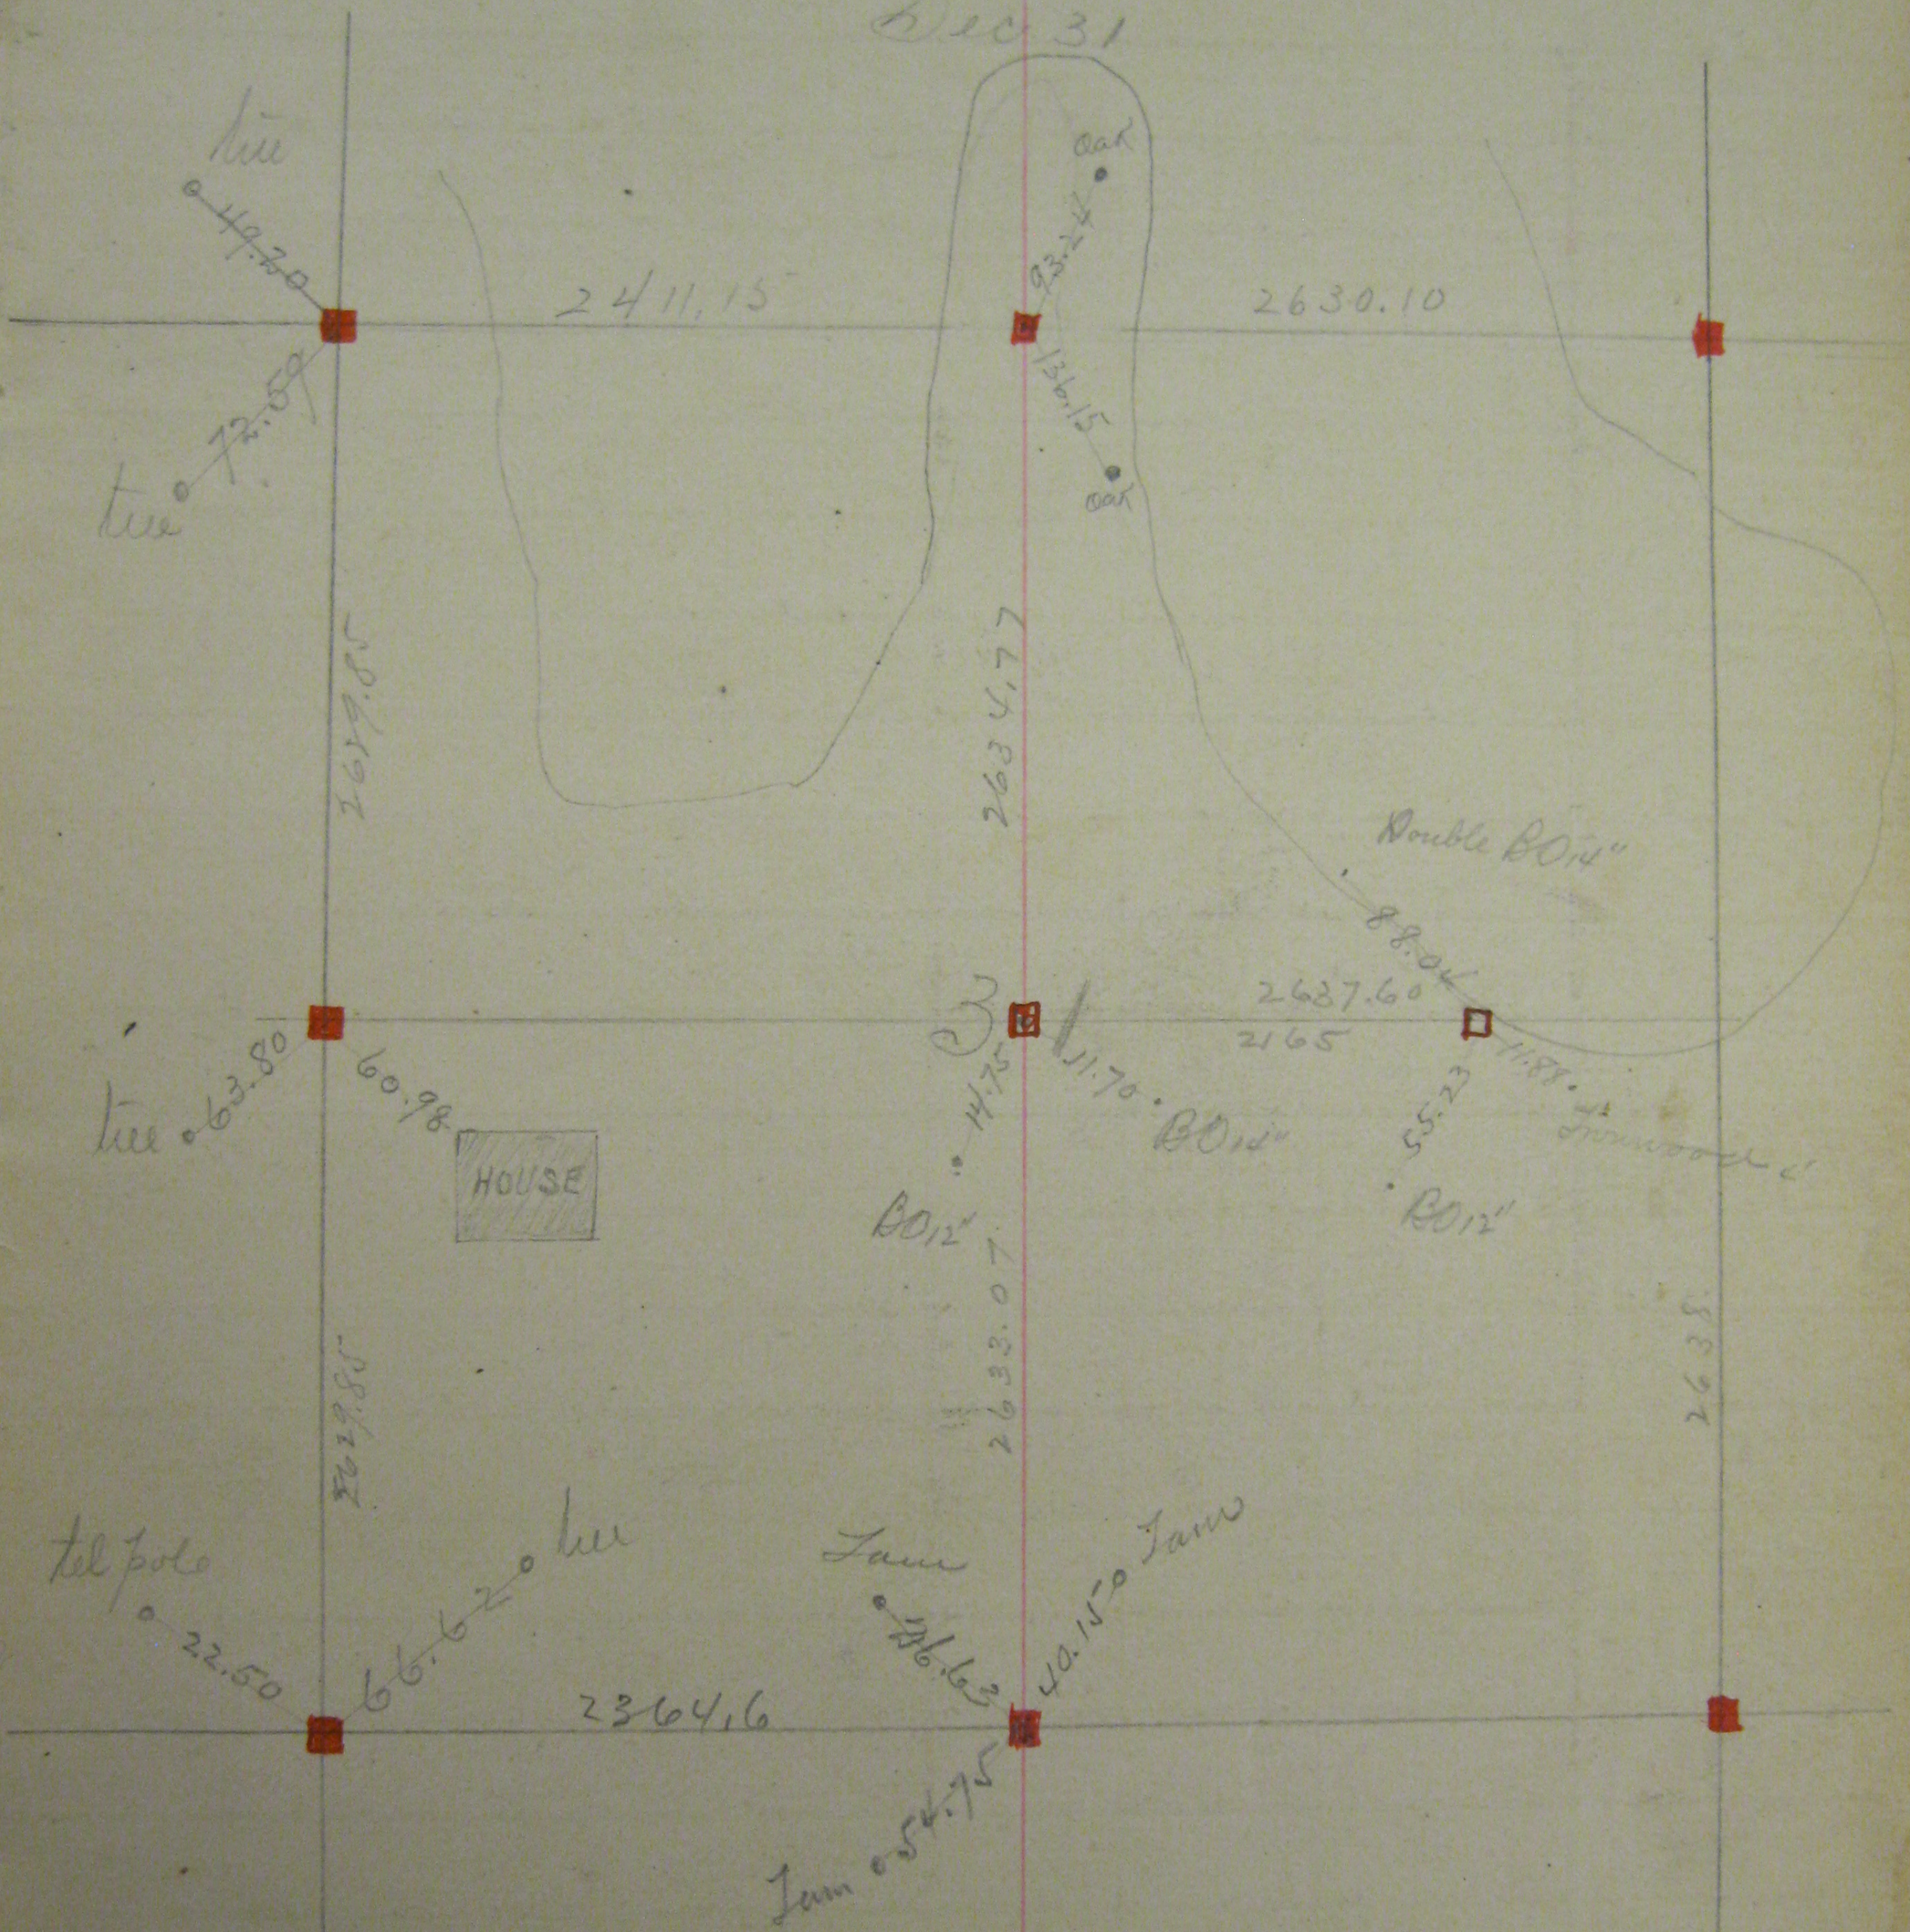

Ran North line of Section 31 Jan 1900. Ran transit line and per rated shortage