


21 Aug 28<sup>th</sup> 1896 Found Boulder Monument at 1/4 Cor between sections 26<sup>nd</sup> & 27

Same date found Lime stone Monument at 1/4 Cor between 26<sup>th</sup> & 25

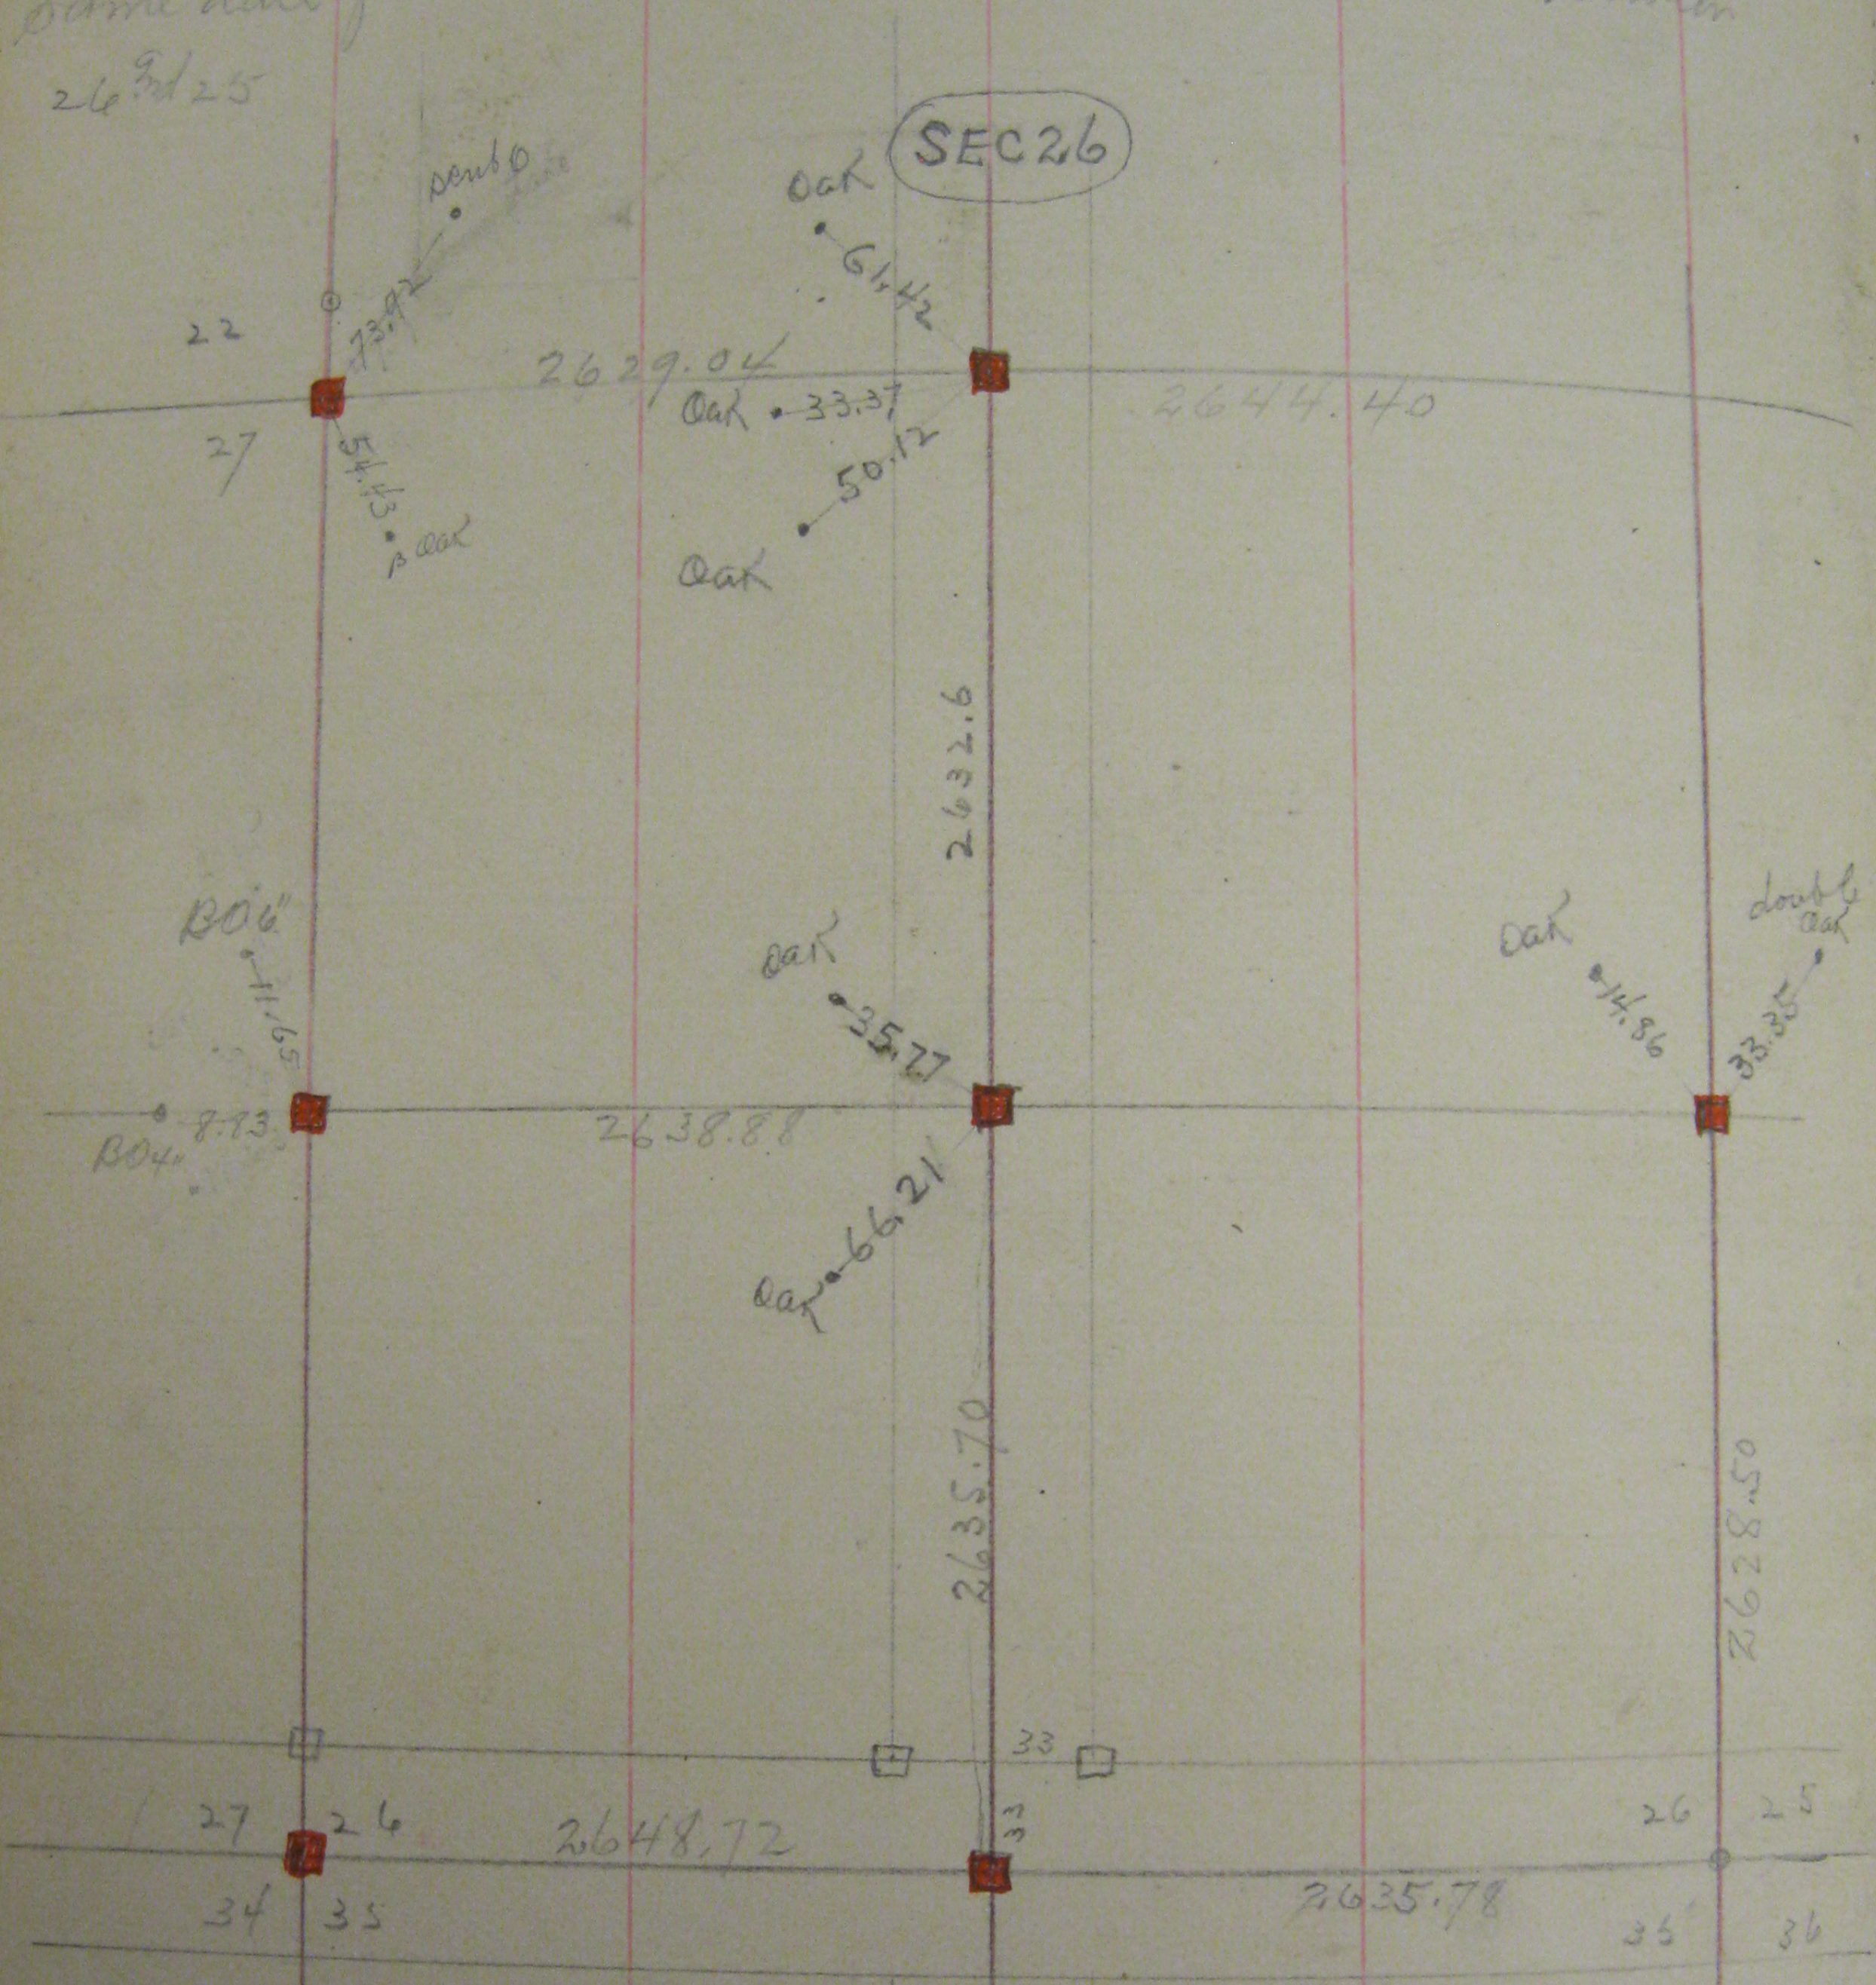

Aug 29<sup>th</sup> 1896 Found old original stake at 1/4 Cor between sec 26<sup>th</sup> & 23

Sept 29<sup>th</sup> 1896 Found old stake at sec cor 22-23-26-27