


Dec 23

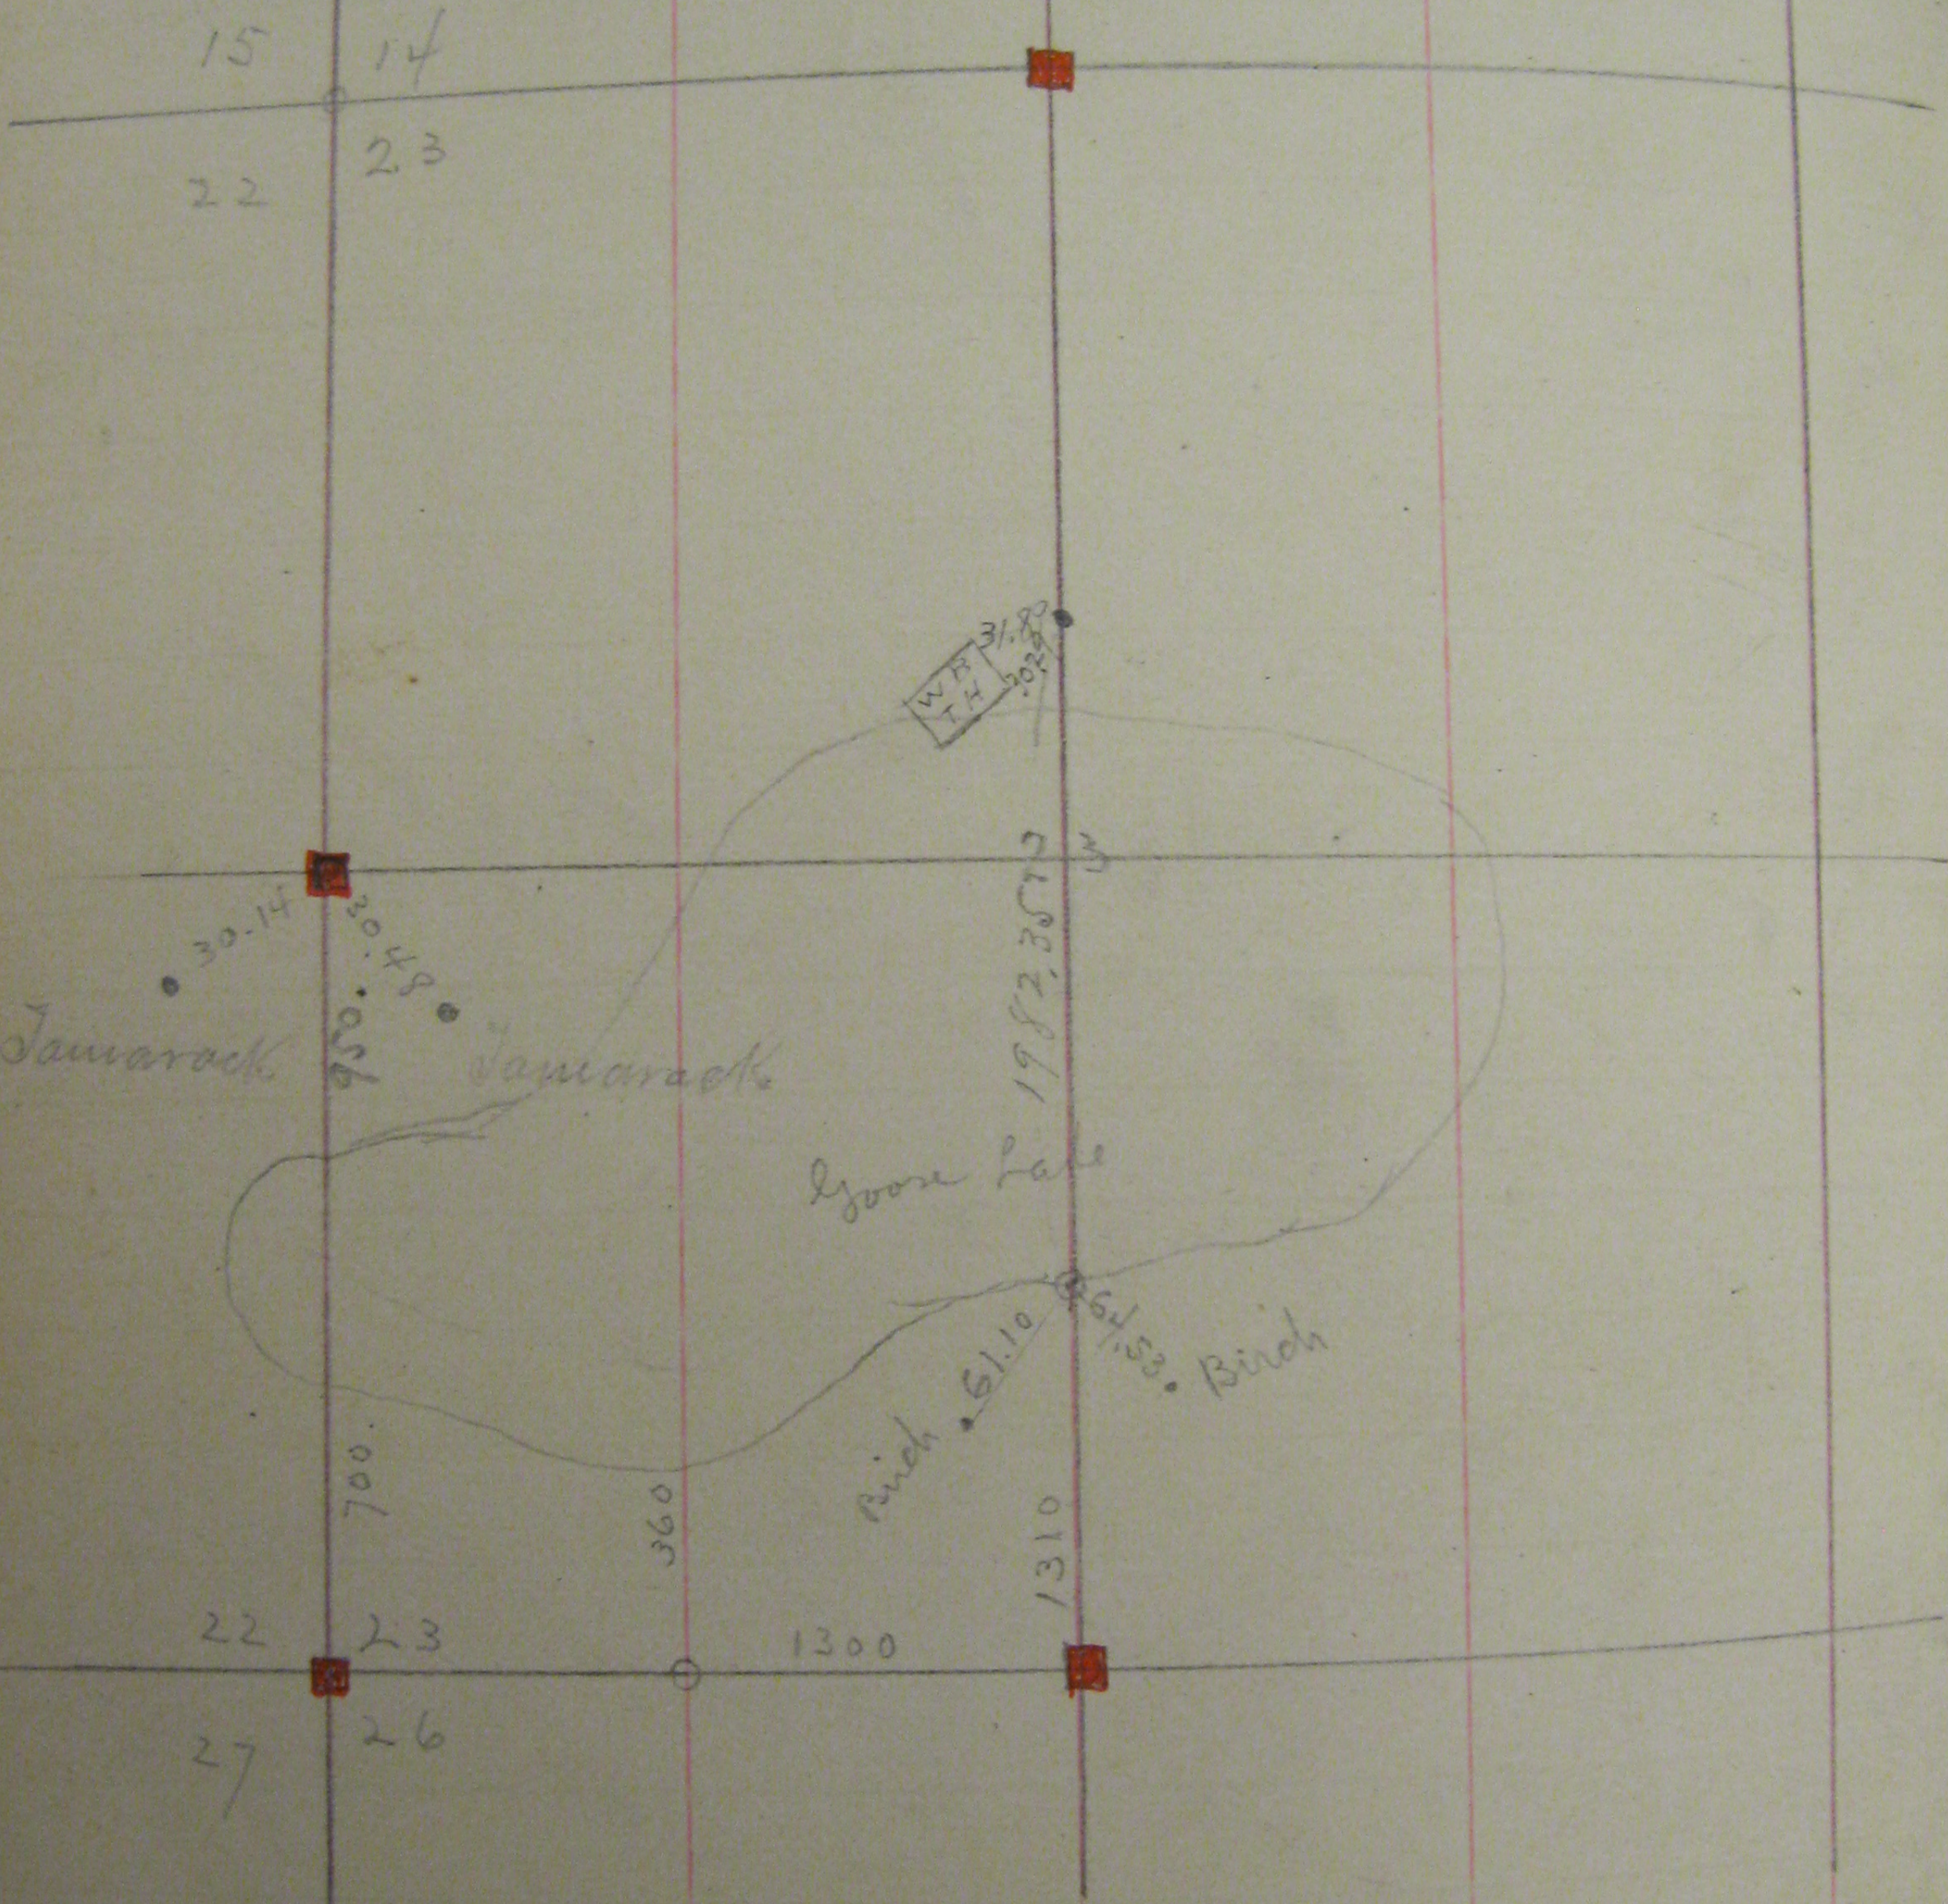

Oct 6-96 Found old Tamarack stalk at 94 loc  
 between sections 22 & 23 found 2 low stumps Dec 3-1900