


31

N 3/4 Sec 36 found Govt stump N.W. Sept-1897
S.E. cor sec 36 found Iron Mont Sept-1897
June 21/98 1/4 cor on N of 36 fixed from fence found stake

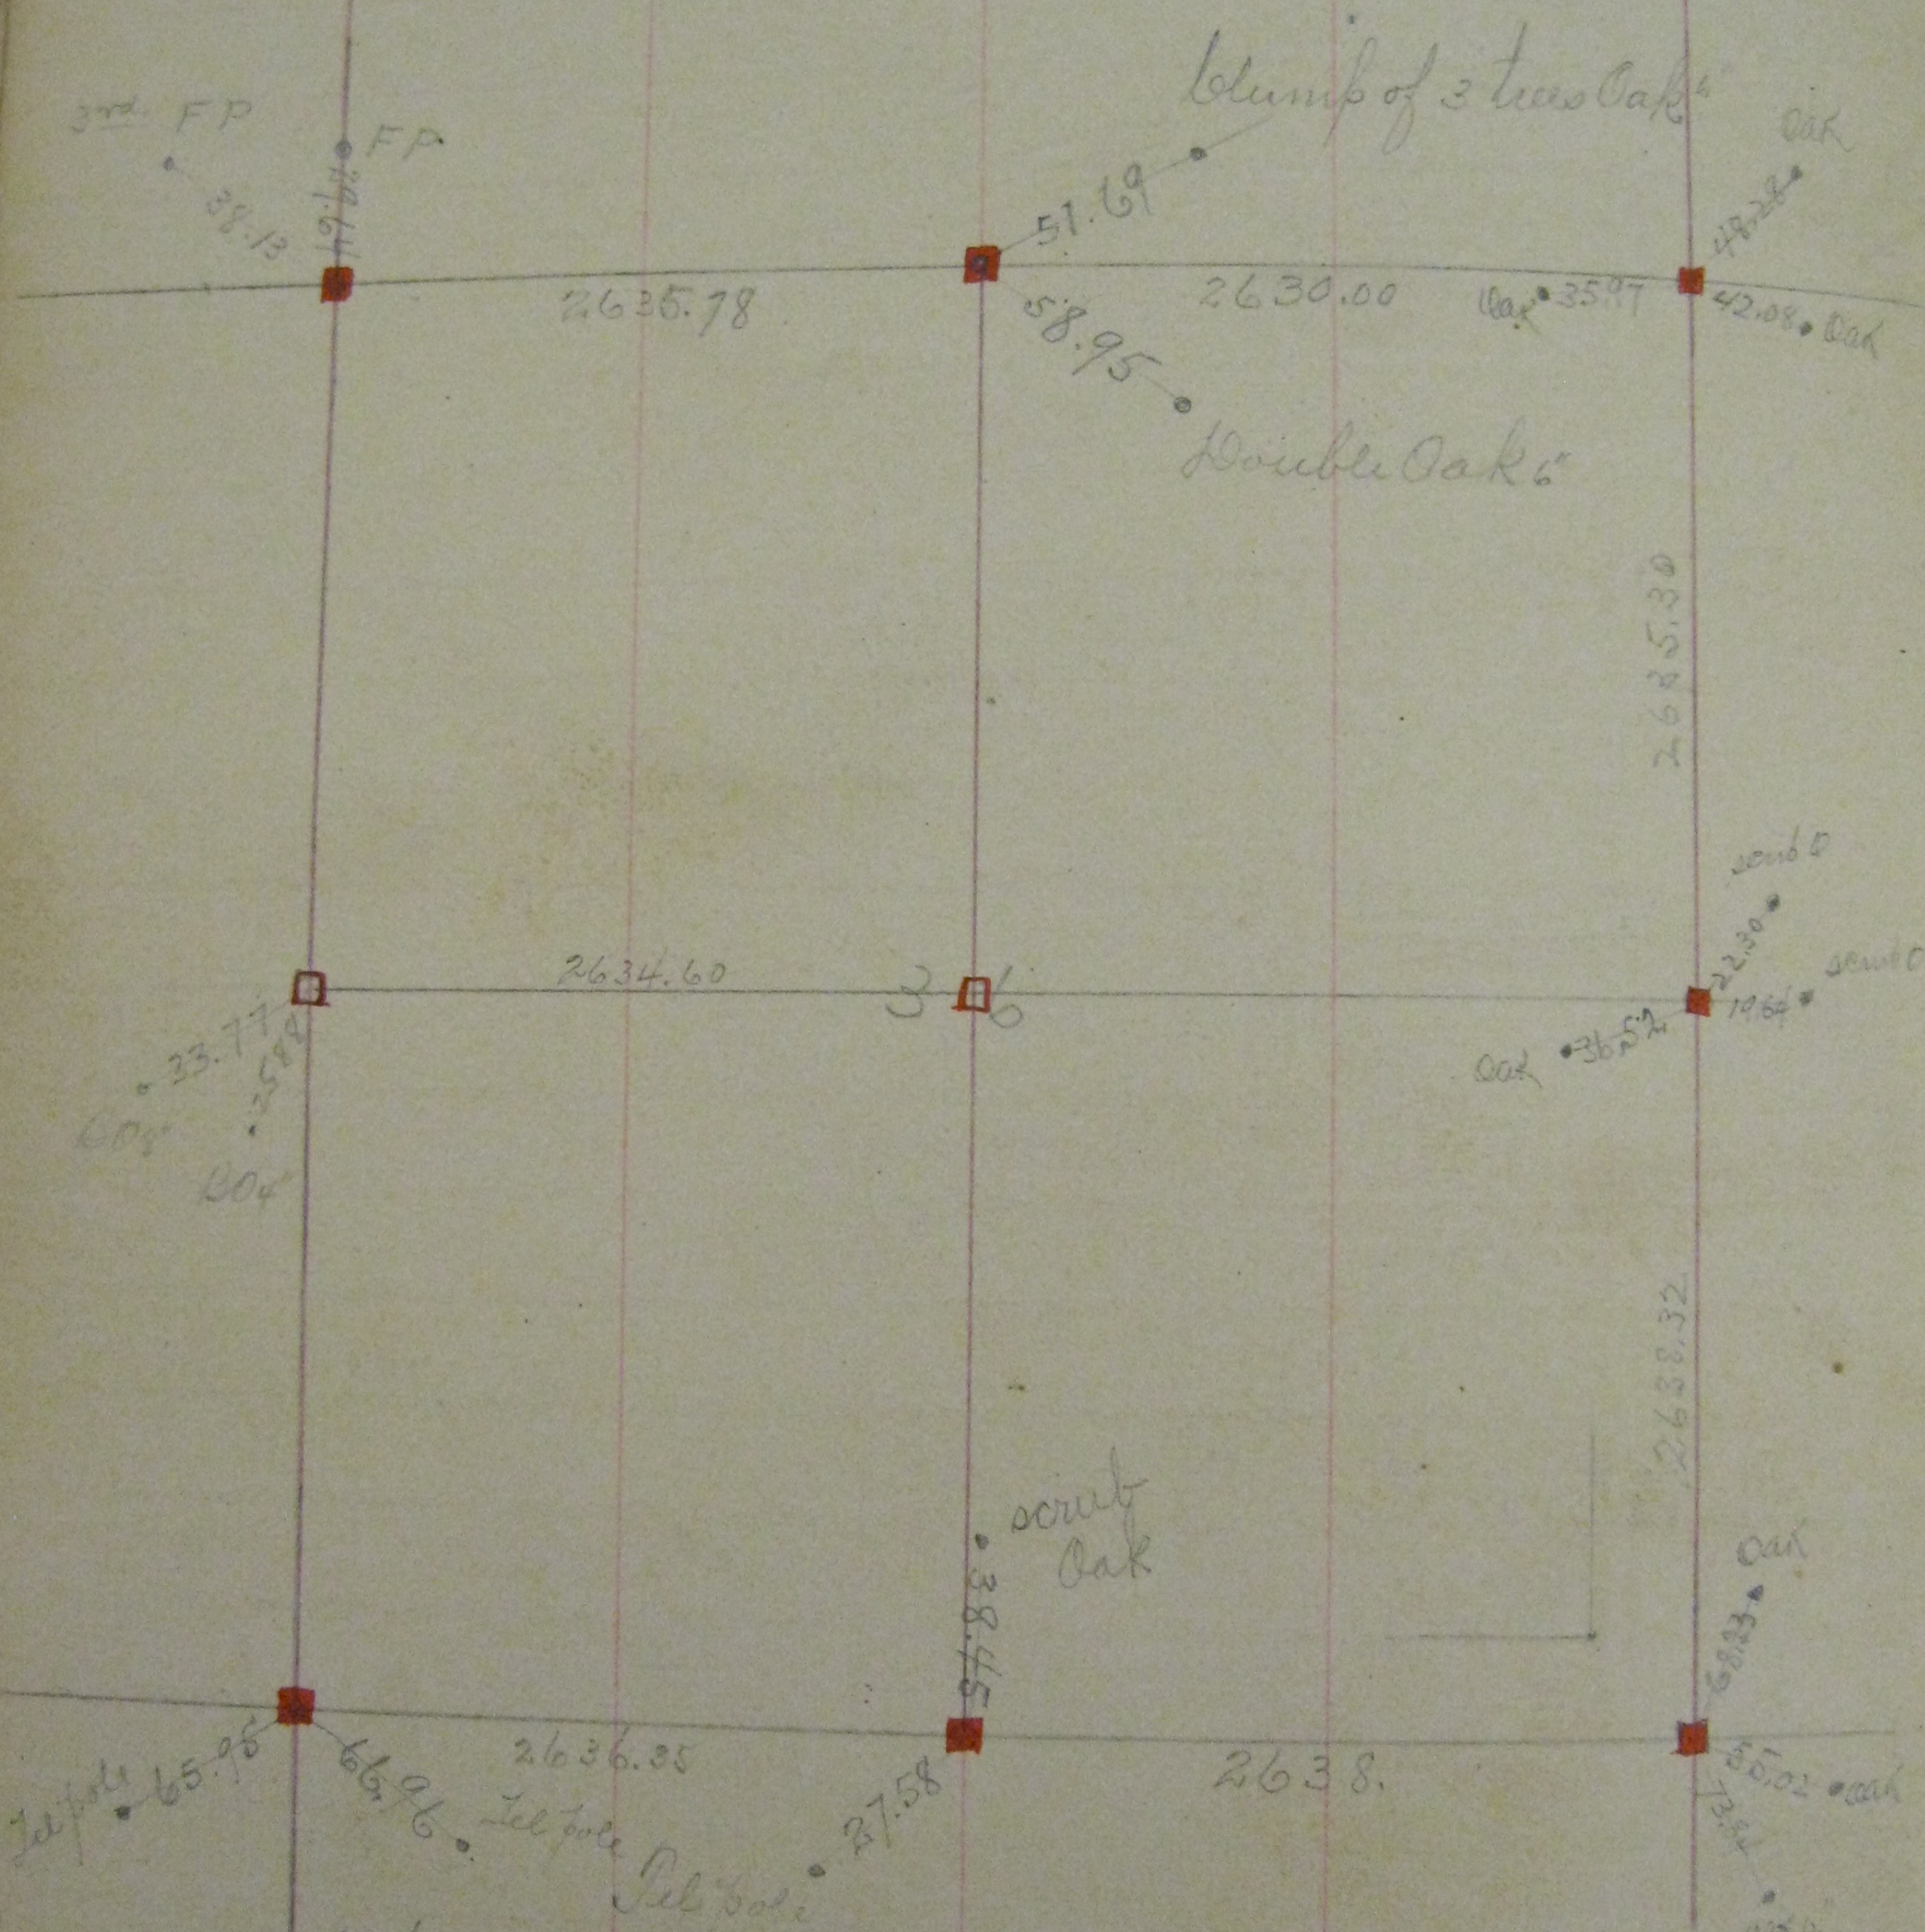

July 18/98 1/4 cor on S of Sec 36 found Gov stump