


o 1/2 ton bet Sec 18 & 19

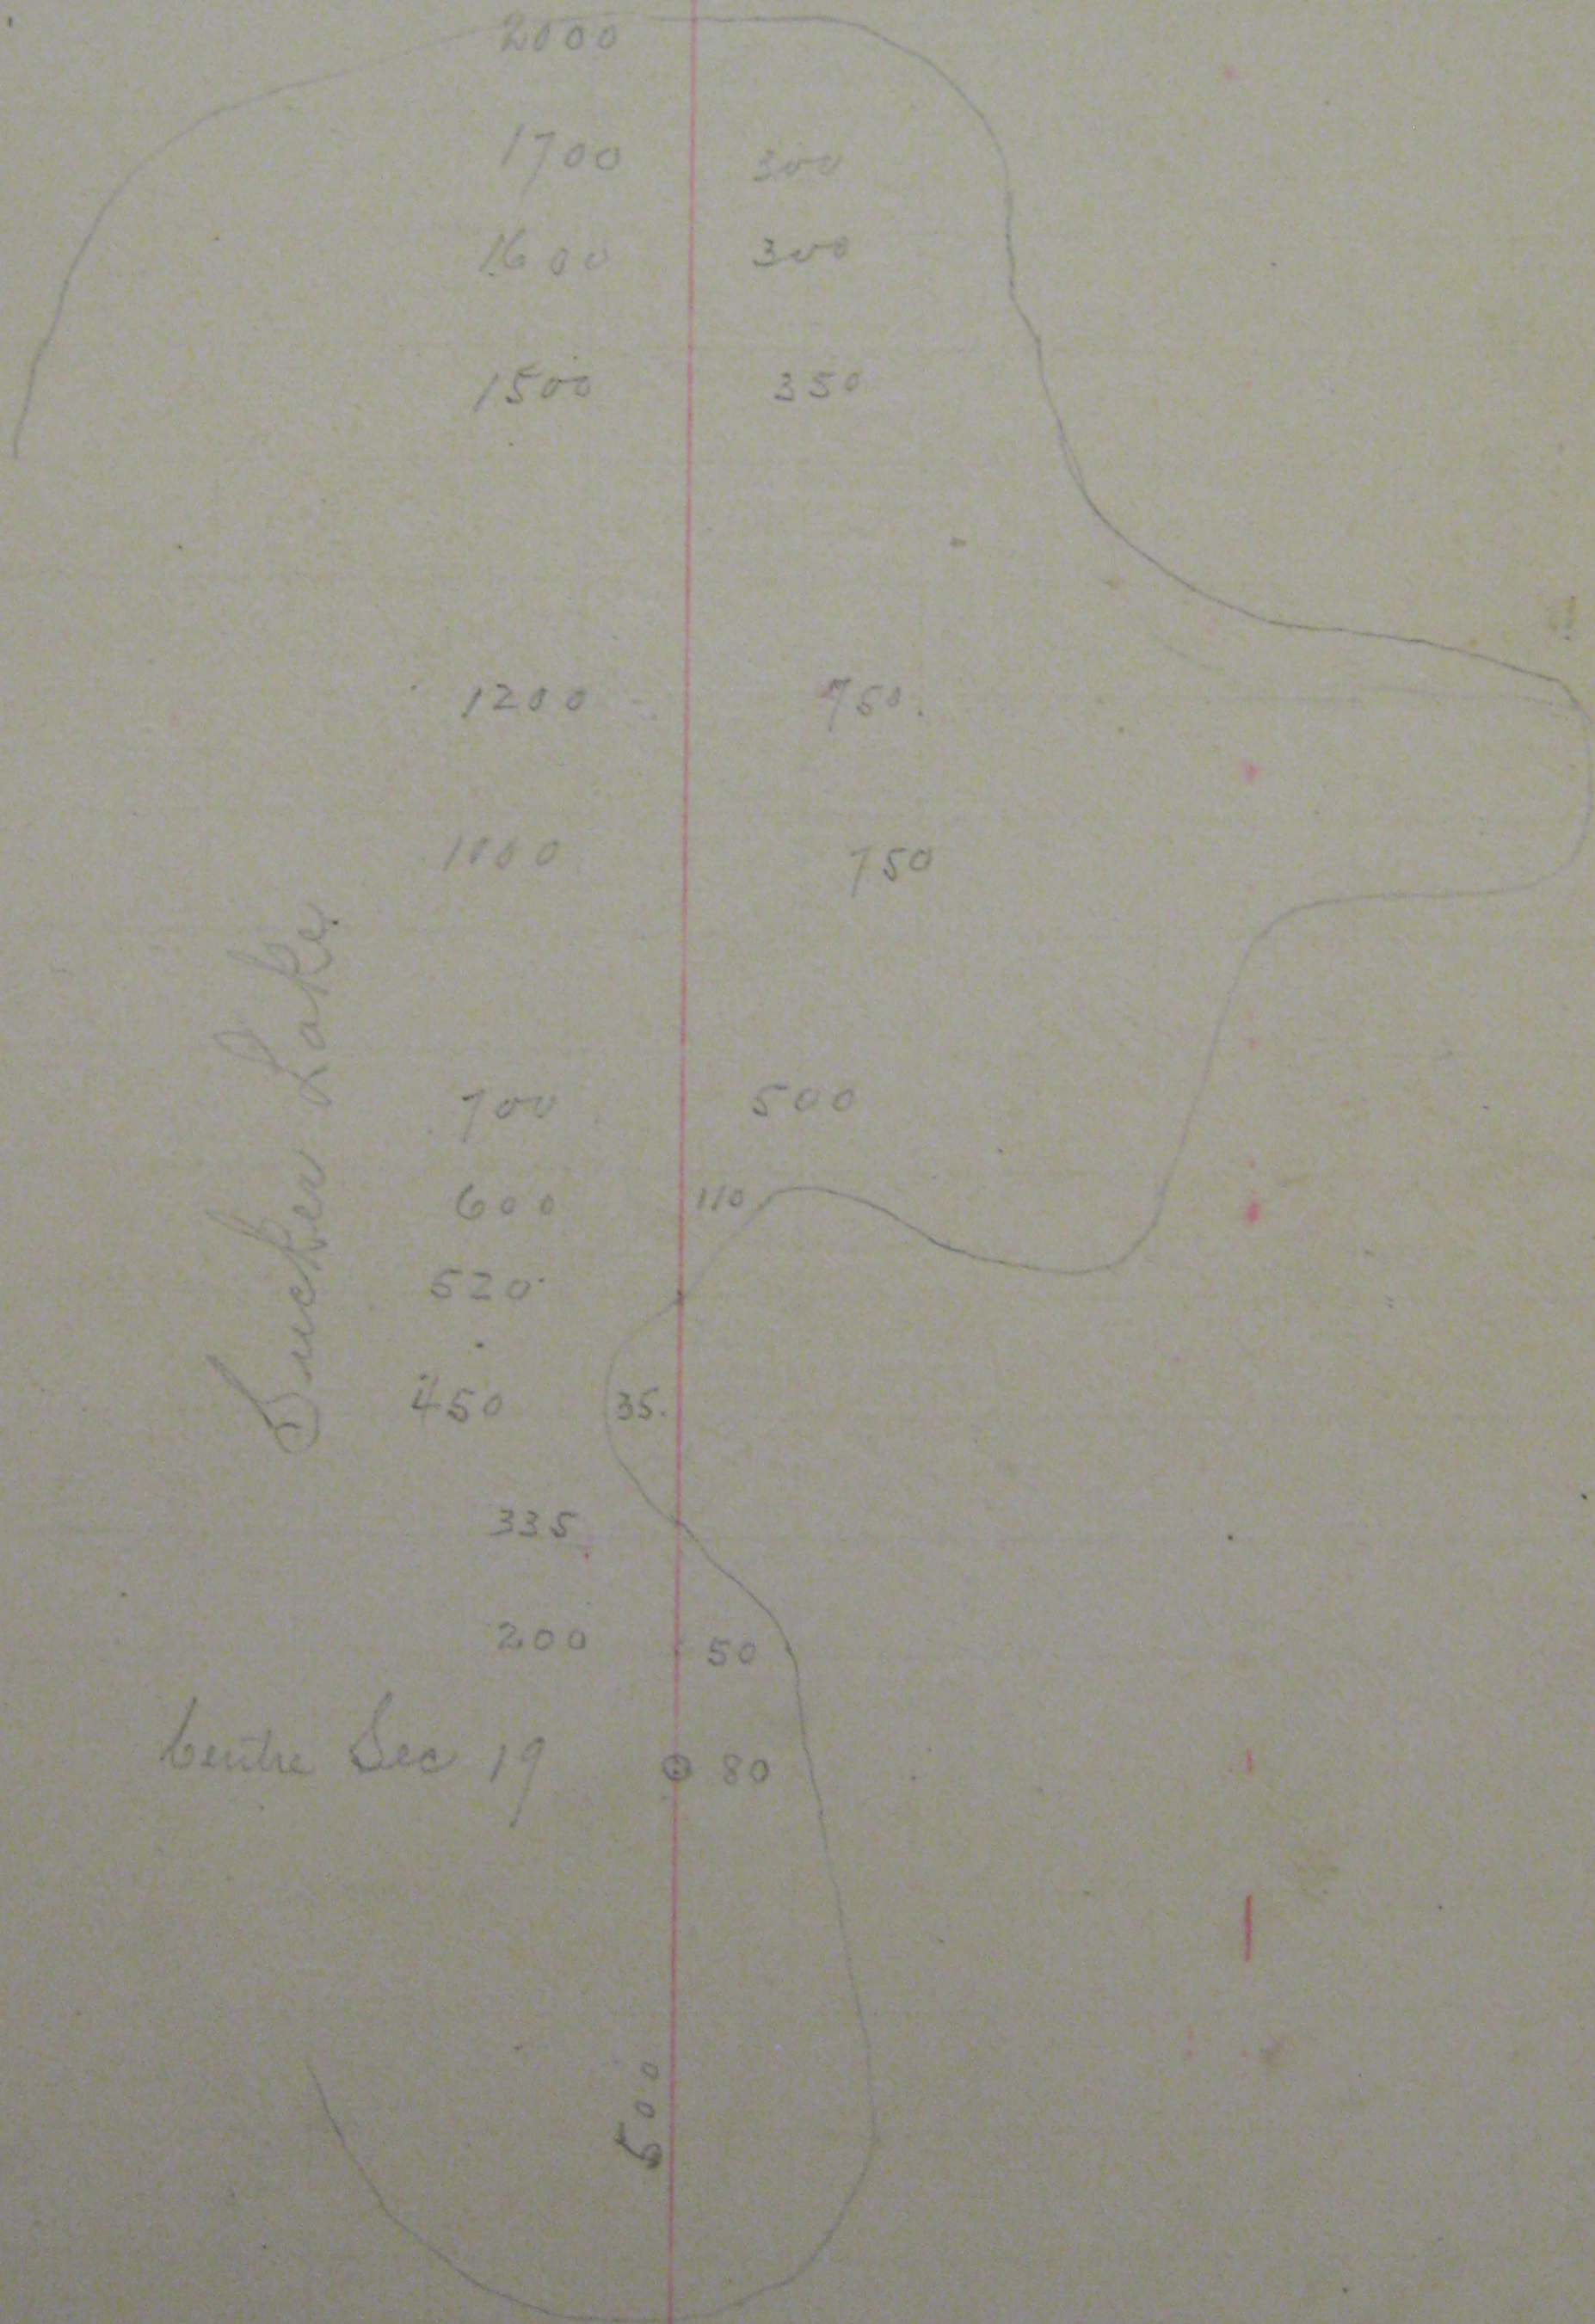


Centre Sec 19

o 80