



1323.87

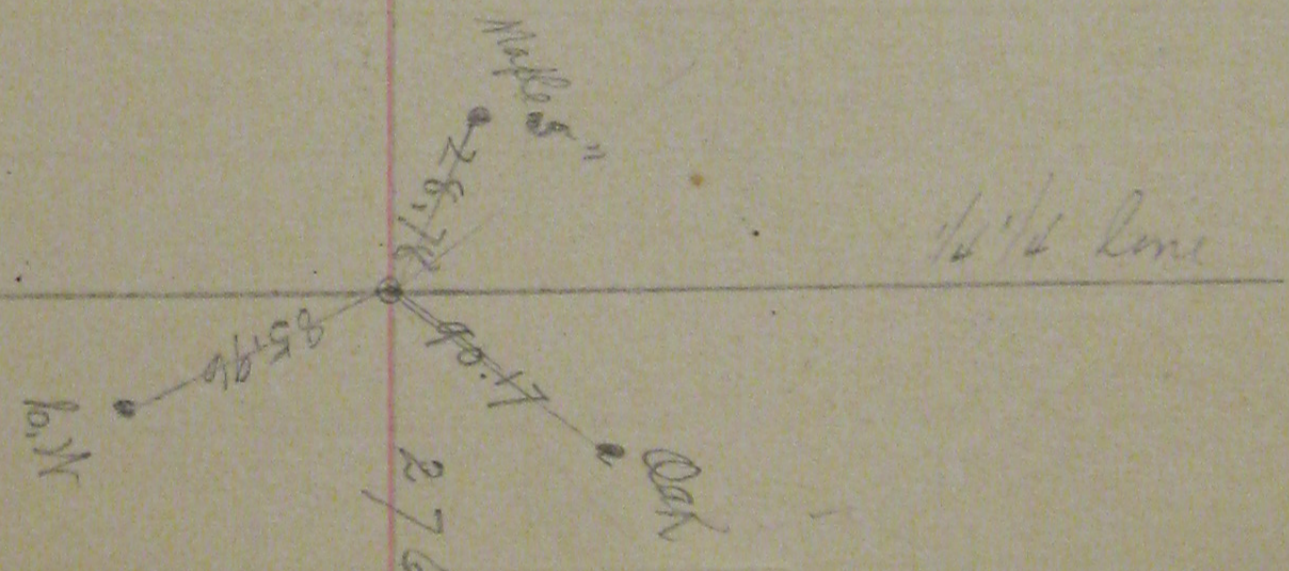

276.13

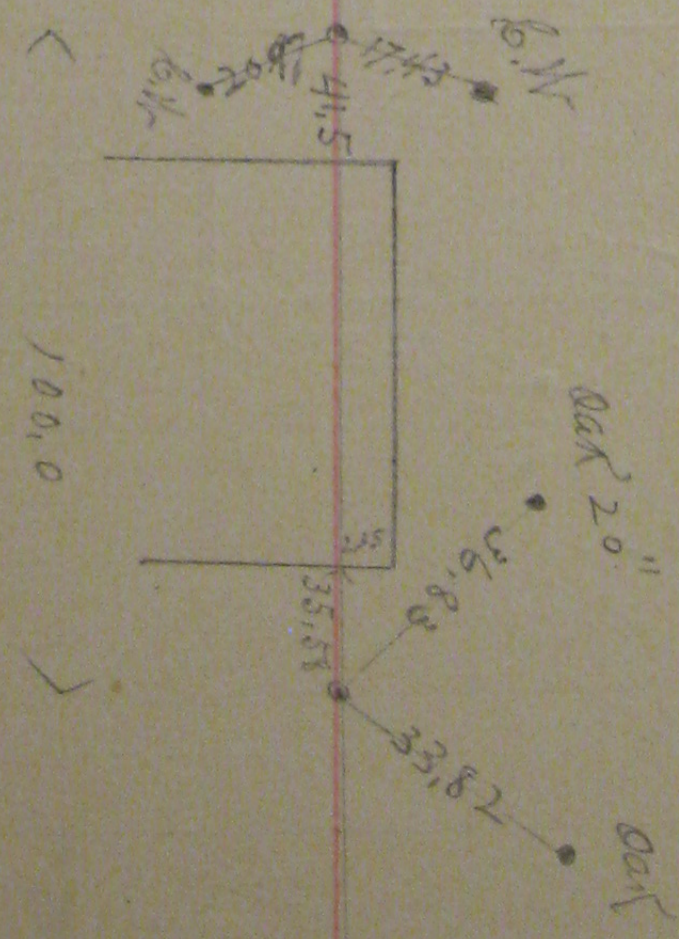

100.0

25