


Grants to 1/4 1/4 cor on line through center of Sec 29 T30 R22

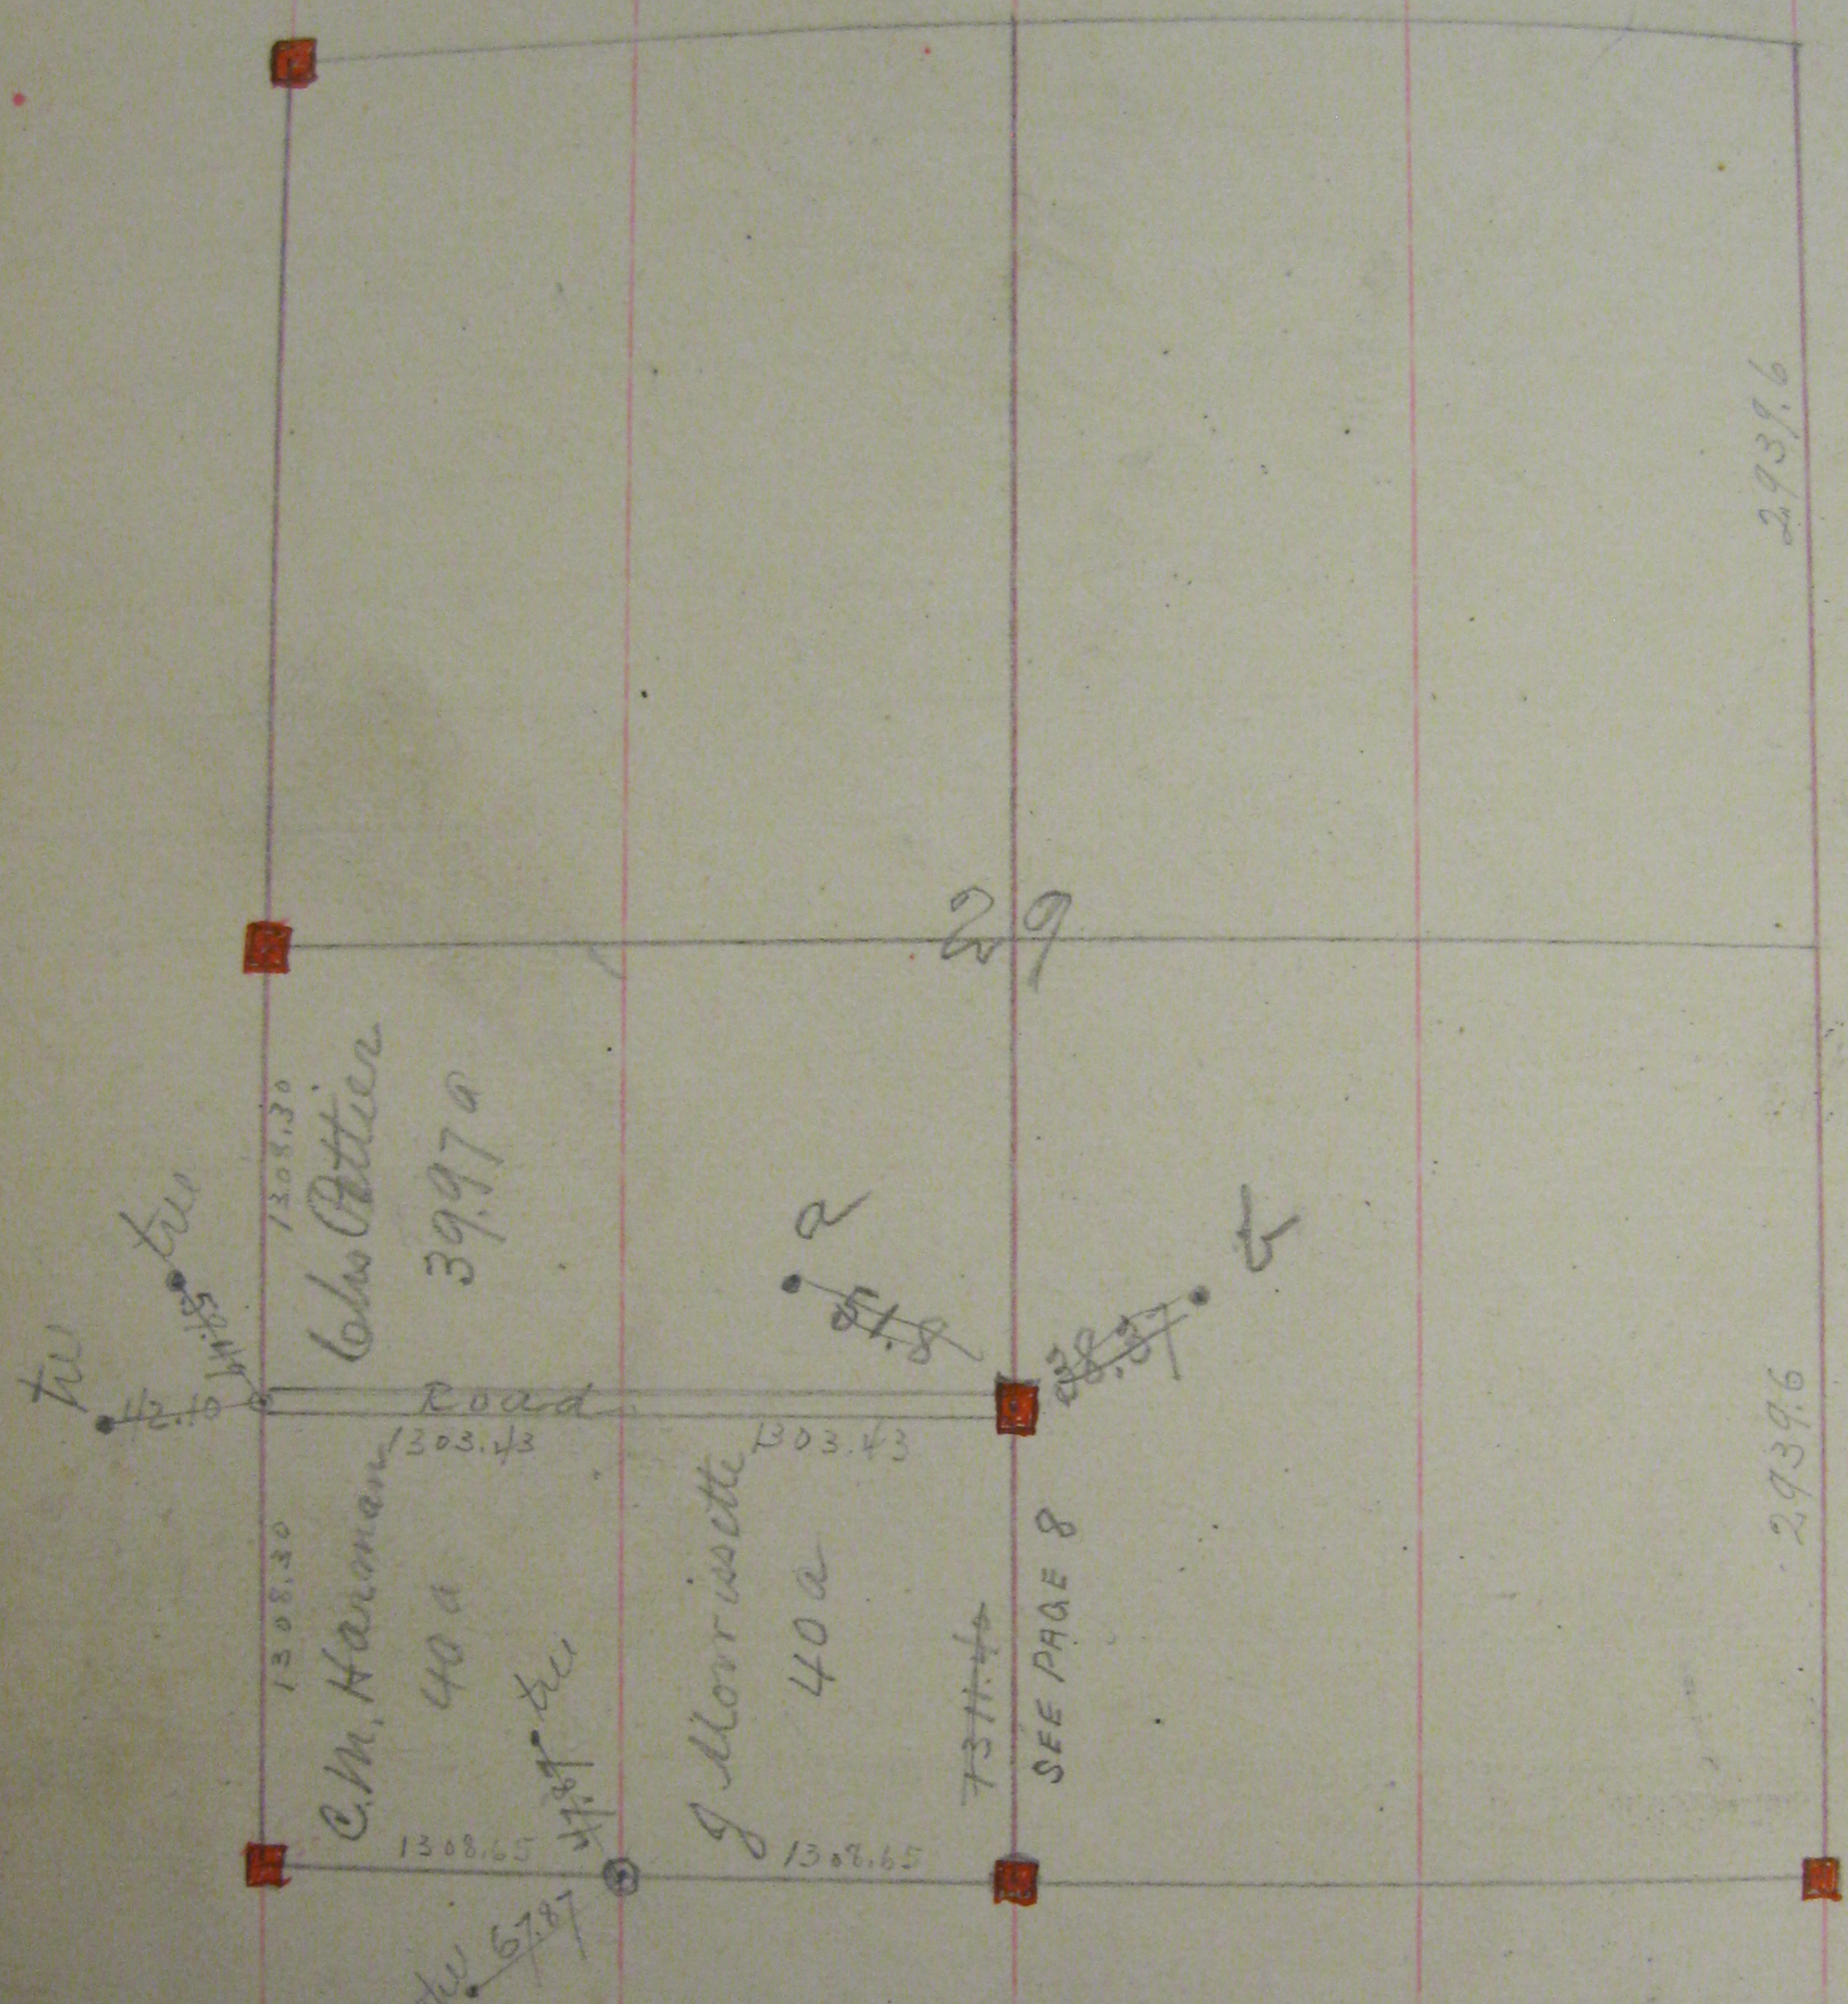

a oak tree (10) dia N.W 51.8
 b oak tree (8) " N.E 38.37