


14 Nov 4th 1895 1/4 Cor 22
26

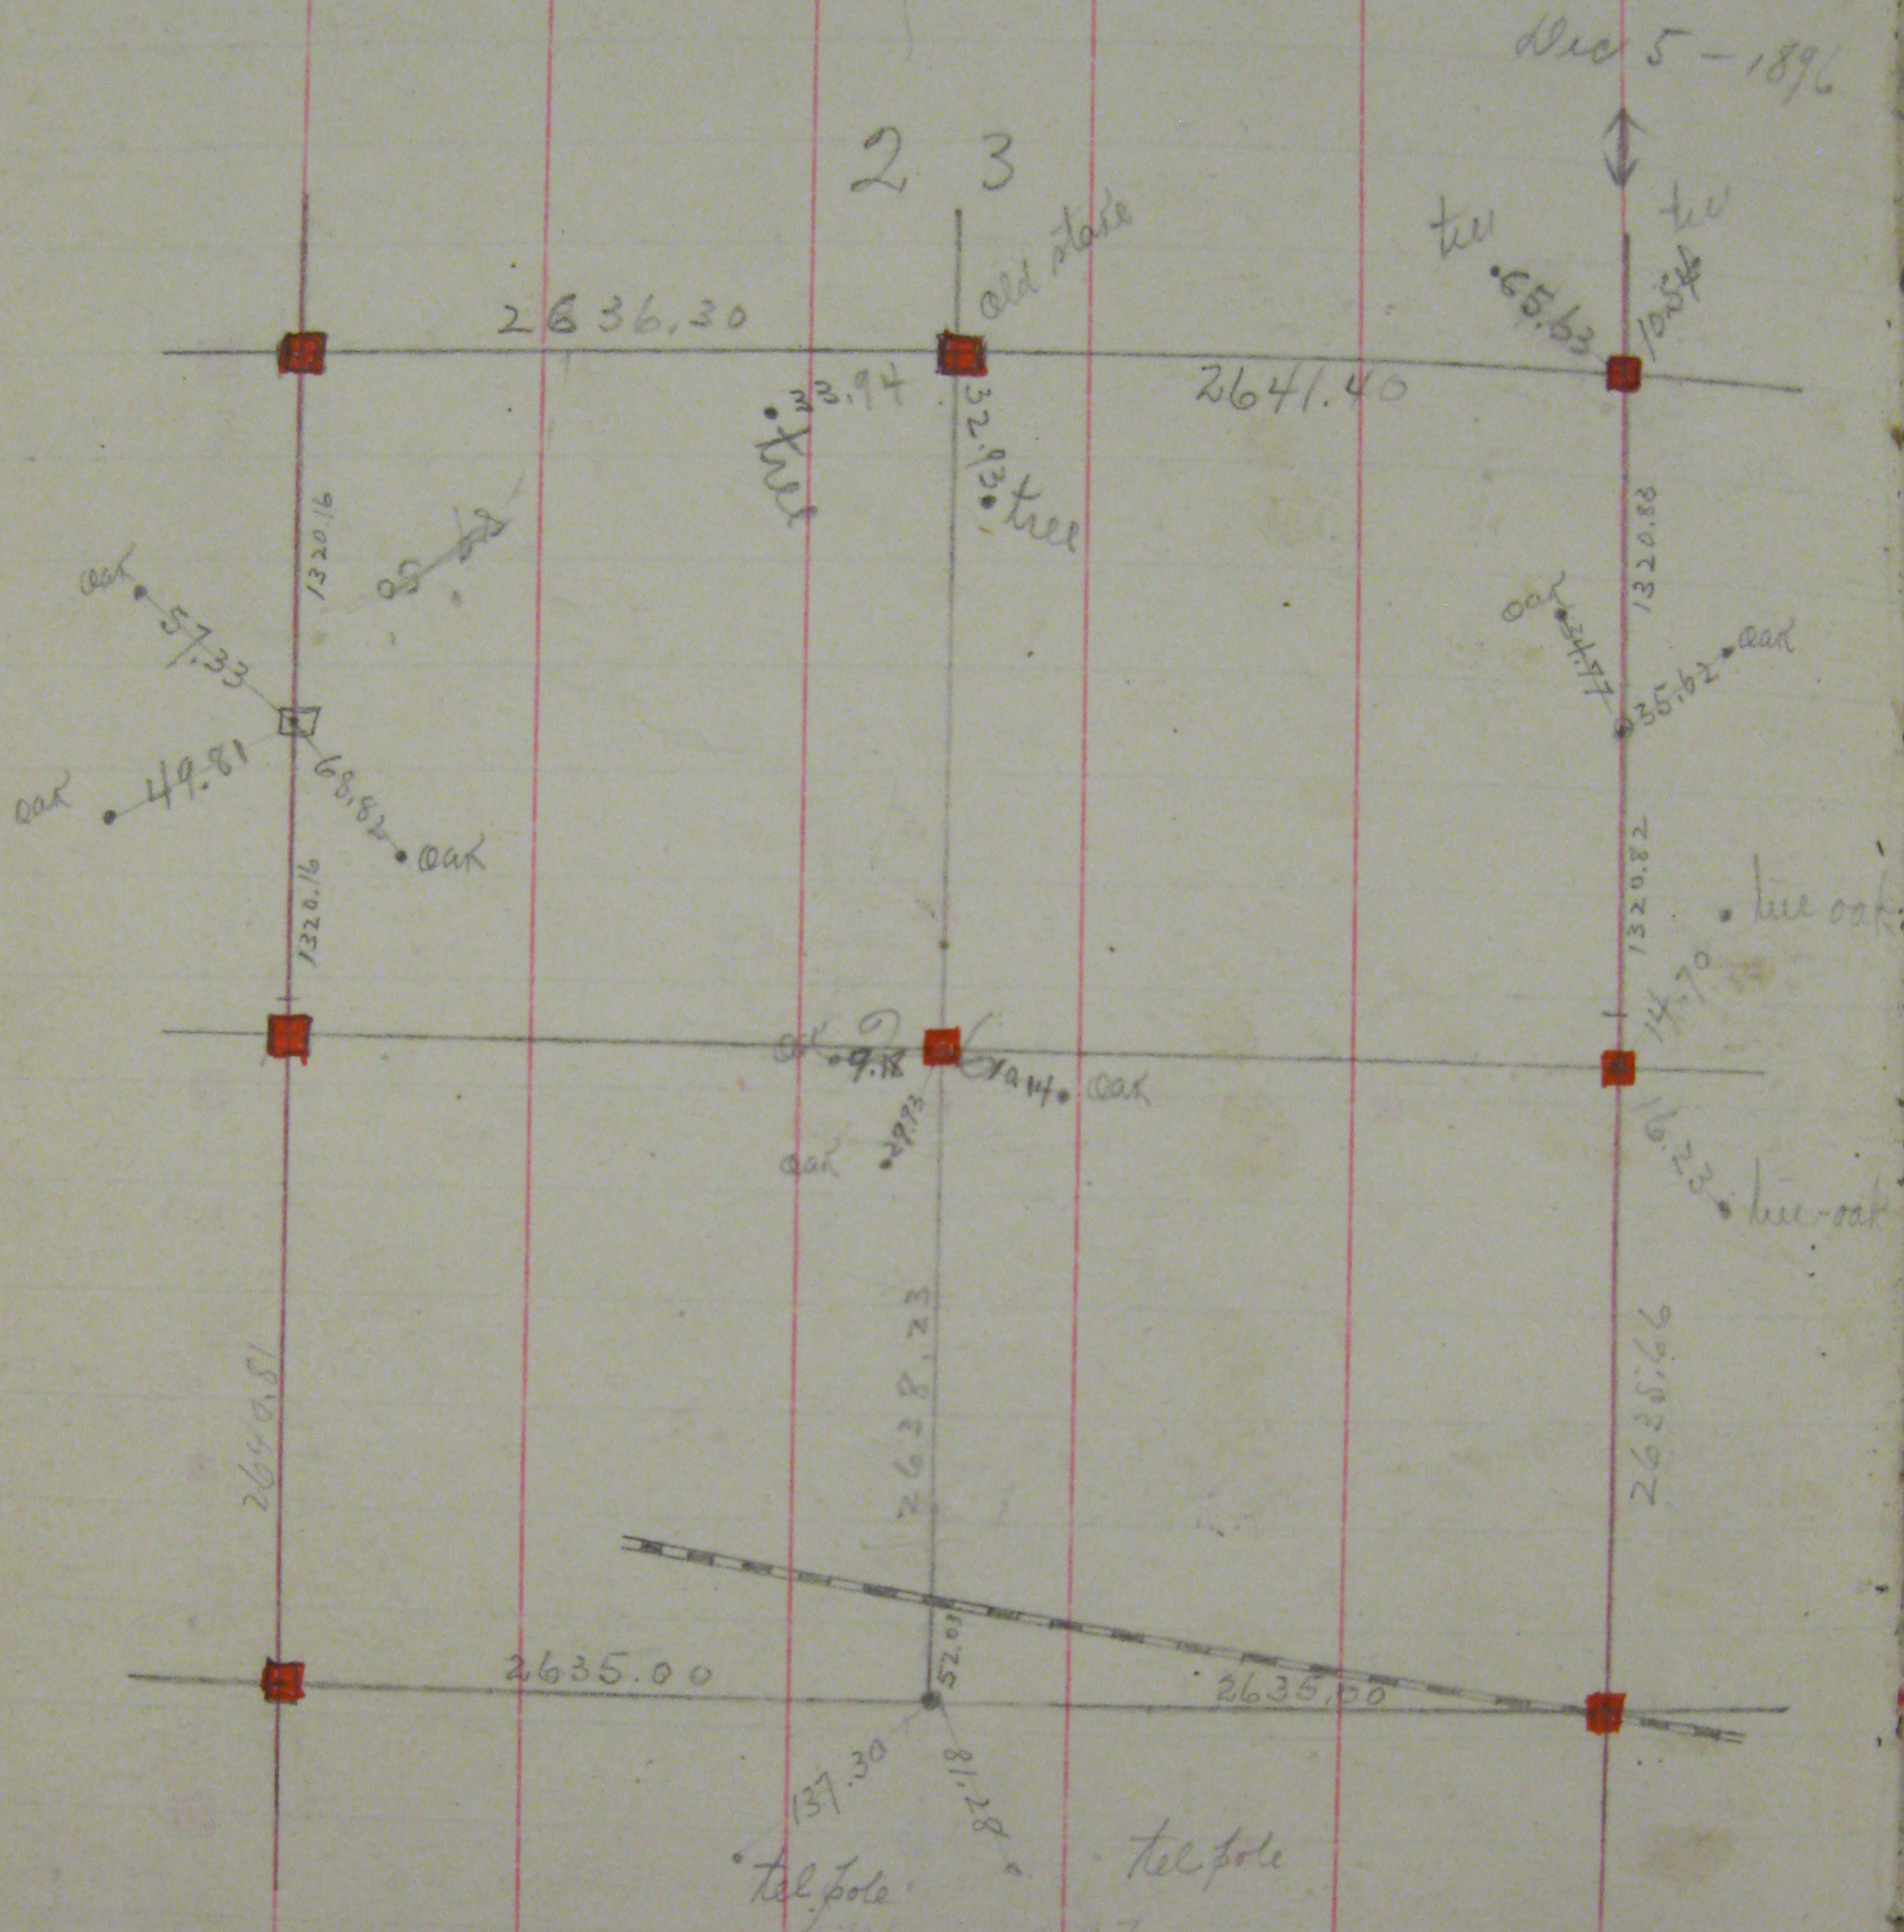

July 30-99 1/4 Cor bet Sec 26 & 35 is S of S Rail of
 Railroad track 52.03 in Lake
 S.E. Cor. and 1/4 Cor bet Sec 35 and 26