


found old stake at sec cor Dec 1895

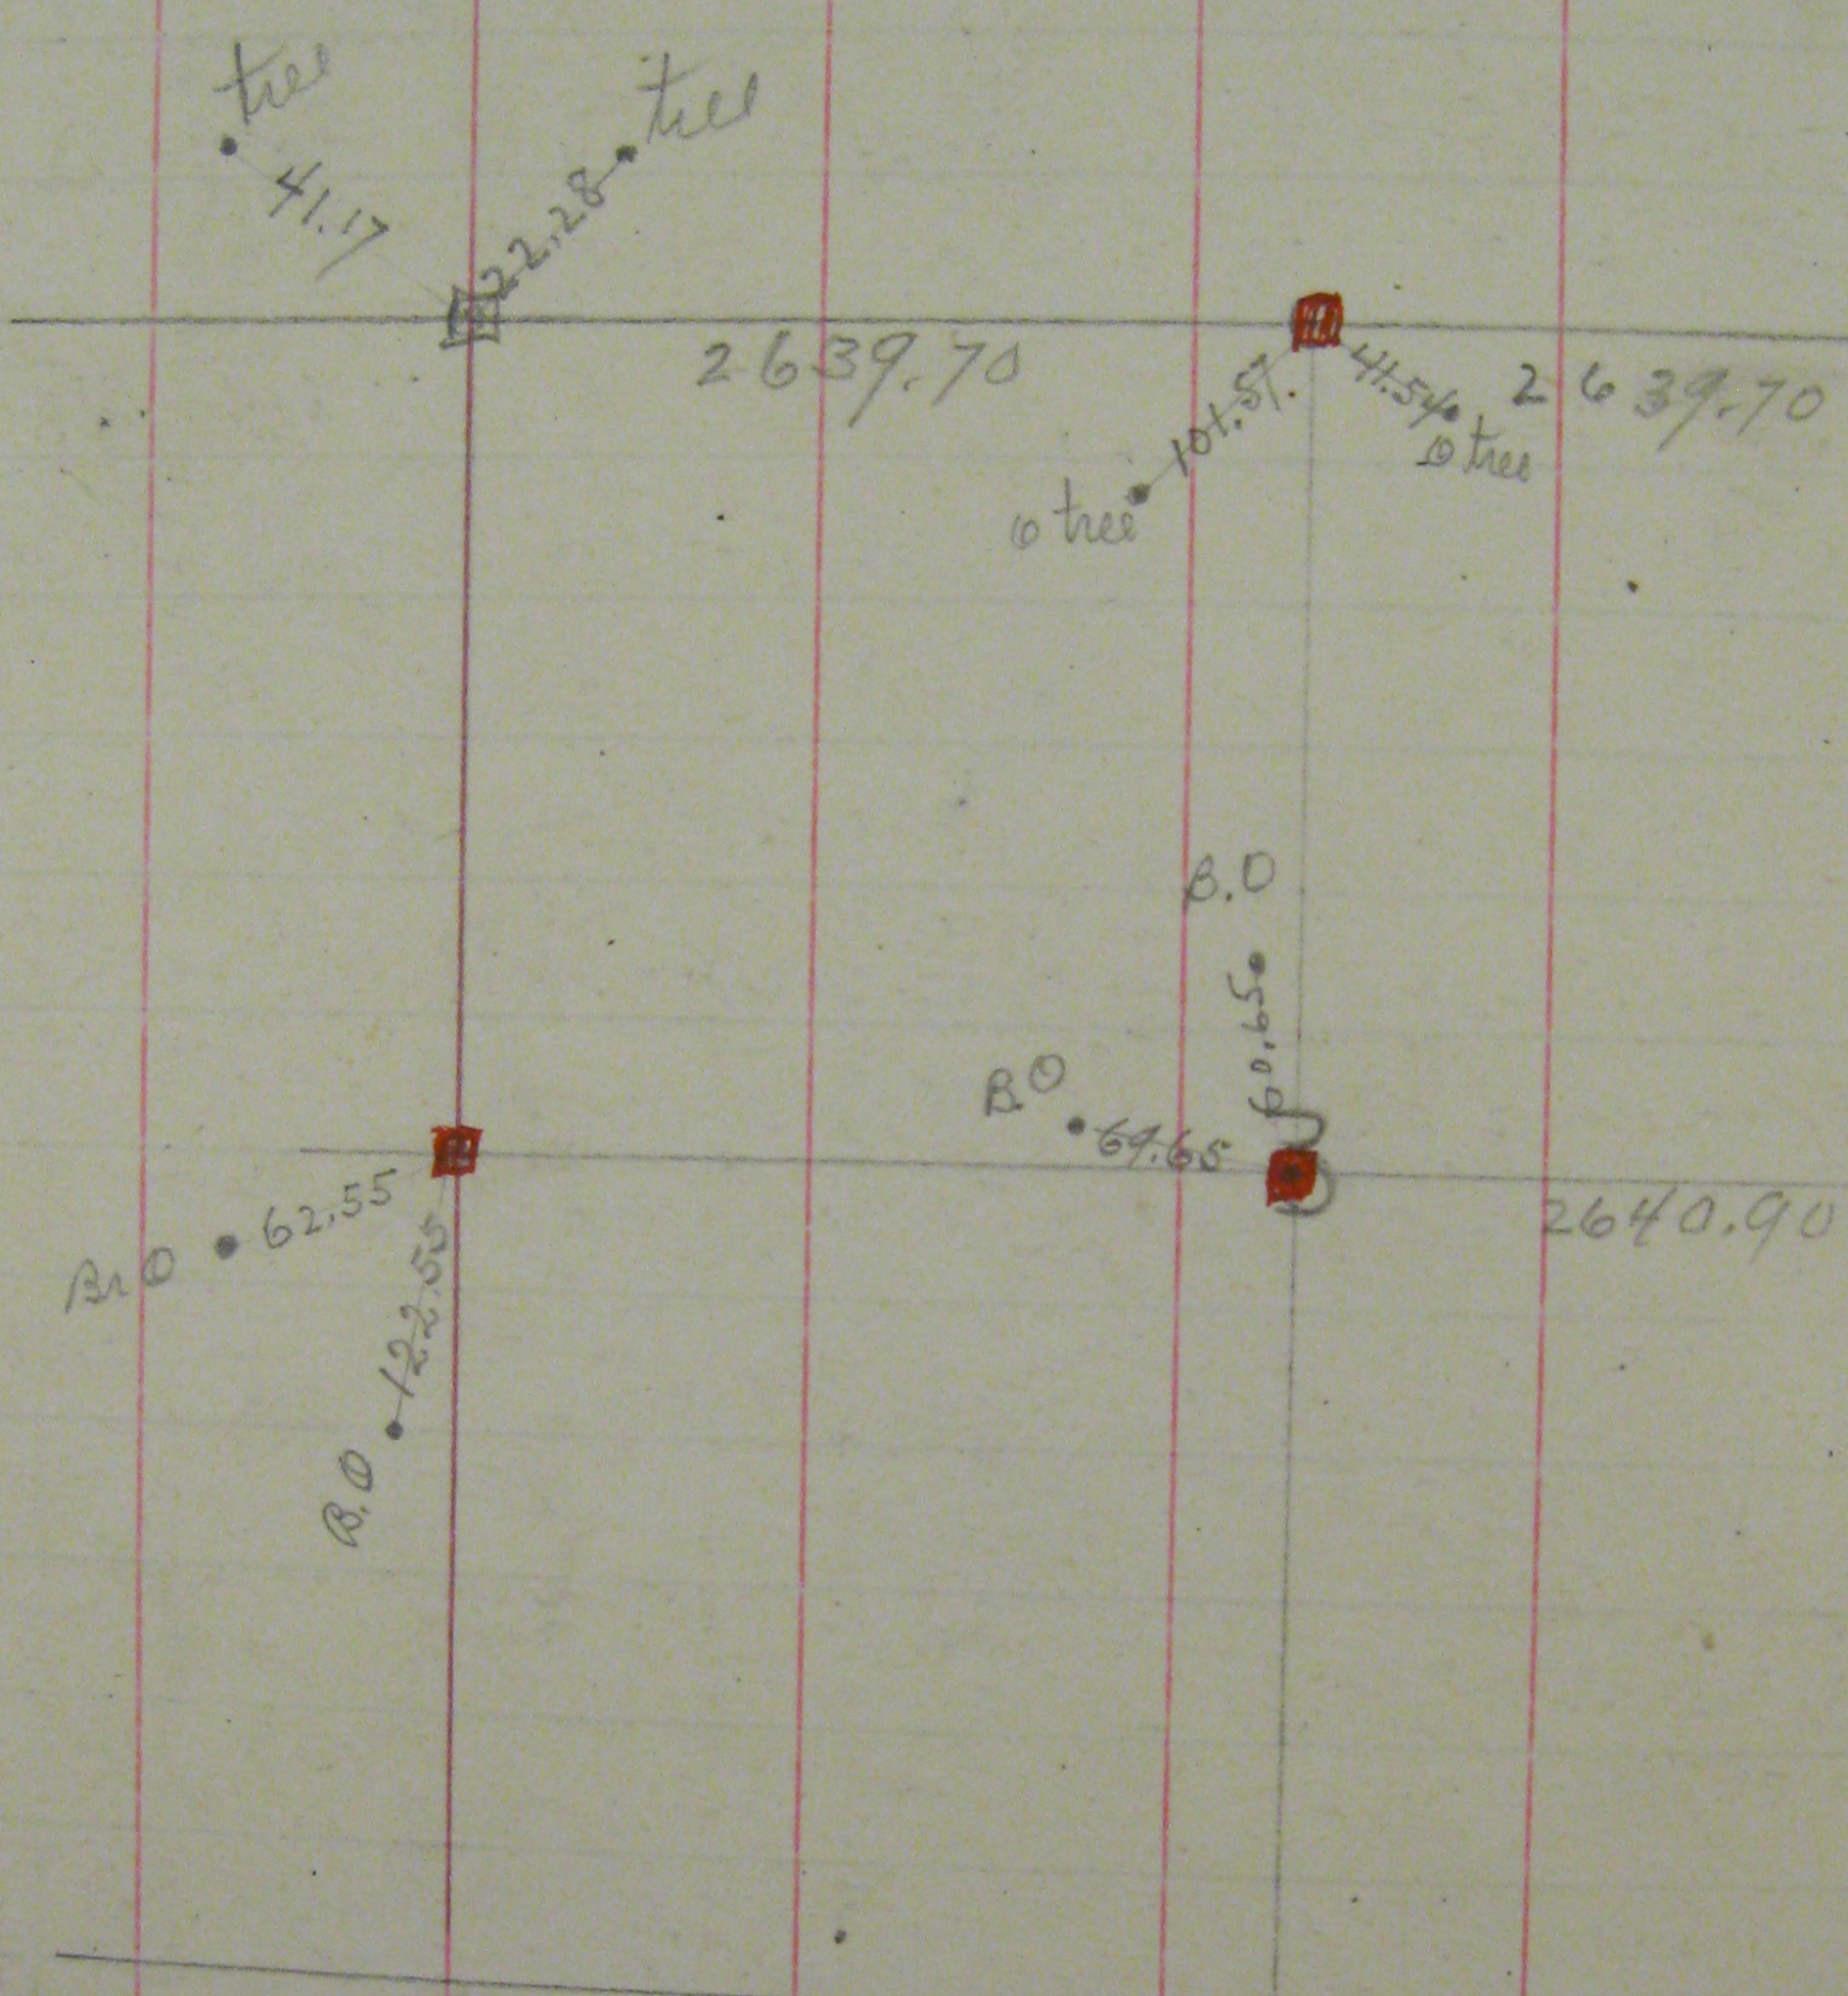

1/4 cor on West of sec 3 found one Govt. tree and old stake  
July 11<sup>th</sup> 1900