

TOWN LINE

31

32

33

3


35

36

TOWN LINE

31

32

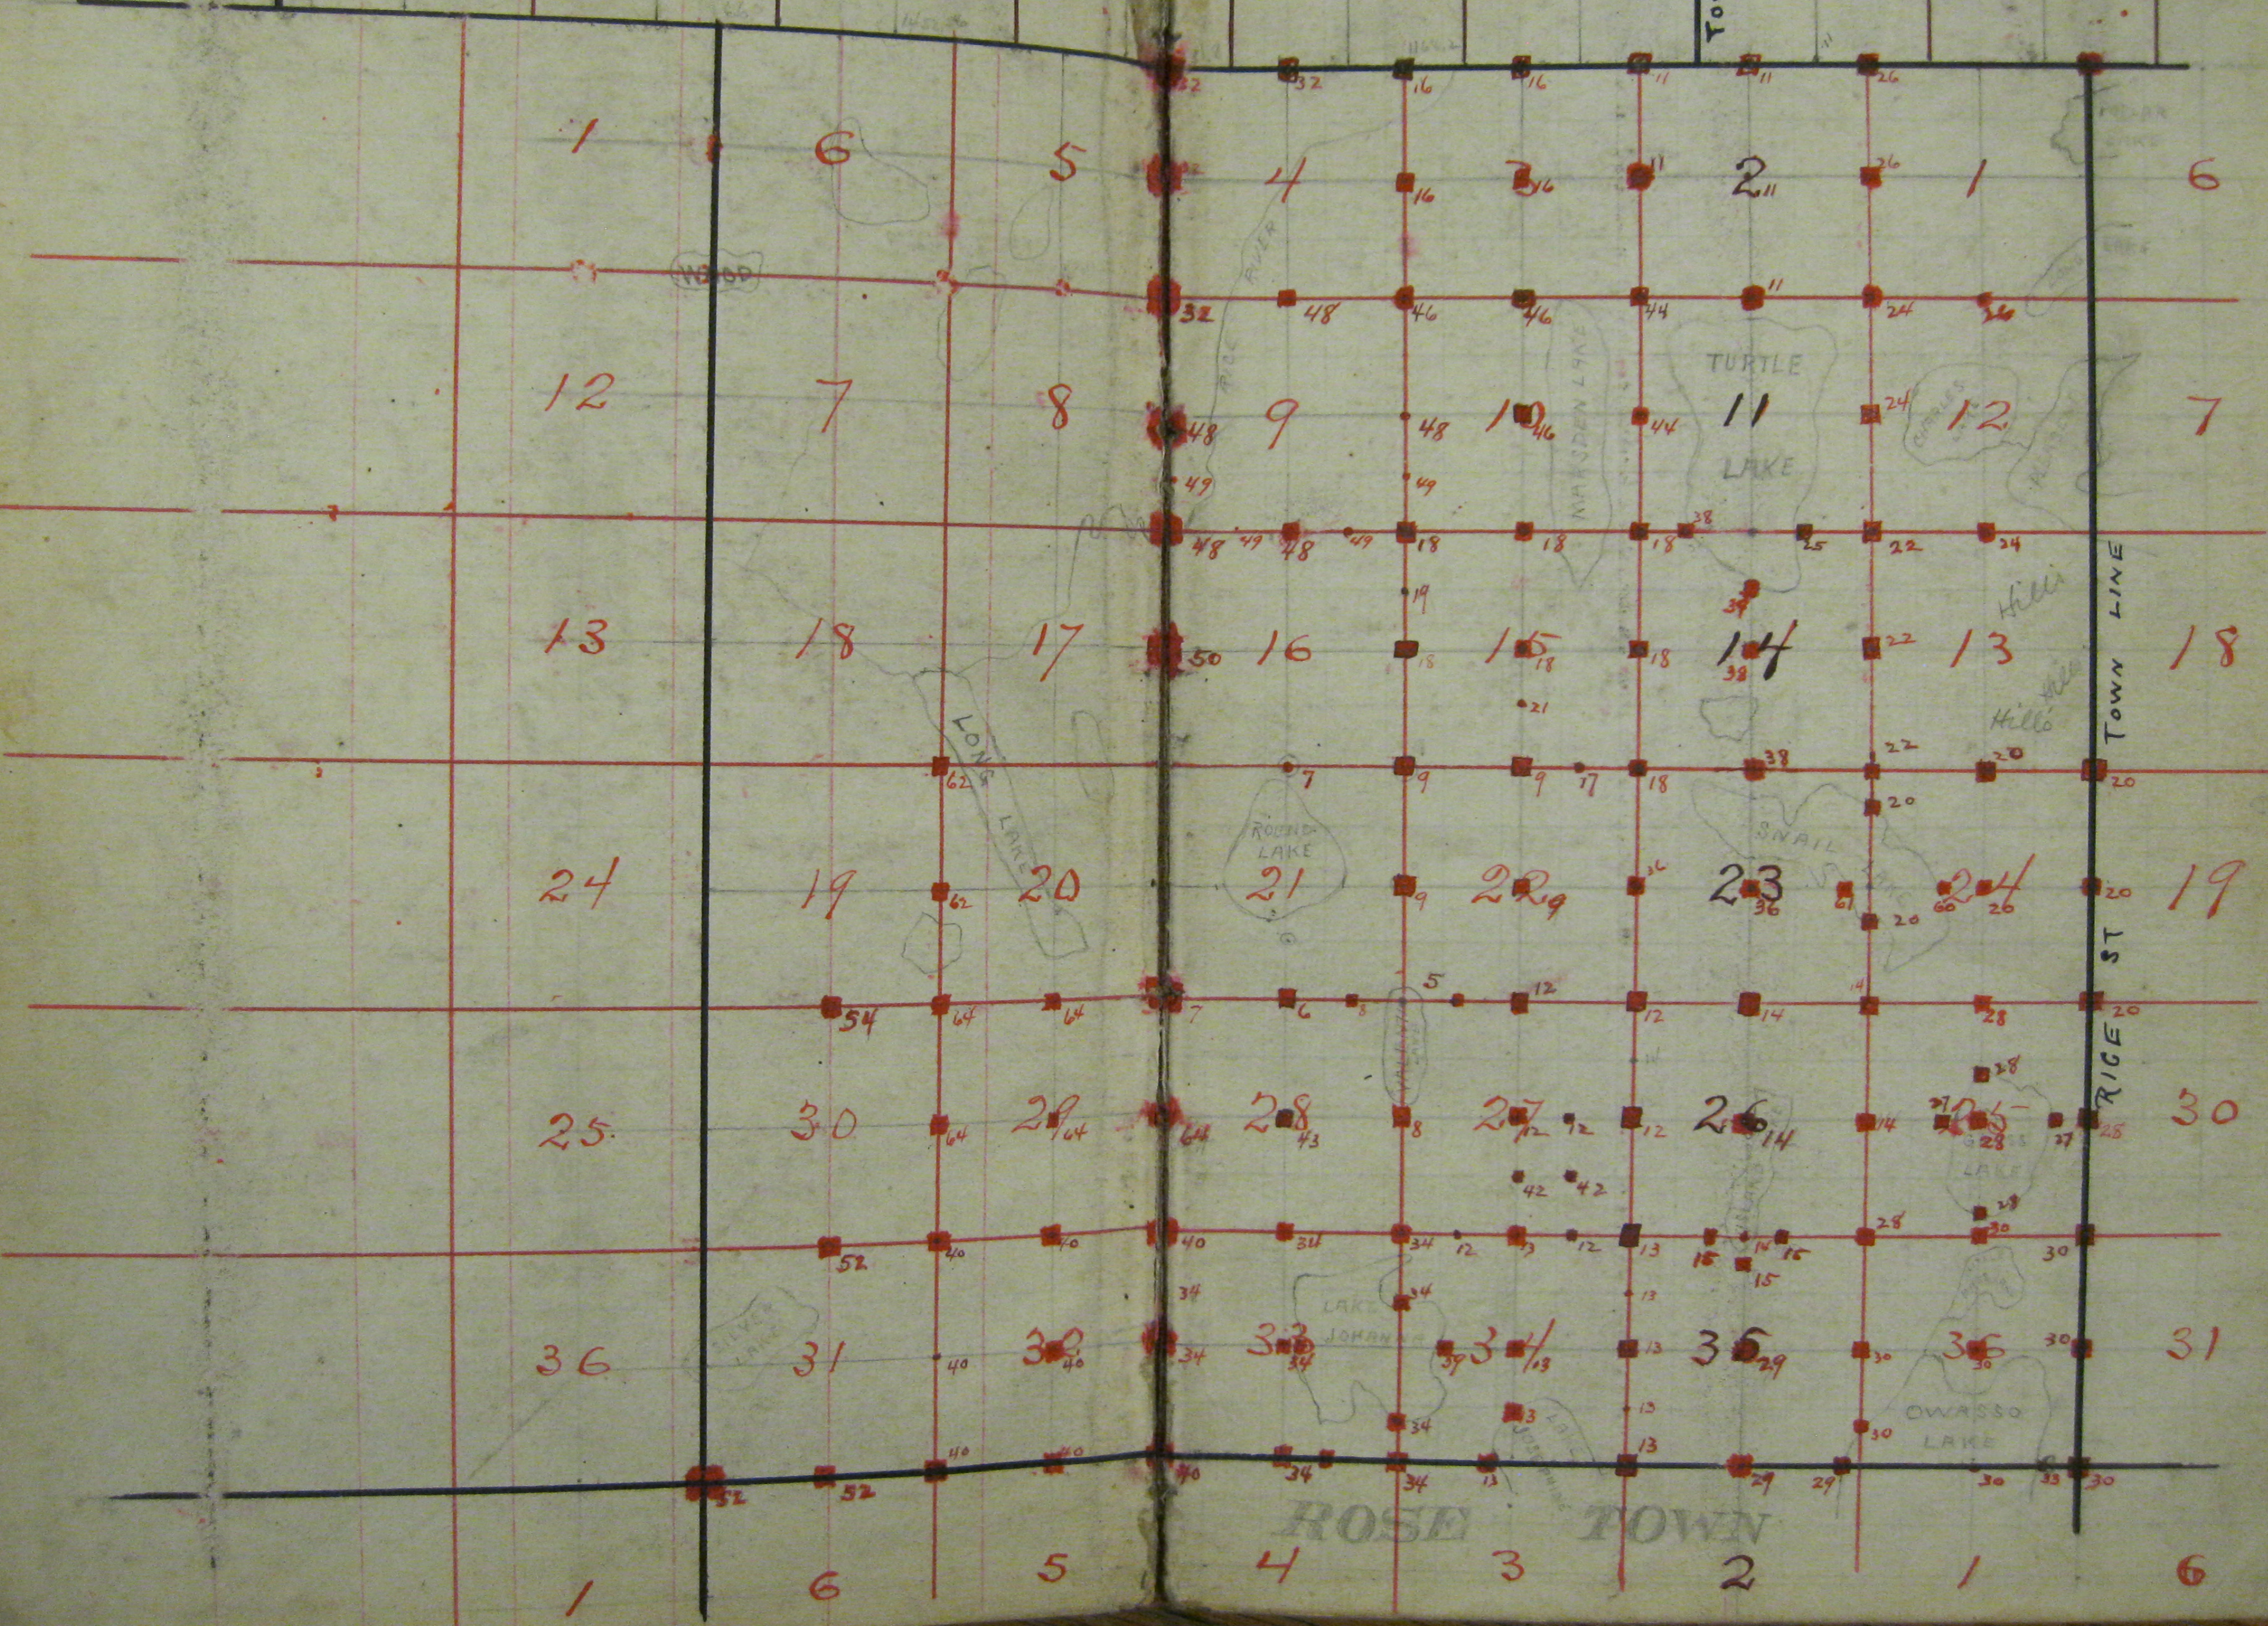

1 6 5 4 3 2 1 6

12 7 8 9 10 11 12 7

13 18 17 16 15 14 13 18

24 19 20 21 22 23 24 19

25 30 29 28 27 26 25 30


1 6 5 4 3 2 1 6

LONG LAKE

ROUND LAKE

TURTLE LAKE

SNAIL LAKE

OWASSO LAKE

MARDEN LAKE

SILVER LAKE

ROSE TOWN

RICE ST

RICE RIVER