


26 July 1896 1/4 cor bet sec 1+2 found old stake and one post stump standing filed cor

July 20th 1896 Measurements Made

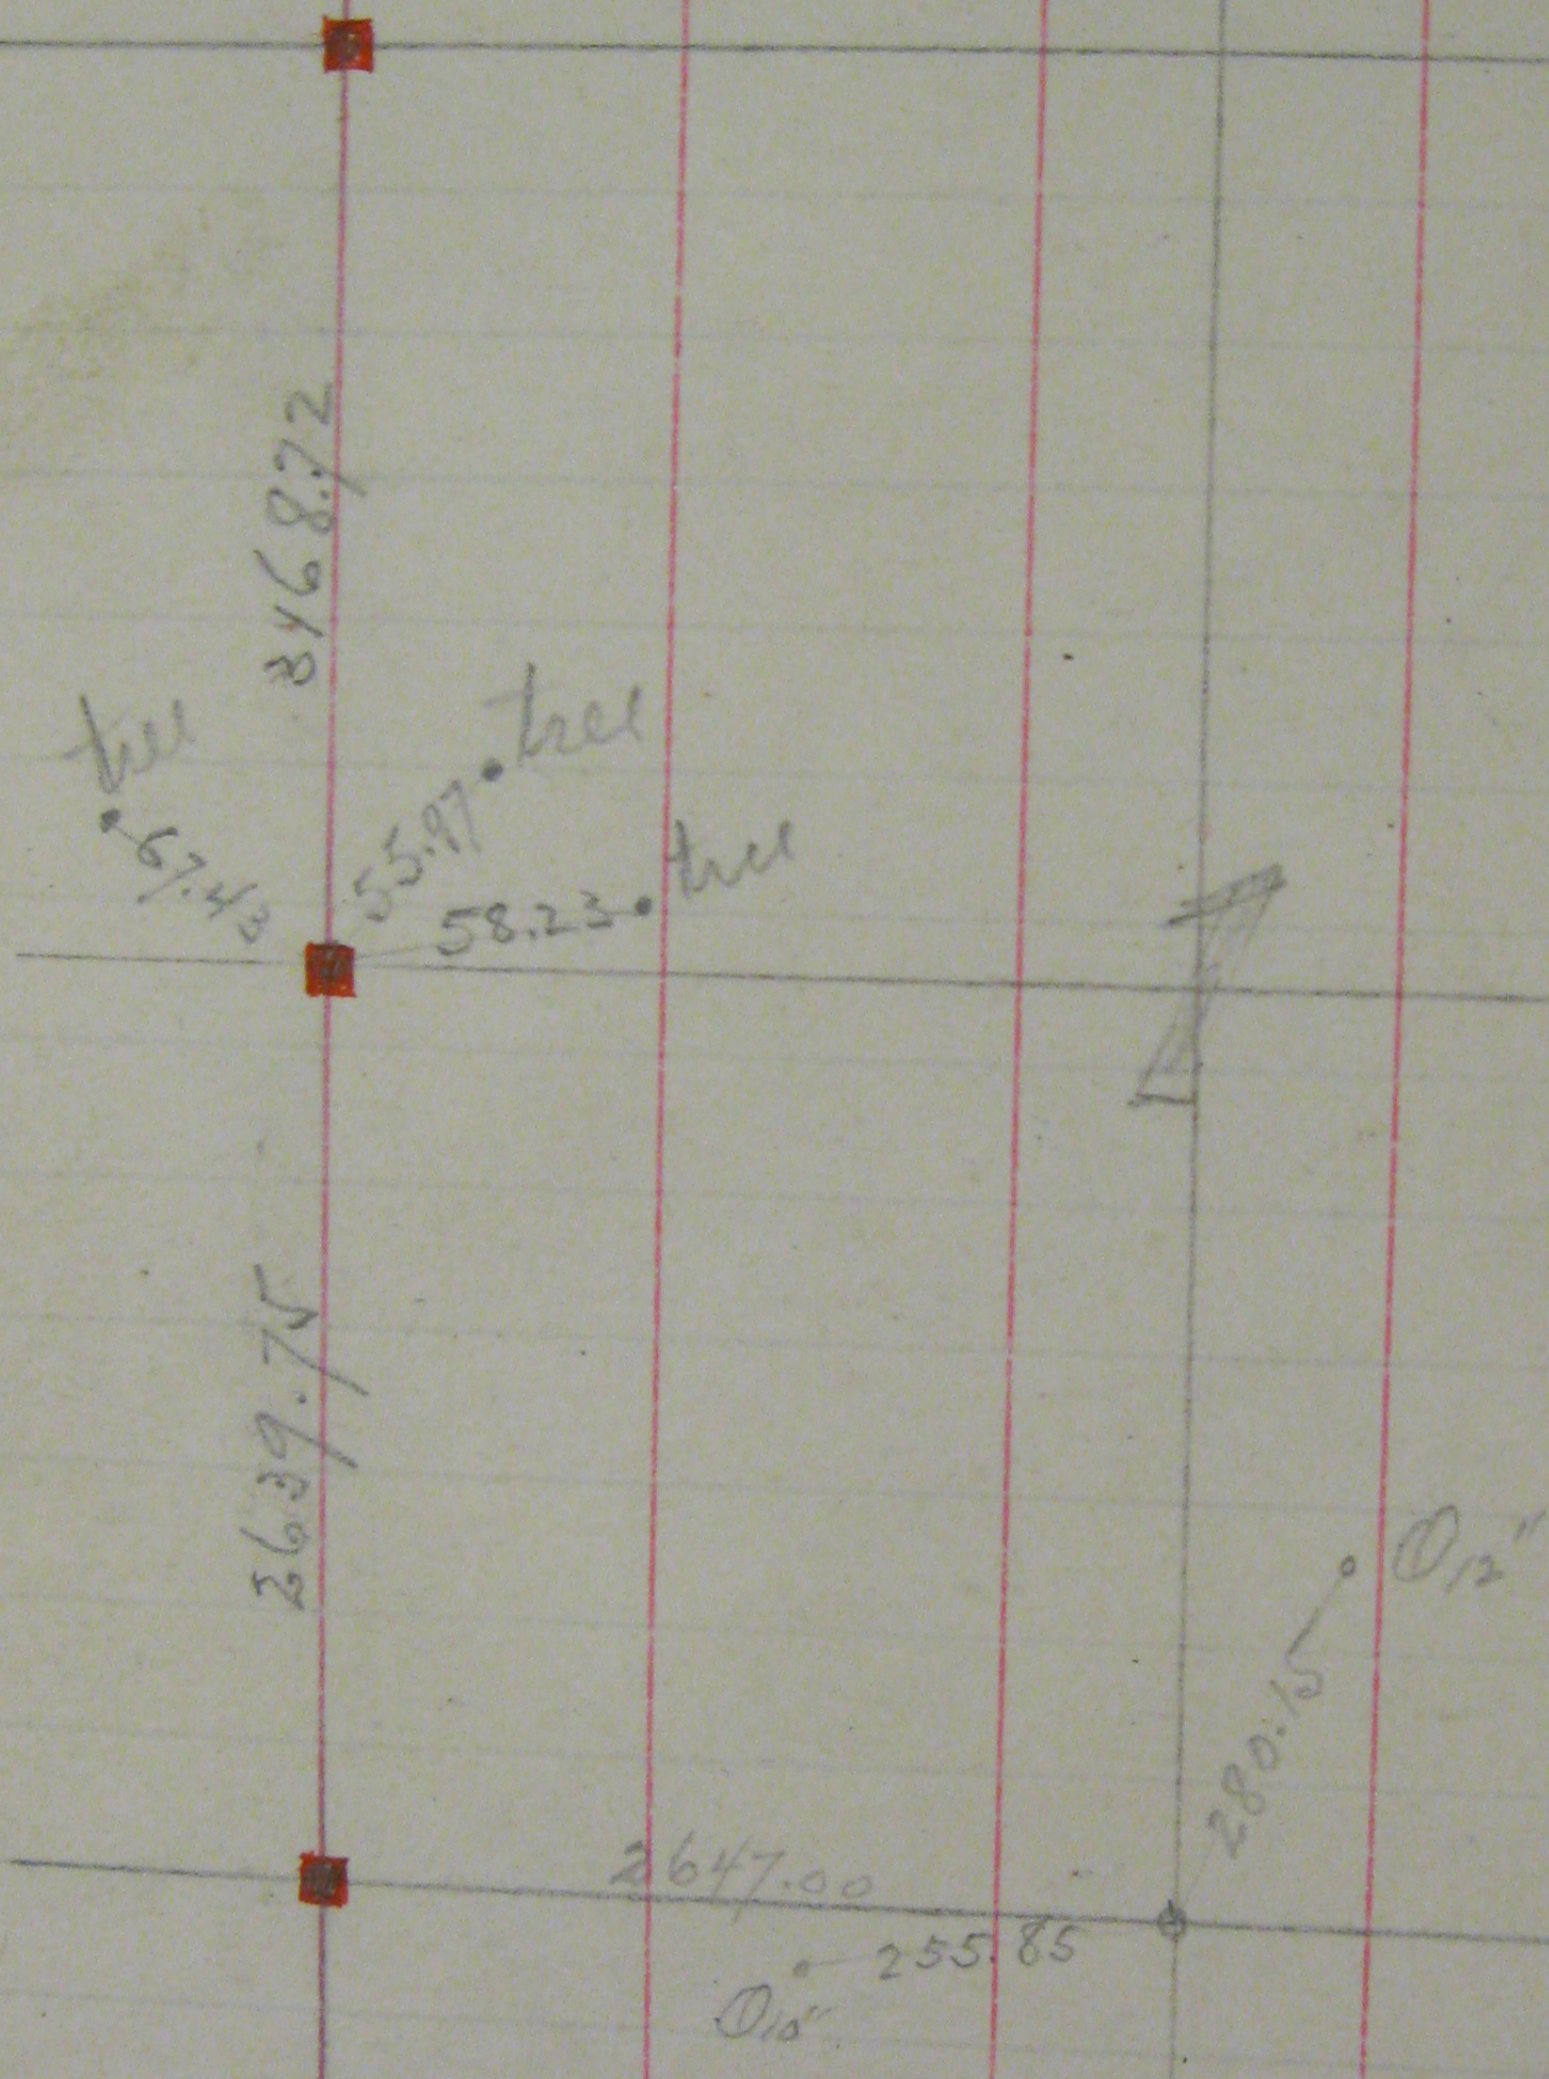

Mar 17 - 1900 Found 2 Log stumps at 1/4 cor bet 1 and 12