


100

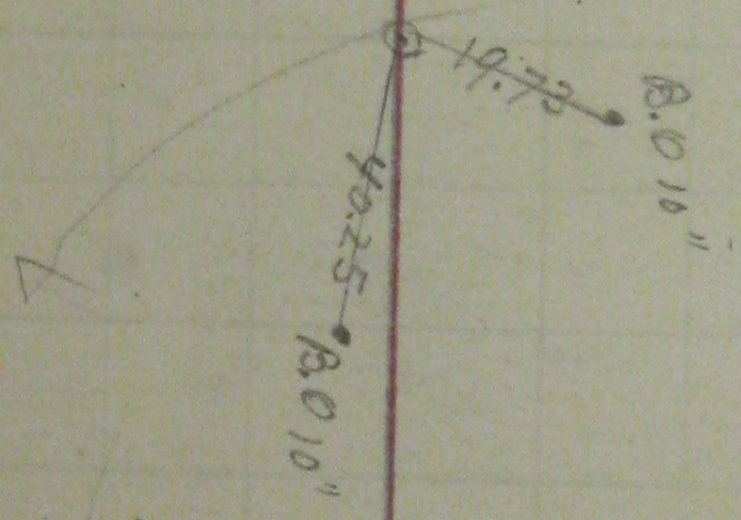

717.80

36

