


Sec 14

March 13 - 1897

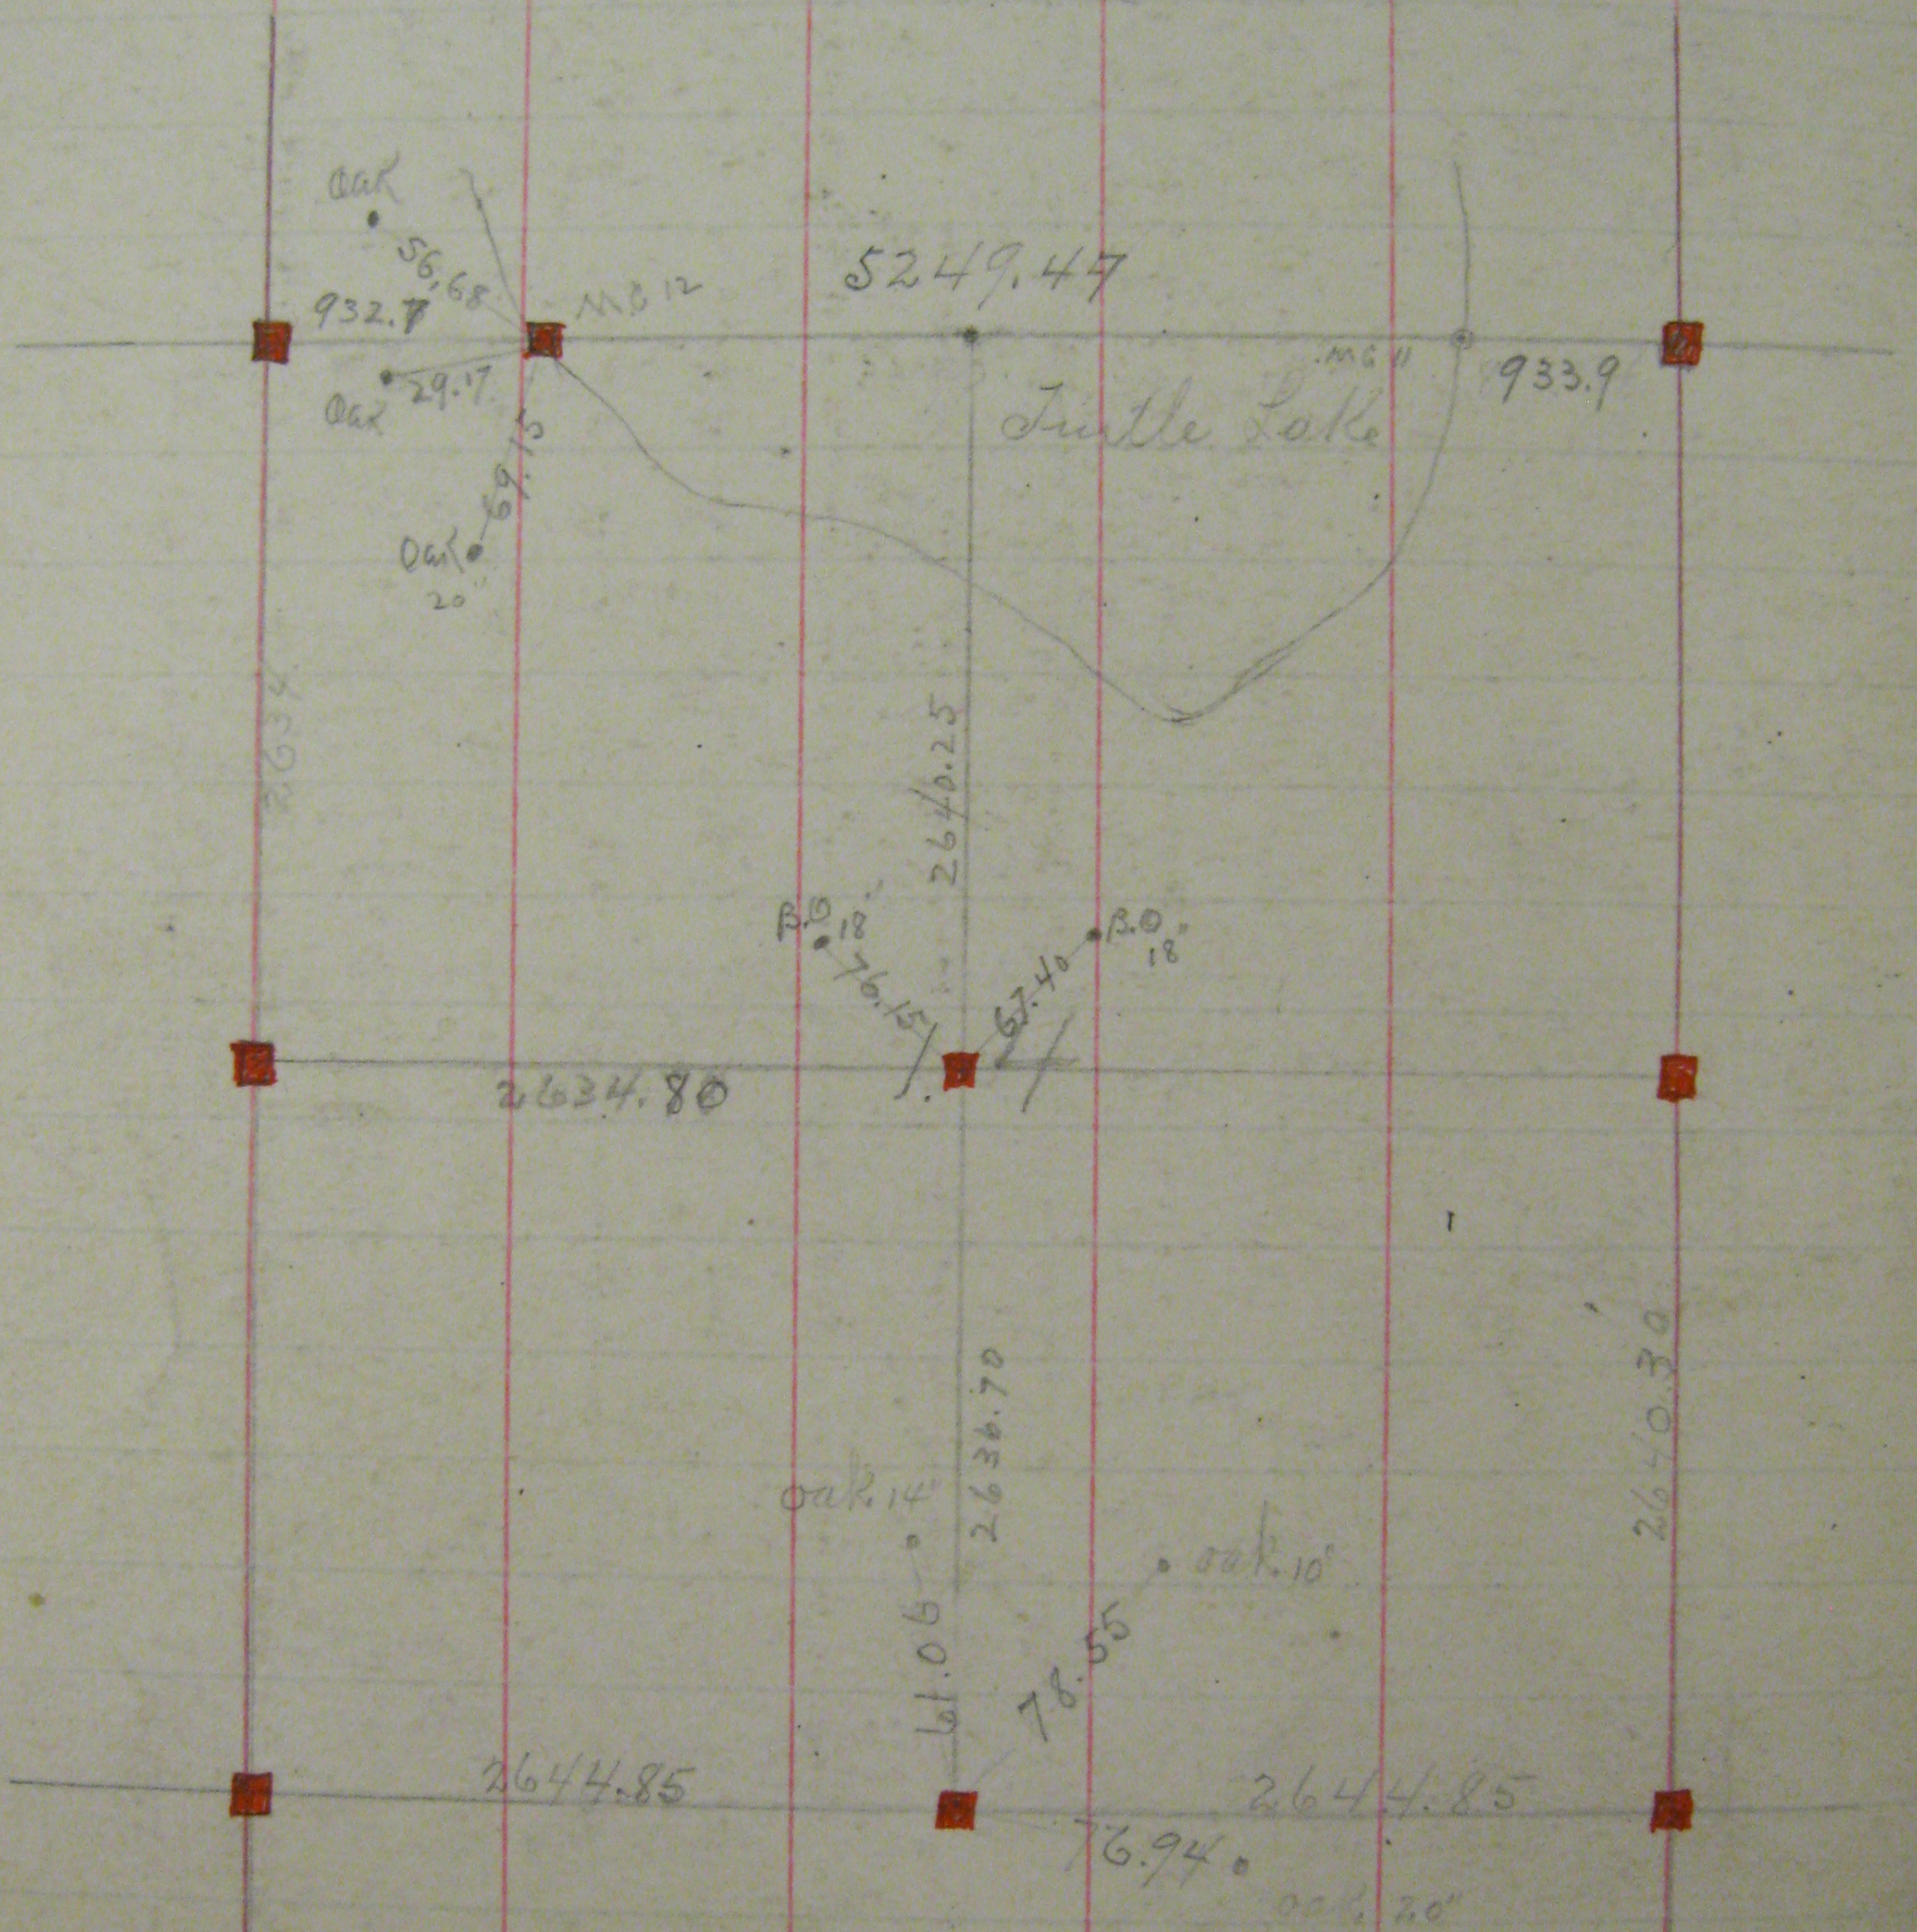

M.C. 12 One Goat stump standing May 1897

Oct 27 - 1897 1/4 corner bet 14 & 22 run straight line from corner to corner and find 1/4 corner on line