


1/4 sec from West side 16 set 33 feet West of Post set by Striba

Sec 16

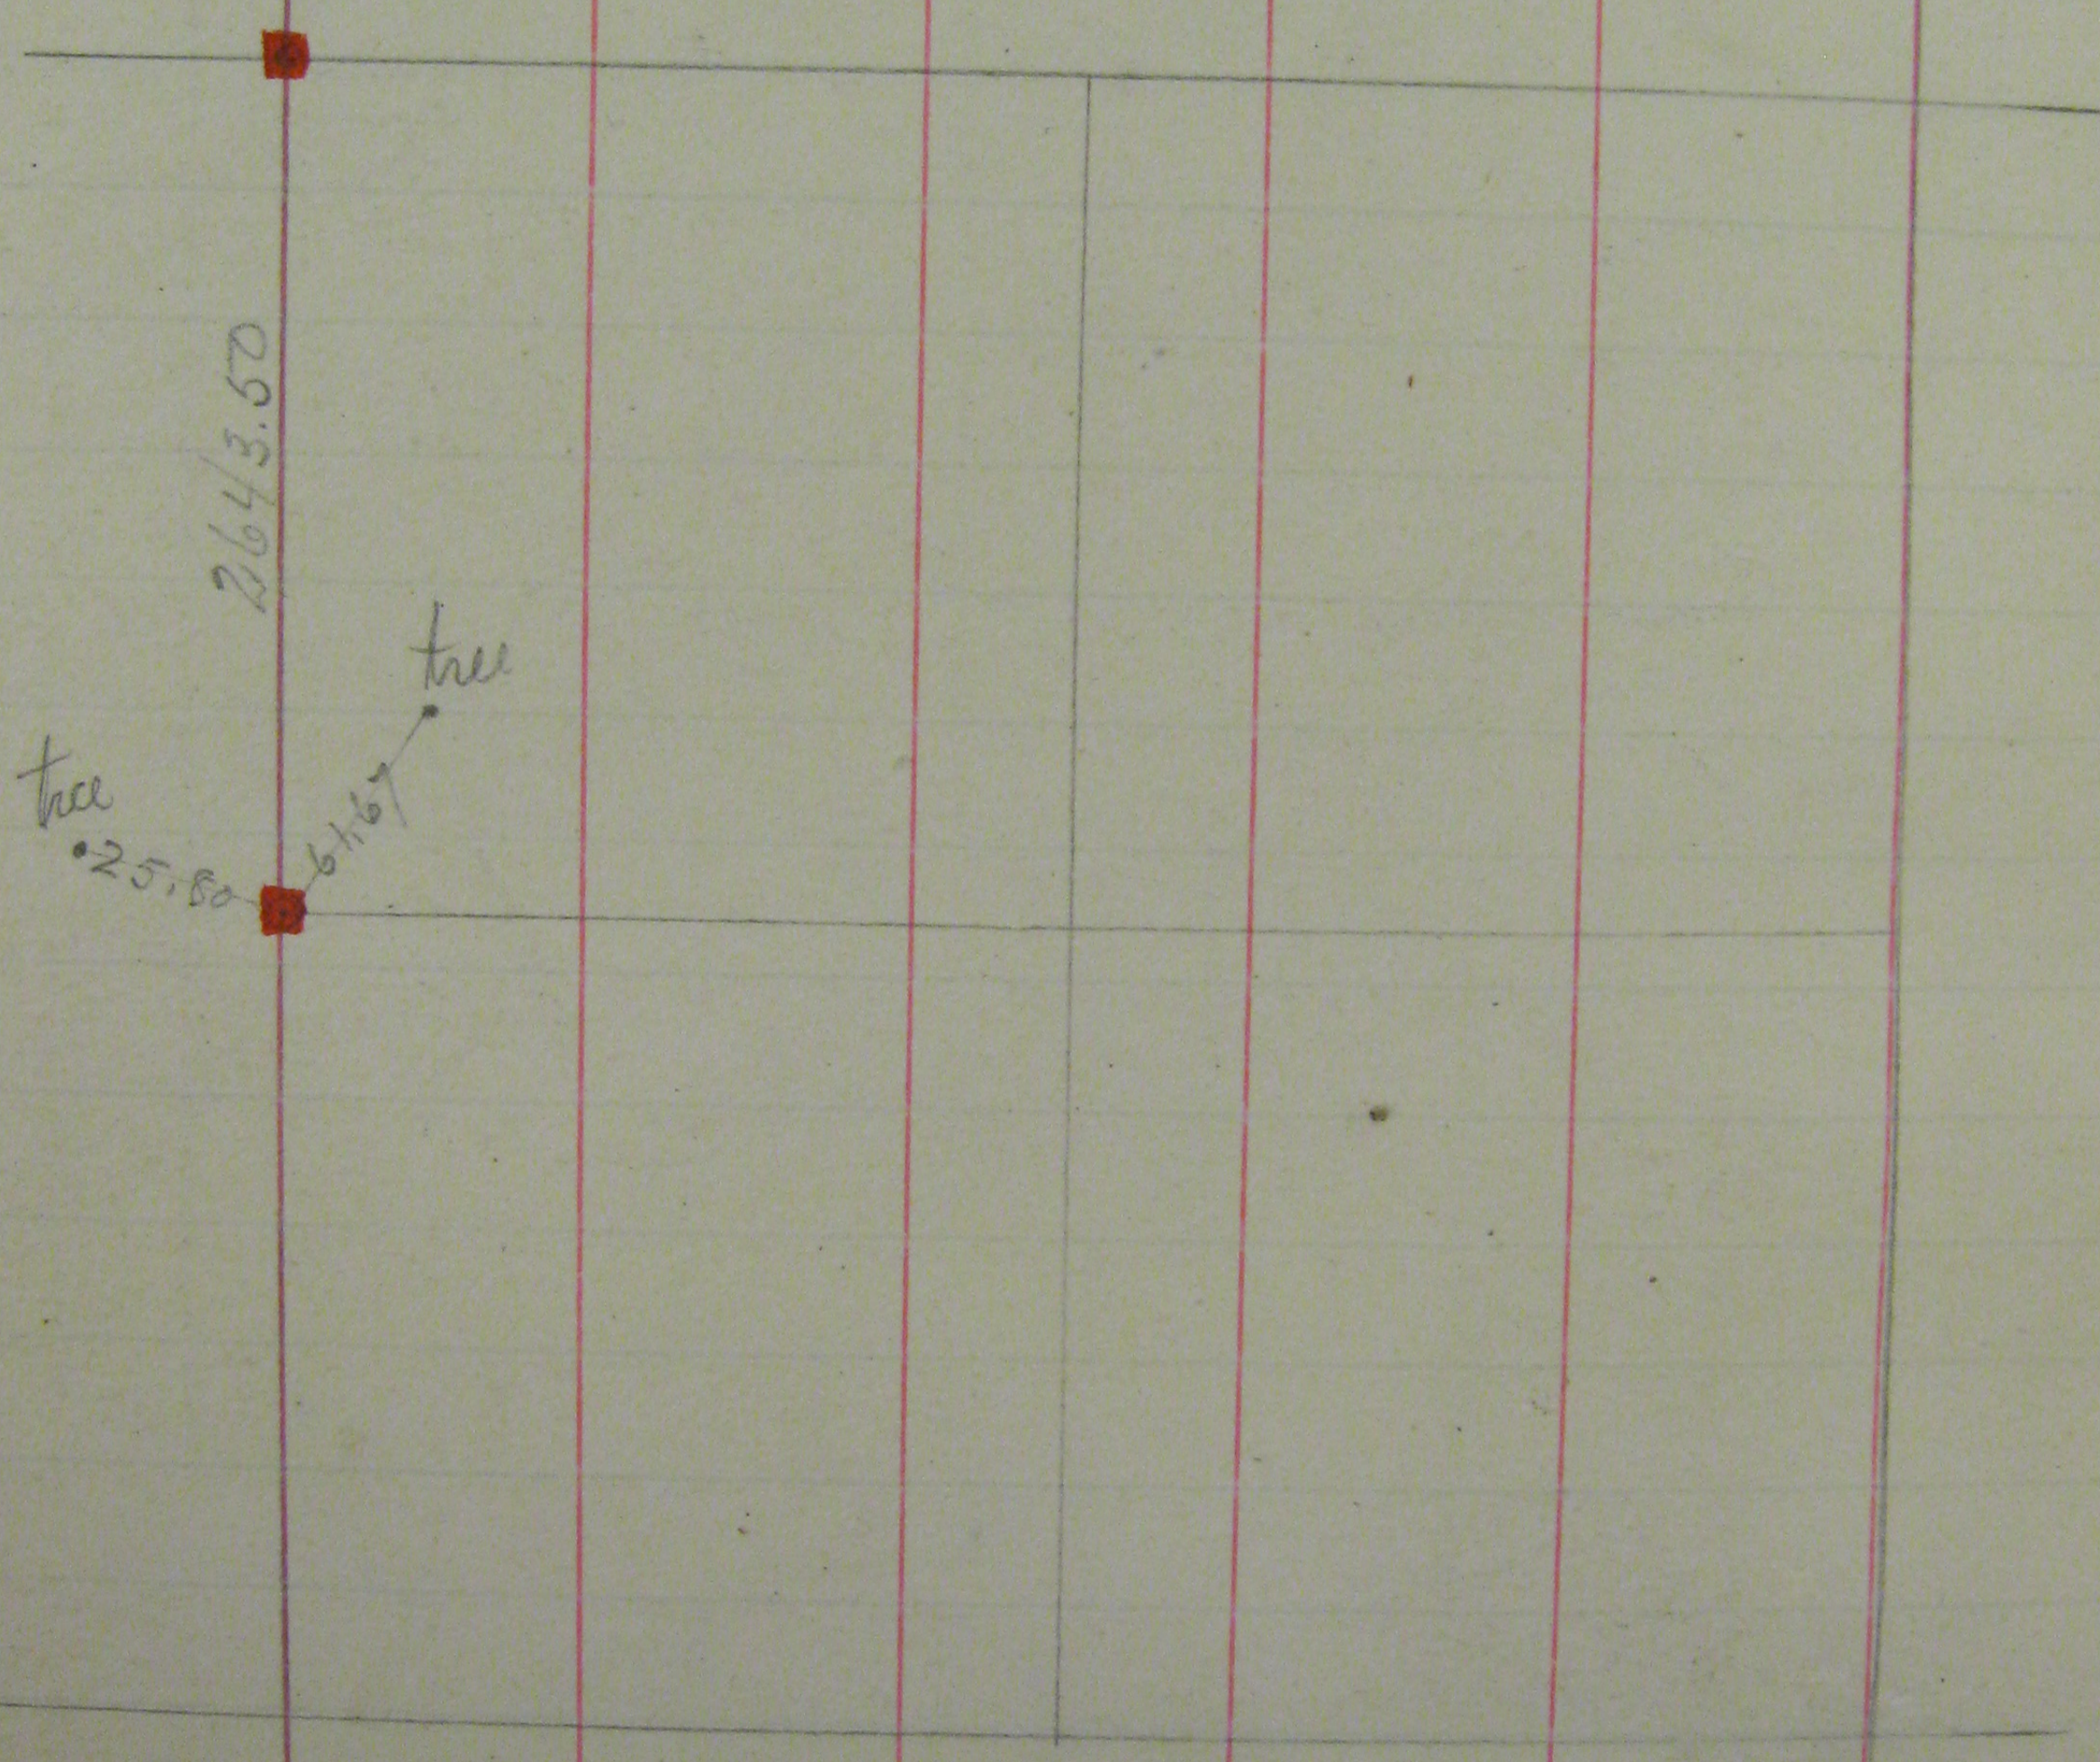

2643.50

tree
•25.80

tree
61.67