


Notes in Section 21 T30R23 Line run through center of 16 Section by Gates a Johnson Jan 7 1889

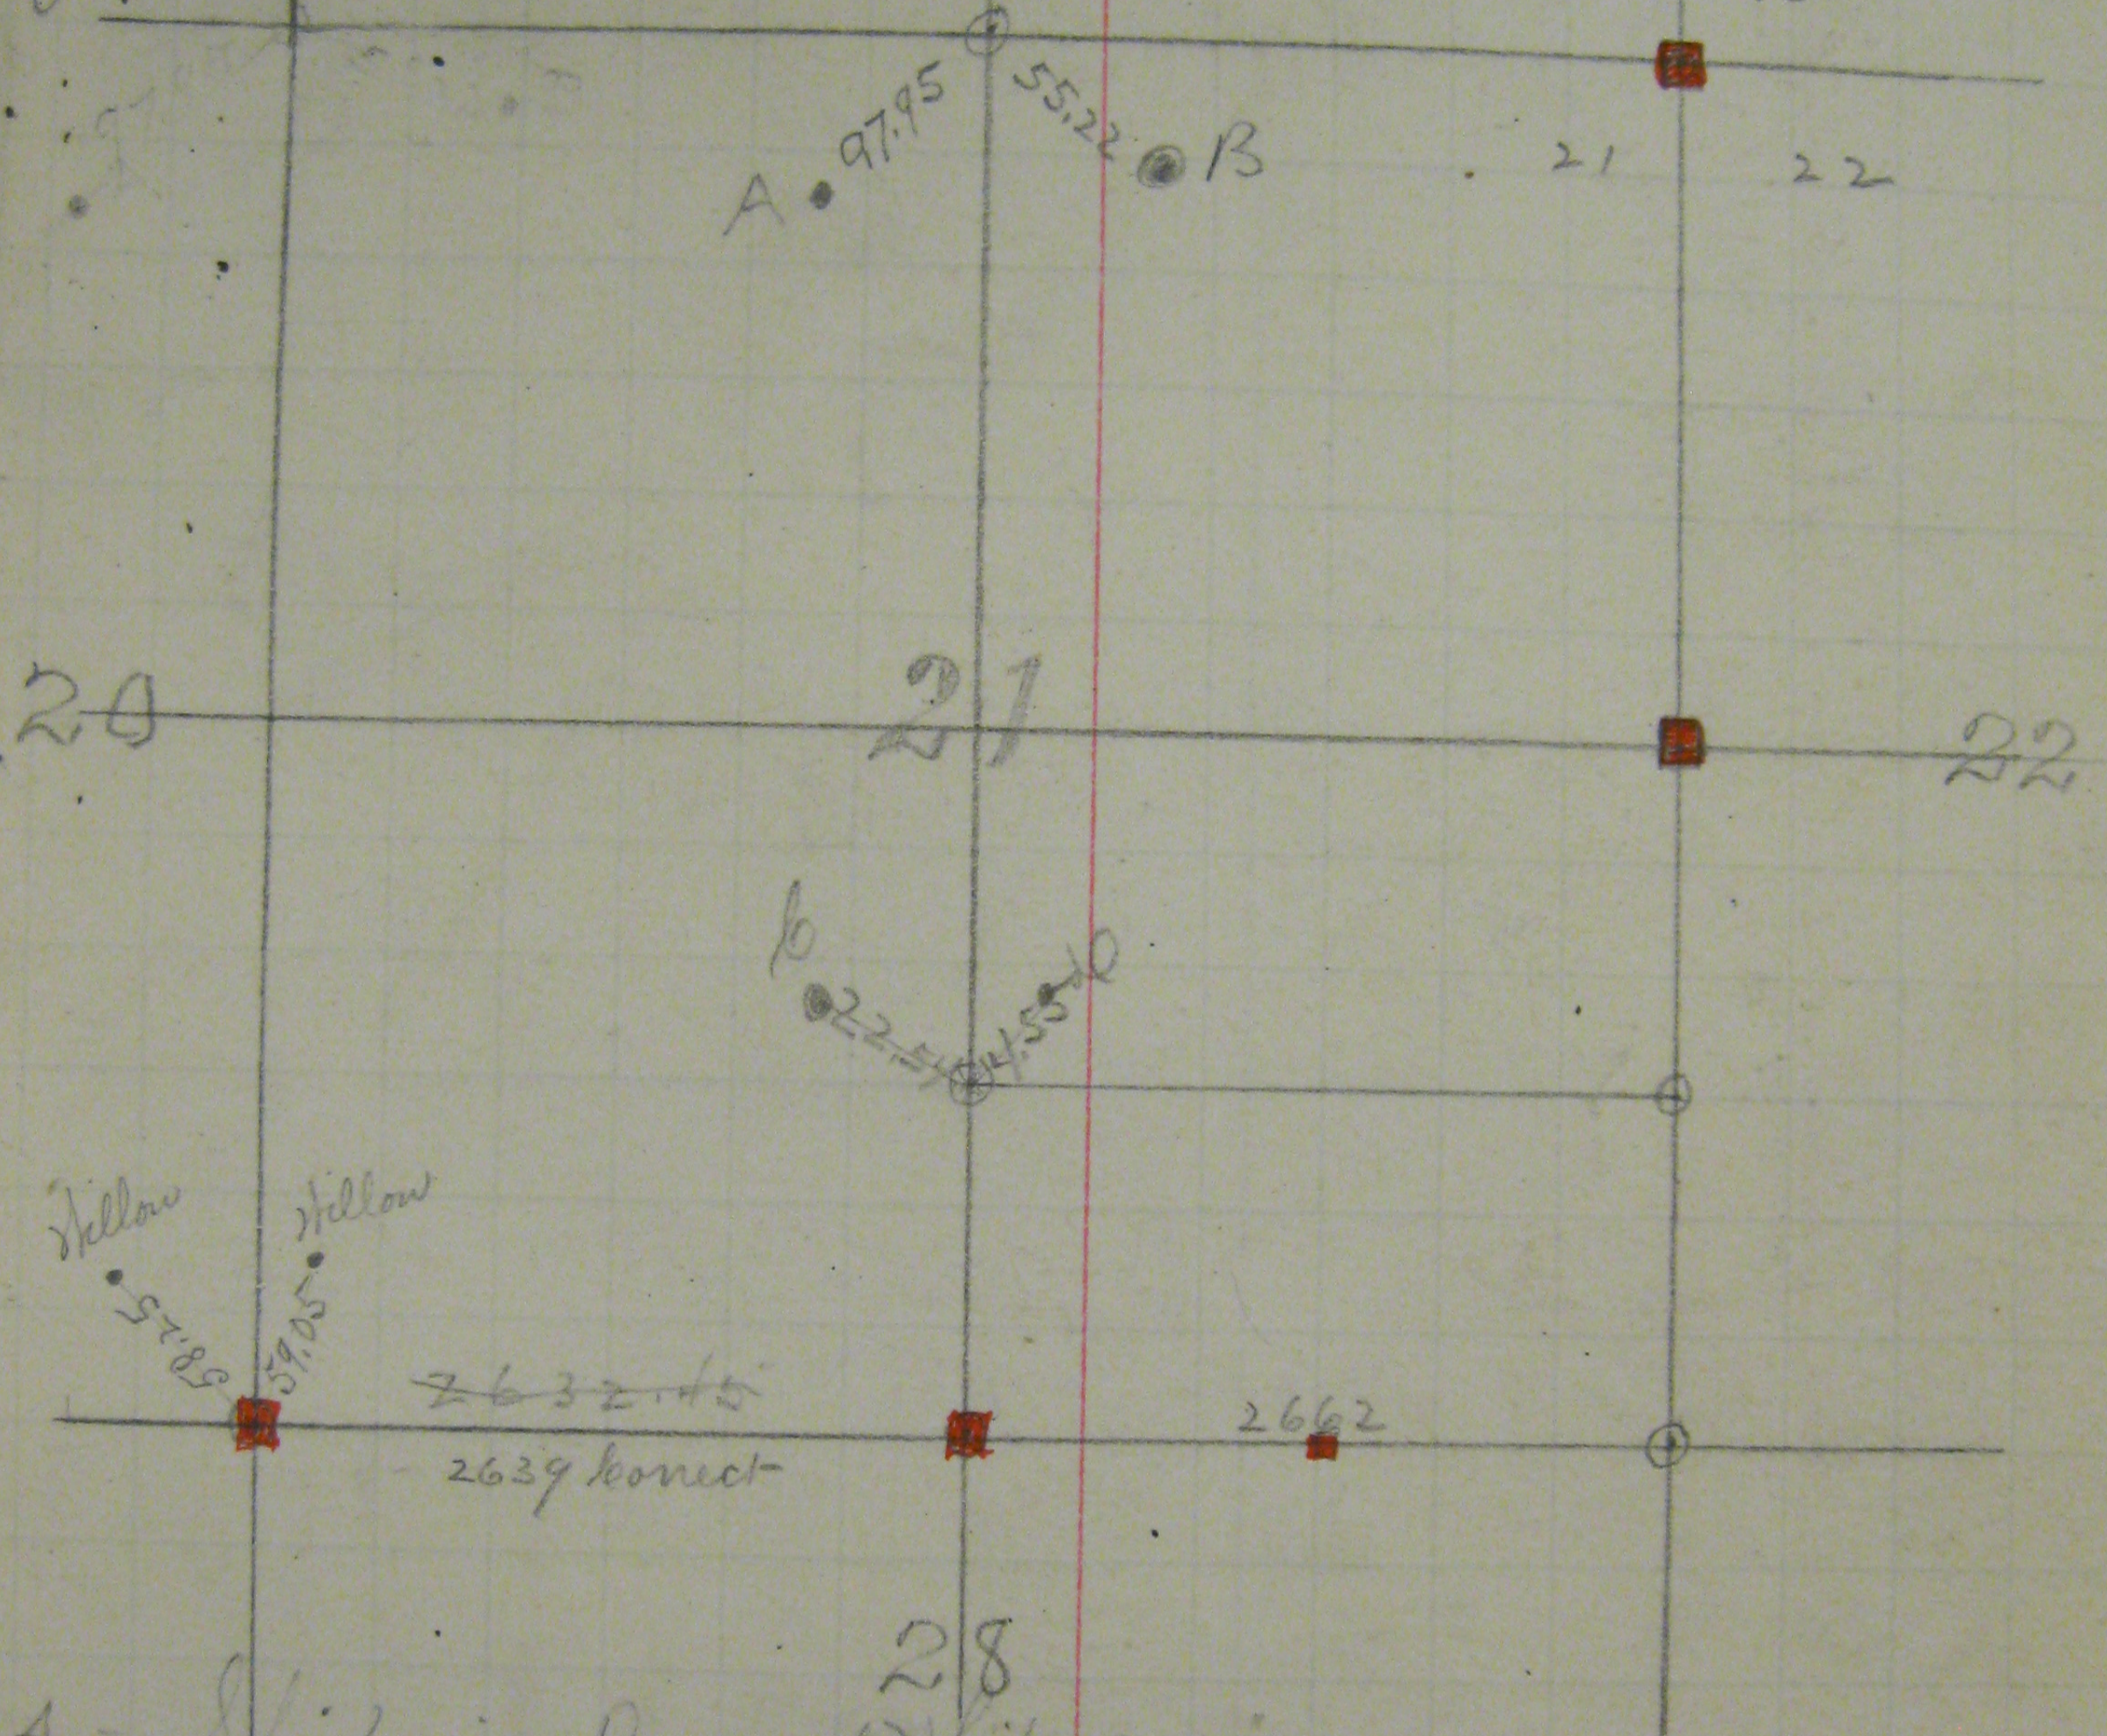

- A = Spike in Base of White (12) 97.95
- B = Spike in Base of P (5) 55.22
- C = Spike in Base of W (stump) (4) 22.54
- D = Spike in Base of Burned Stump 4.55