

SEC 1 T30N R23W

ANOKA CO.


Found granite monument in place at NW corner

"	"	"	"	"	"	NE	"
"	"	"	"	"	"	SW	"
"	"	"	"	"	"	E $\frac{1}{4}$	"
"	"	"	"	"	"	S $\frac{1}{4}$	"
"	"	"	"	"	"	E $\frac{1}{4}$	"
"	"	"	"	"	"	W $\frac{1}{4}$	"
"	"	"	"	"	"	Center of Section	

In establishing SE Cor. Sec 1, ran straight line north
along Range Line between Ranges 22 and 23 from SE cor.

SEC 13 to E $\frac{1}{4}$ cor. SEC 1. Government witness trees gone.

Established corner by single proportionment between the
two known corners mentioned above 1 Feb. 1950.

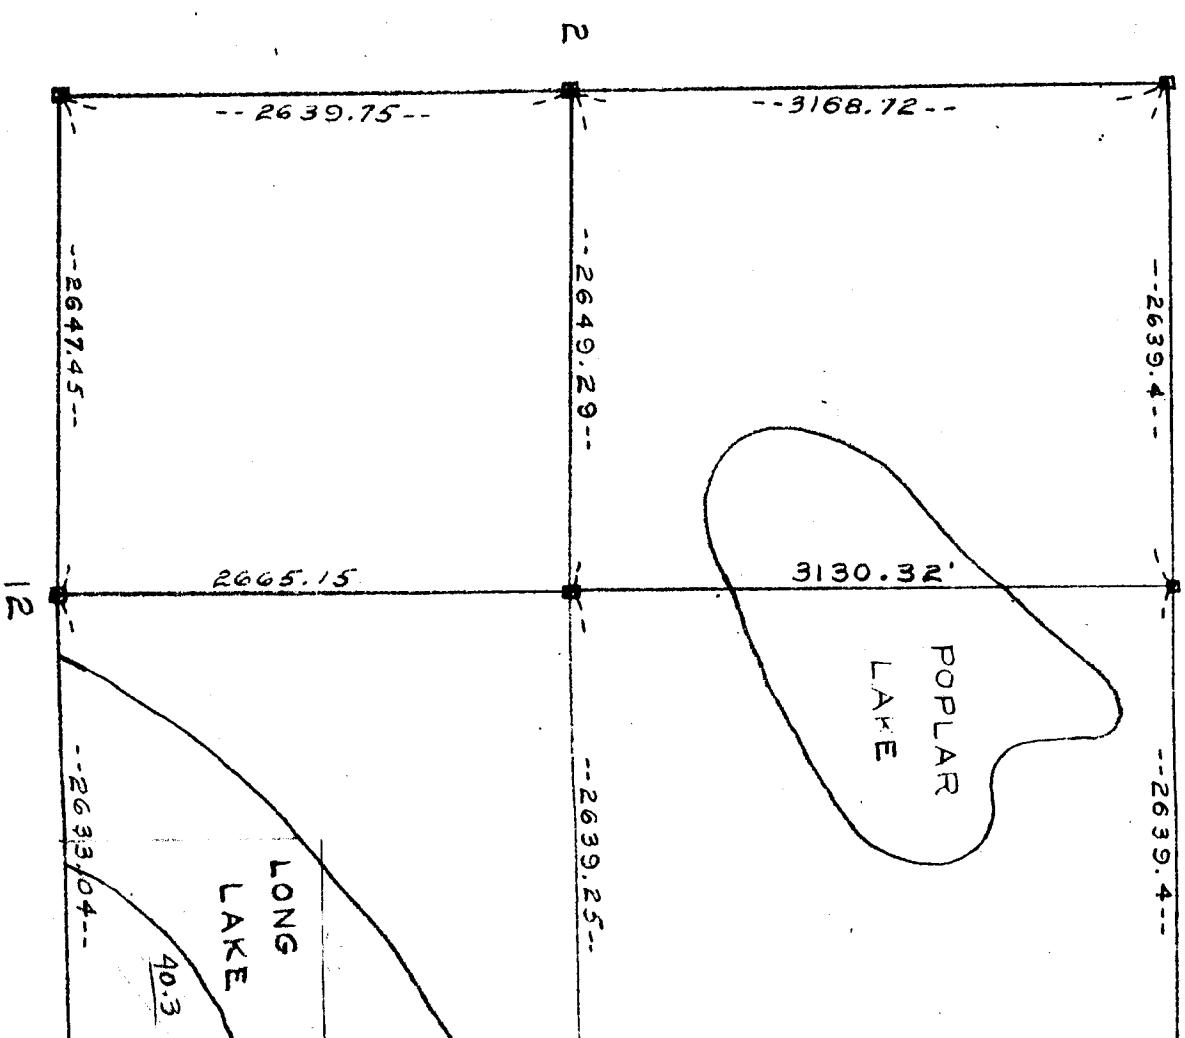

SEC 1 T30N R23W