

SEC 16 T30N R22W

Found granite monument in place at NE corner.


n n n n n SE n
n n n n n SW n
n n n n n W $\frac{1}{4}$ n
n n n n n E $\frac{1}{4}$ n
n n n n n W $\frac{1}{4}$ n
Iron n n n n n S $\frac{1}{4}$ n
n n n n n NW n

9

--2657.9--

--2650.85--

17

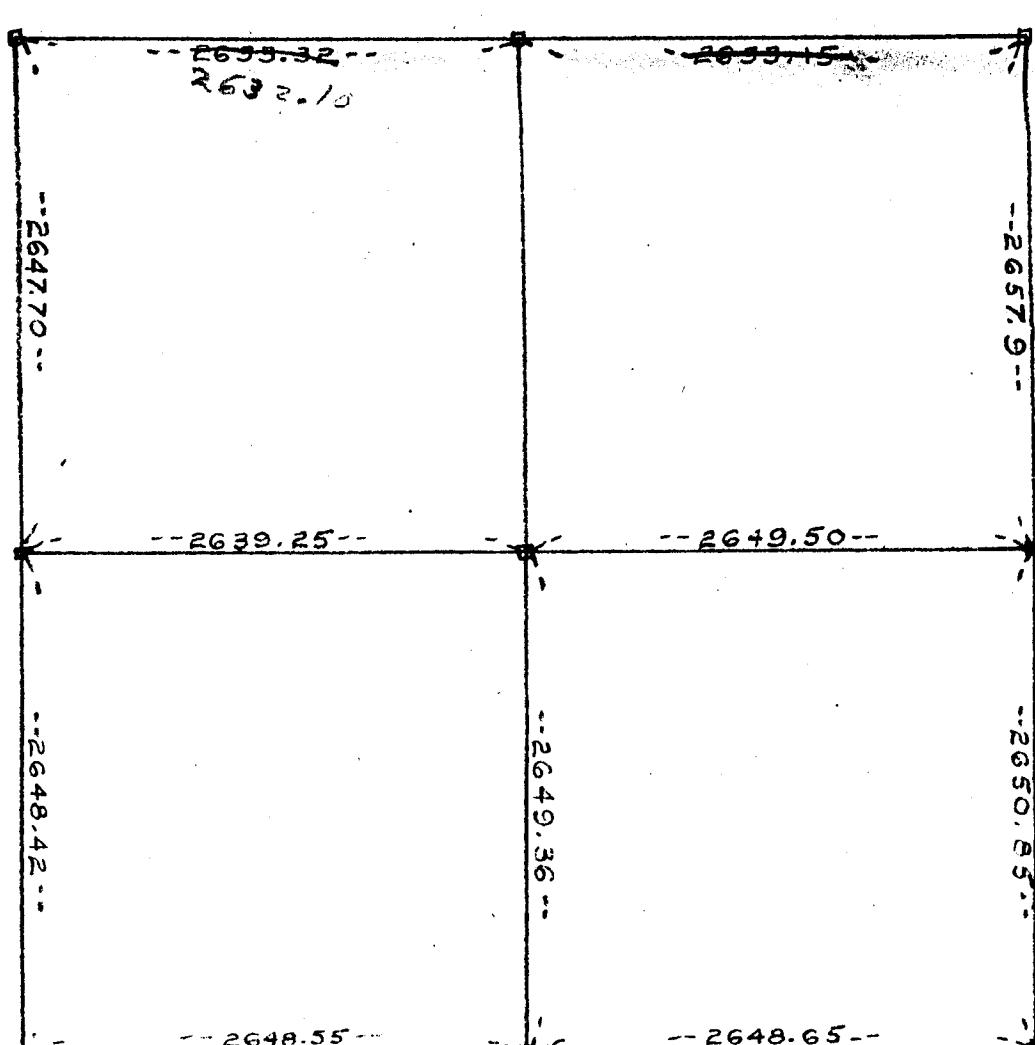

15

21

SEC 16 T30N R22W