

SEC 4 T30N R22W

Found granite monument in place at NW corner.


- " " " " " N $\frac{1}{4}$ "
- " " " " " S $\frac{1}{4}$ "
- " " " " " Center Sec. 4

For establishment of W $\frac{1}{4}$ cor., and SW cor. see Sec. 5

T30N R22W.

BK/C-9

ANOKA CO.

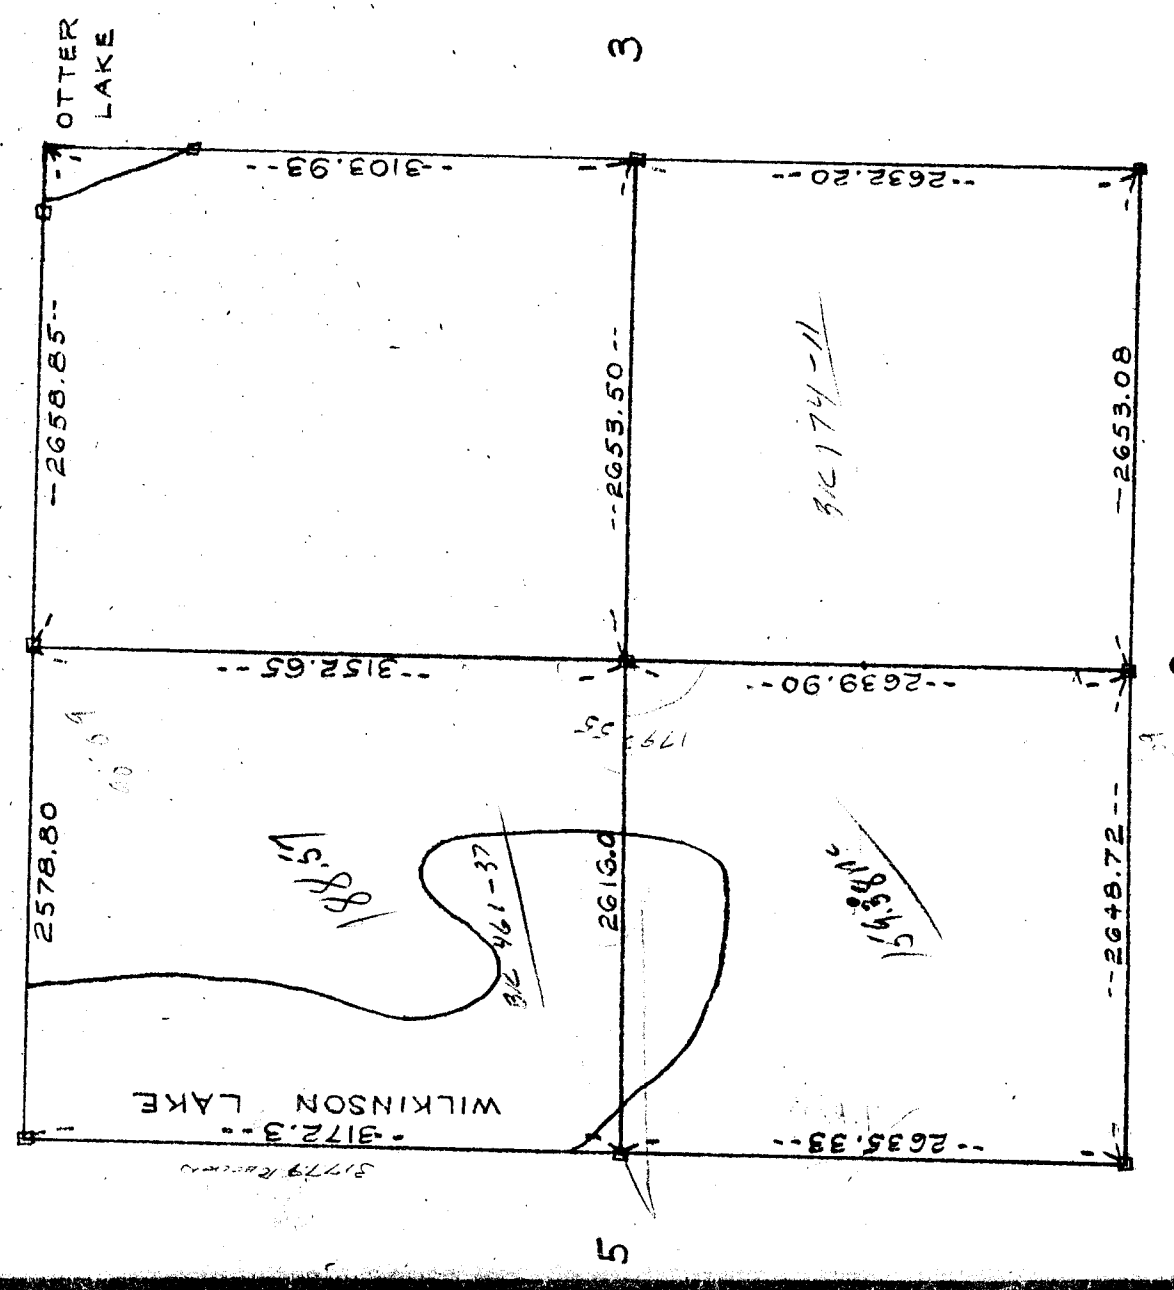

SEC 4 T30N R22W