


SEC 9 T30N R22W

Found granite monument in place at N $\frac{1}{2}$ corner.

"	"	"	"	"	S $\frac{1}{4}$	"
"	"	"	"	"	NE	"
"	"	"	"	"	E $\frac{1}{4}$	"
"	"	"	"	"	SE	"
"	"	"	"	"	Center of Sec. 9	"

For establishment of W $\frac{1}{2}$ cor. see SEC 8 T30N R22W.

Found iron monument in place at SW cor.

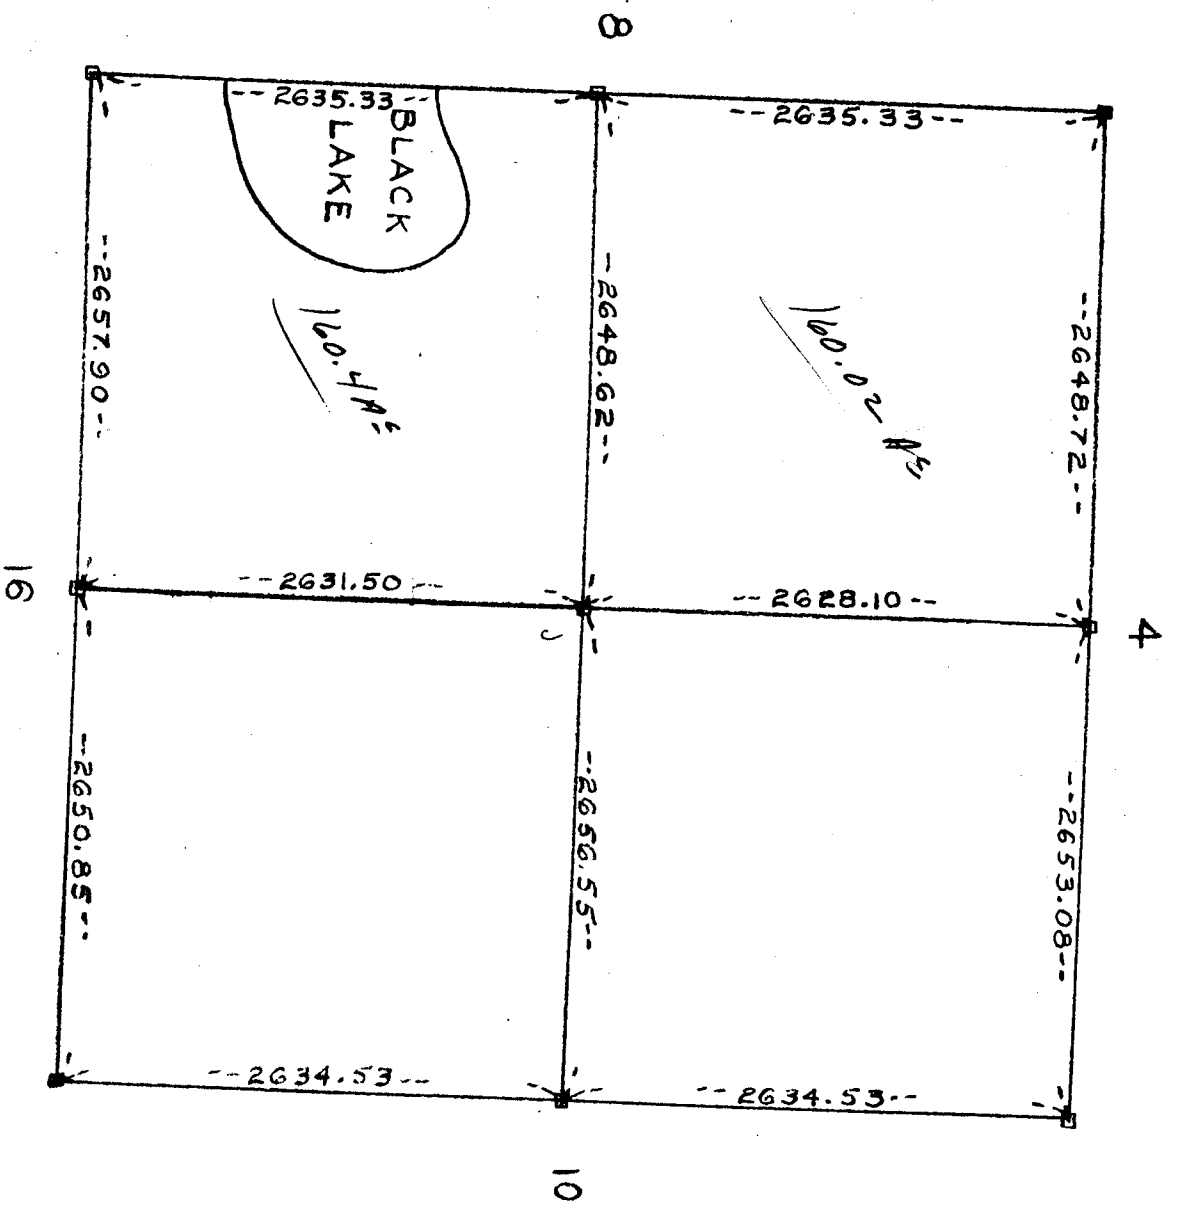

SEC 9 T30N R22W