


R23W | R22W

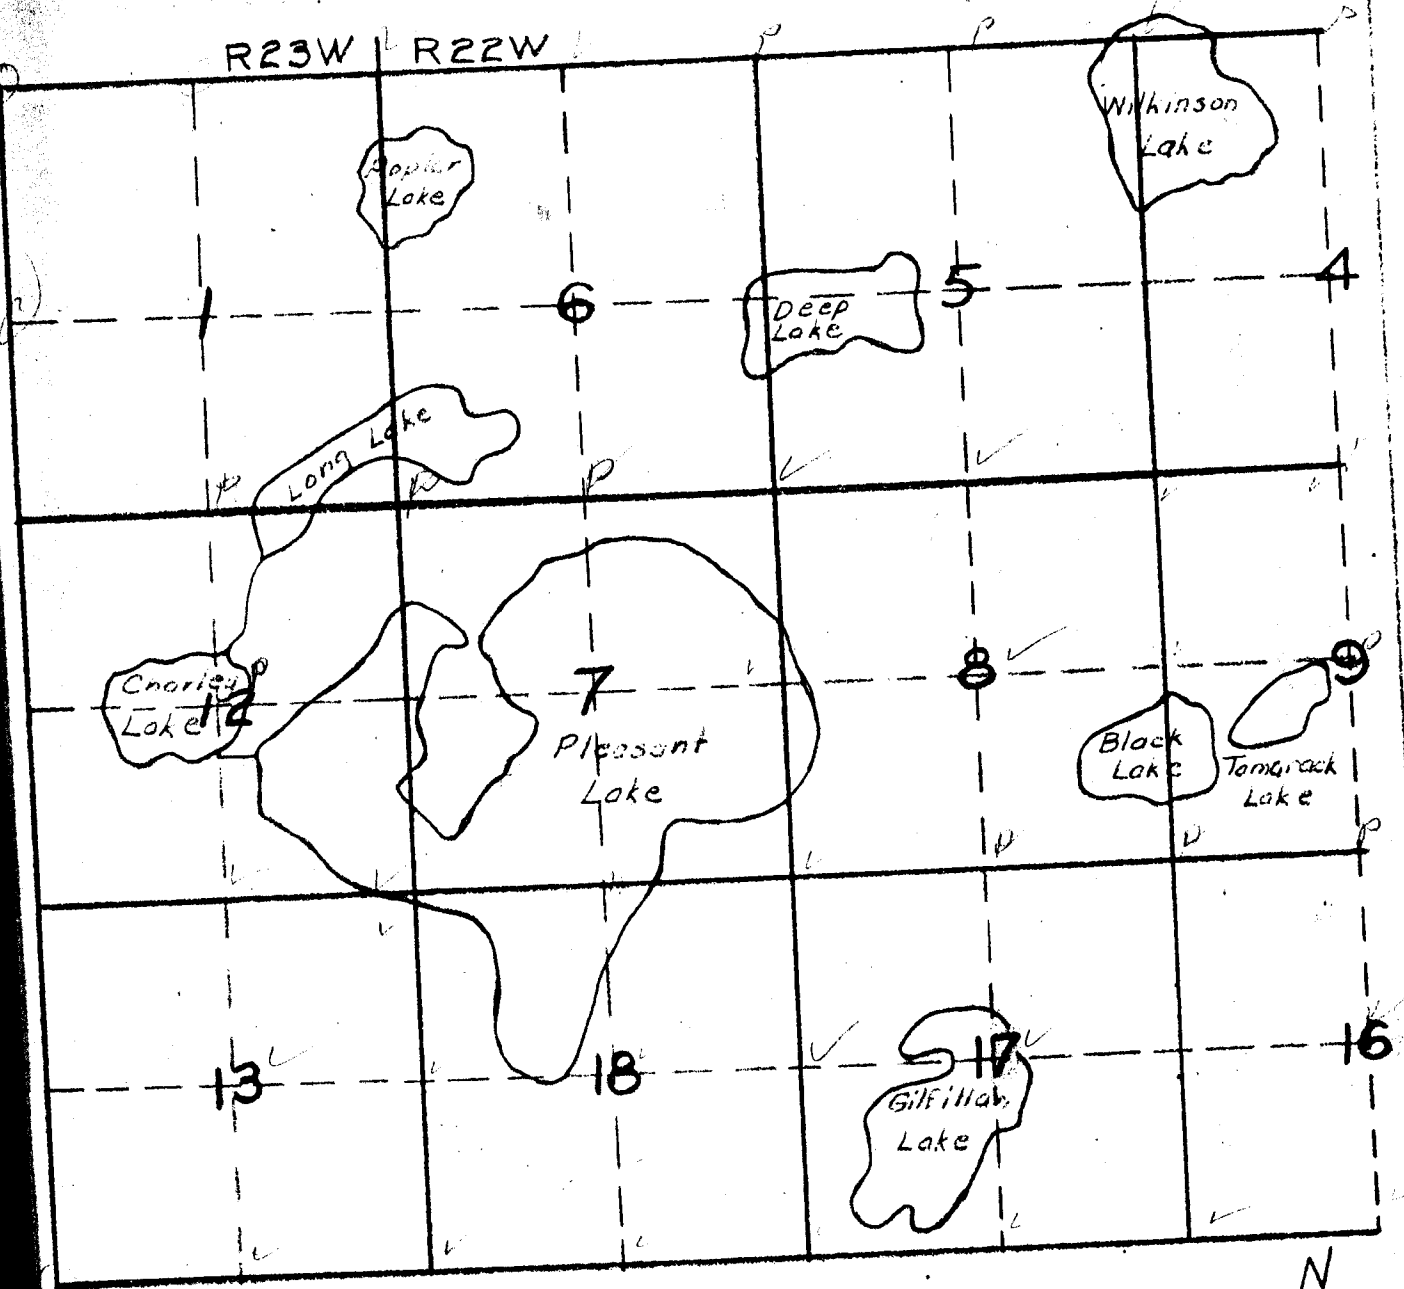

PROPERTY SURVEY

INDEX MAP
NORTH OAKS