Township No. 30 N Range No. 24 W 4th Mer.

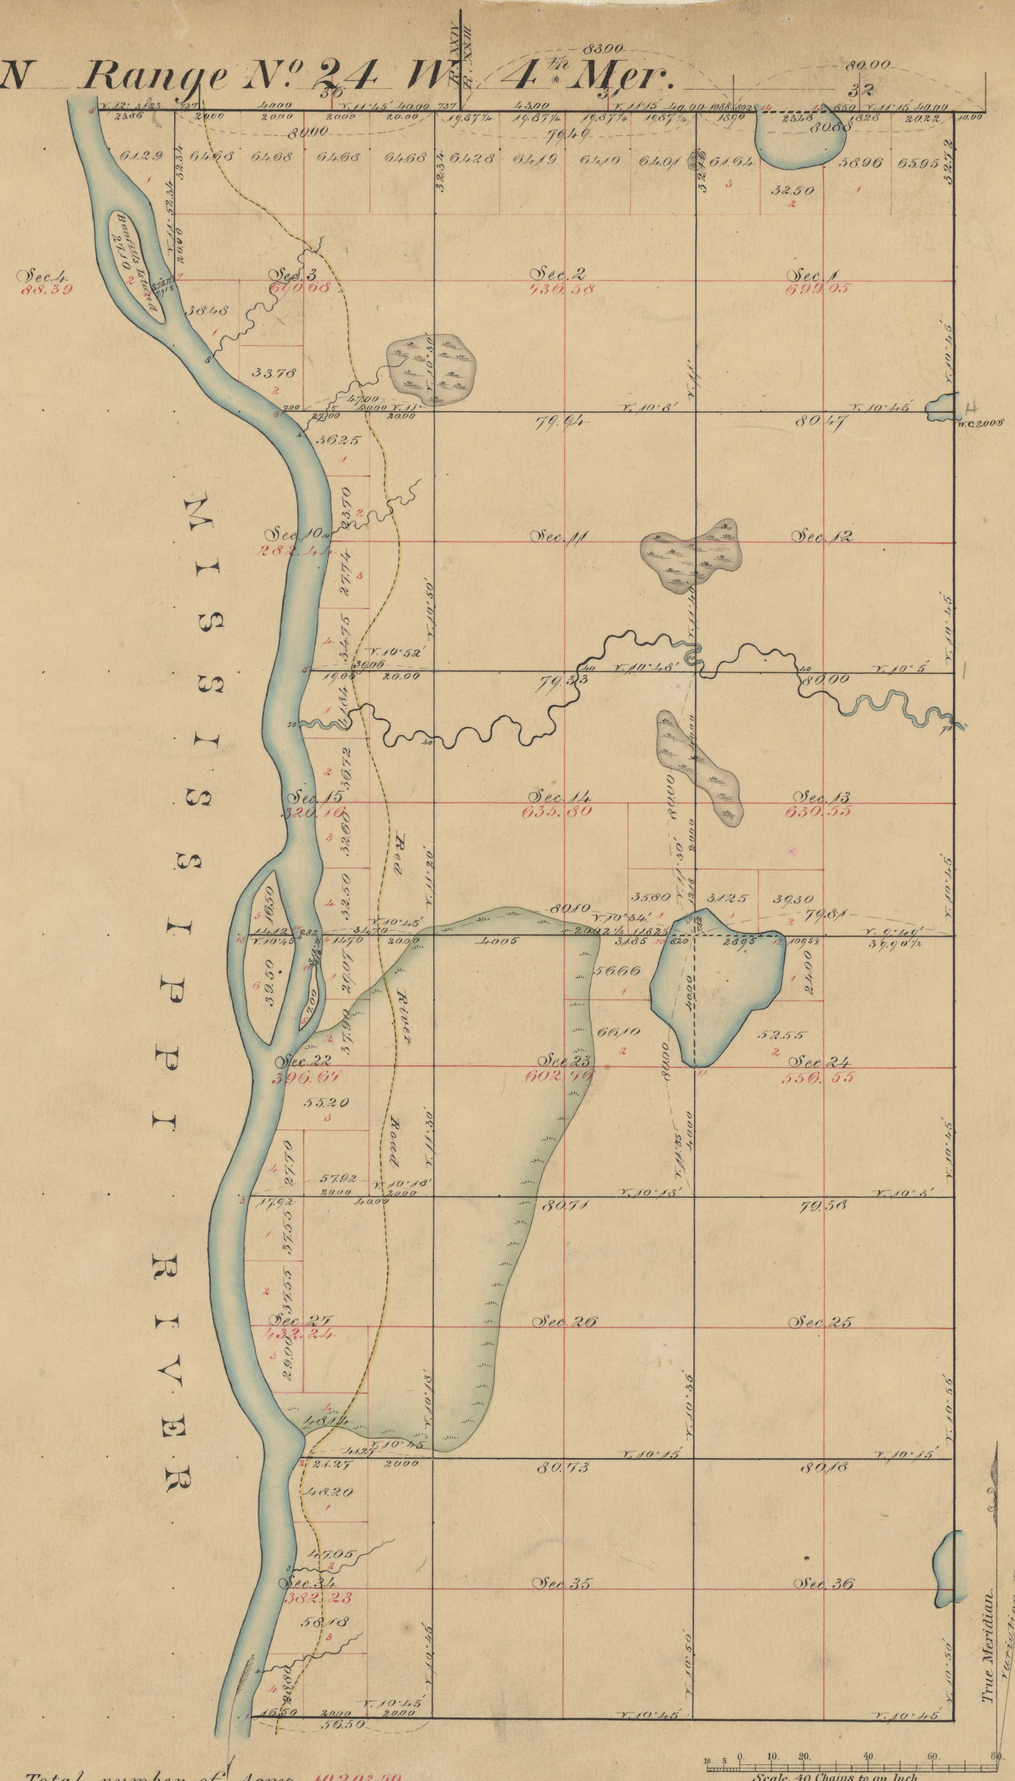

Total number of Acres 10203.90

Surveys Designated.	By Whom Surveyed.	Date of Contract.	Amount of Surveys. M.	Chs	Lks	When Surveyed.
Township lines, N	Henry A. Willse	May 22nd, 1847	3.	21.	23	August 1847
do S & E	James M. Marsh	May 22nd, 1847	8.	69.	22	October 1847
Subdivisions,	Isaac N. Higbee	Septh 3rd, 1847	34.	76.	58	Commenced / Completed Novbr, 1847

Meanders of

Posts.	Courses.	Chs Lks	Posts.	Courses.	Chs Lks	Posts.	Courses.	Chs Lks

The above Map of Township No. 30 N of Range No. 24 W 4th Principal Meridian, Minnesota is strictly conformable to the field notes of the survey thereof on file in this Office, which have been examined and approved.

Surveyor Generals Office,
St. Paul, May 3rd, 1872

Surv. Gen.l