


Township N^o 28 N Range N^o 22 West 4th Mer.

Meanders of											
Posts	Courses	Ch ^s Lk ^s	Posts	Courses	Ch ^s Lk ^s	Posts	Courses	Ch ^s Lk ^s	Posts	Courses	Ch ^s Lk ^s

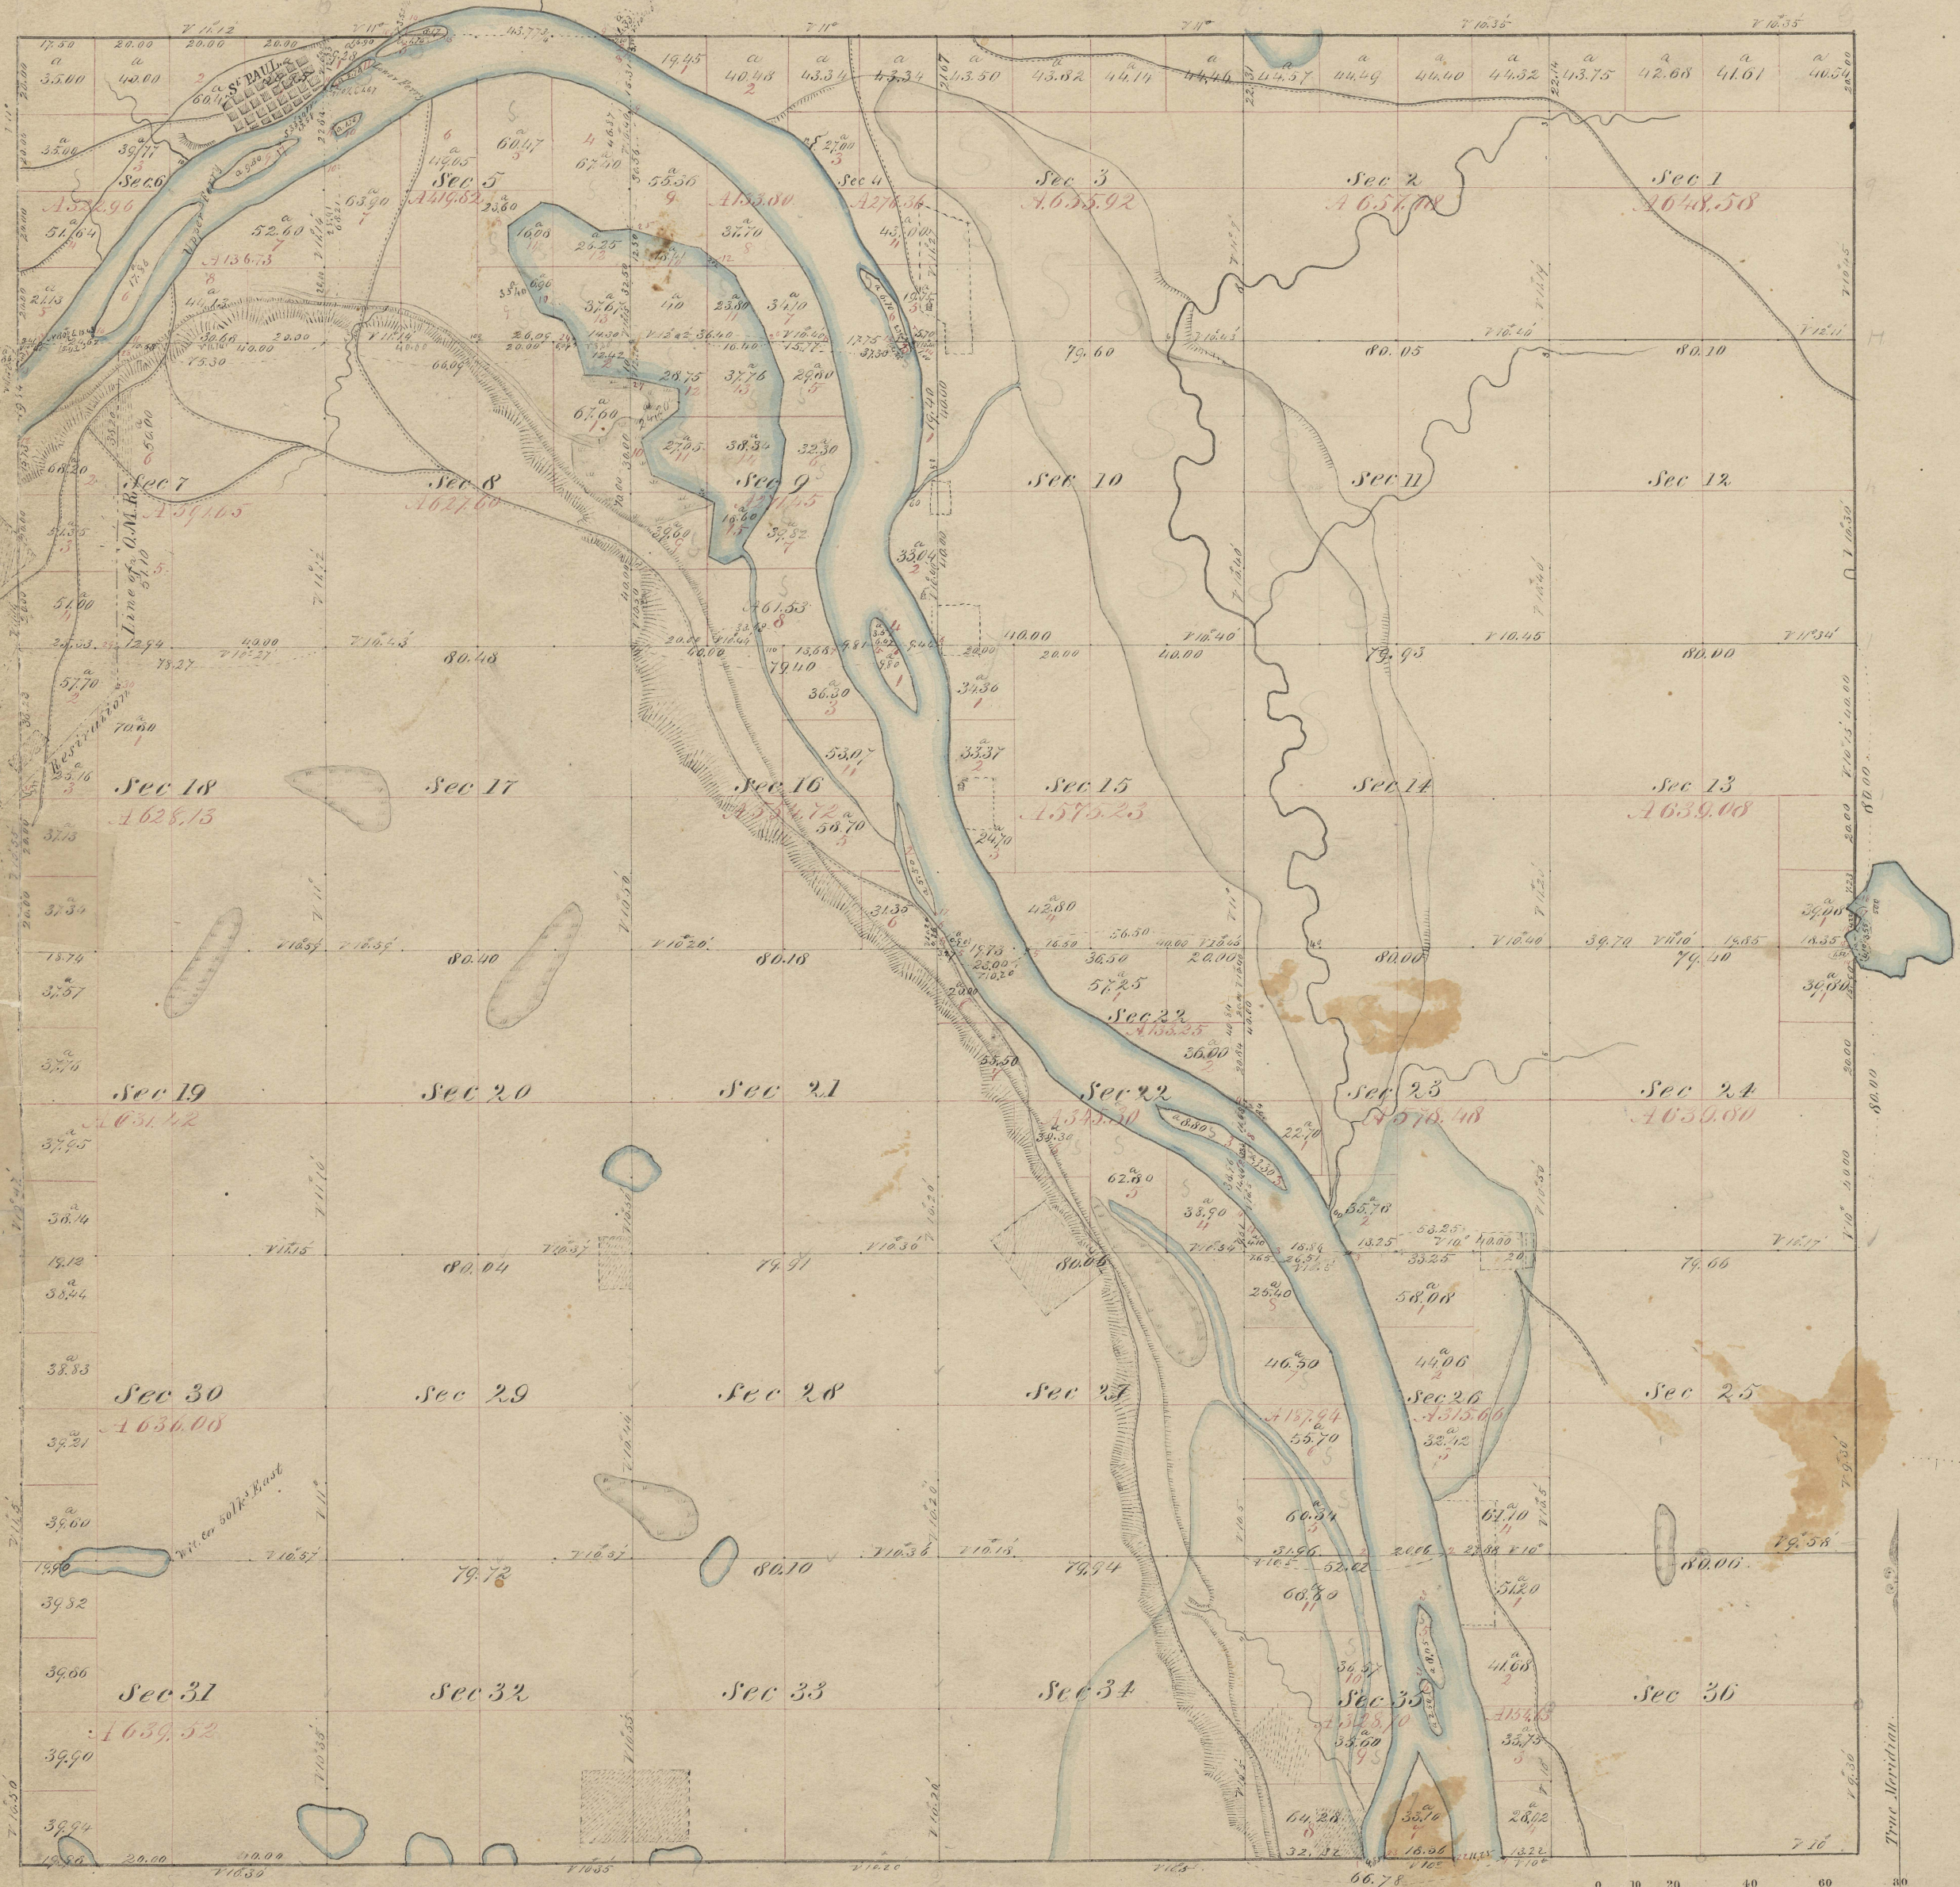

Surveys Designated.	By Whom Surveyed.	Date of Contract.	Amount of Surveys. A. Ch ^s Lk ^s	When Surveyed.	When Charged in the Sur ^o Gen ^l acc ^t
Township lines,					
Subdivisions,					

The above Map of Township N^o 28 N of Range N^o 22 West of the 4th Principal Meridian, is strictly conformable to the field notes of the survey thereof on file in this Office, which have been examined and approved.

Surveyor General's Office.

Sur^o Gen^l