Township N.o 29 N.; Range N.o 22 West 4th Mer.

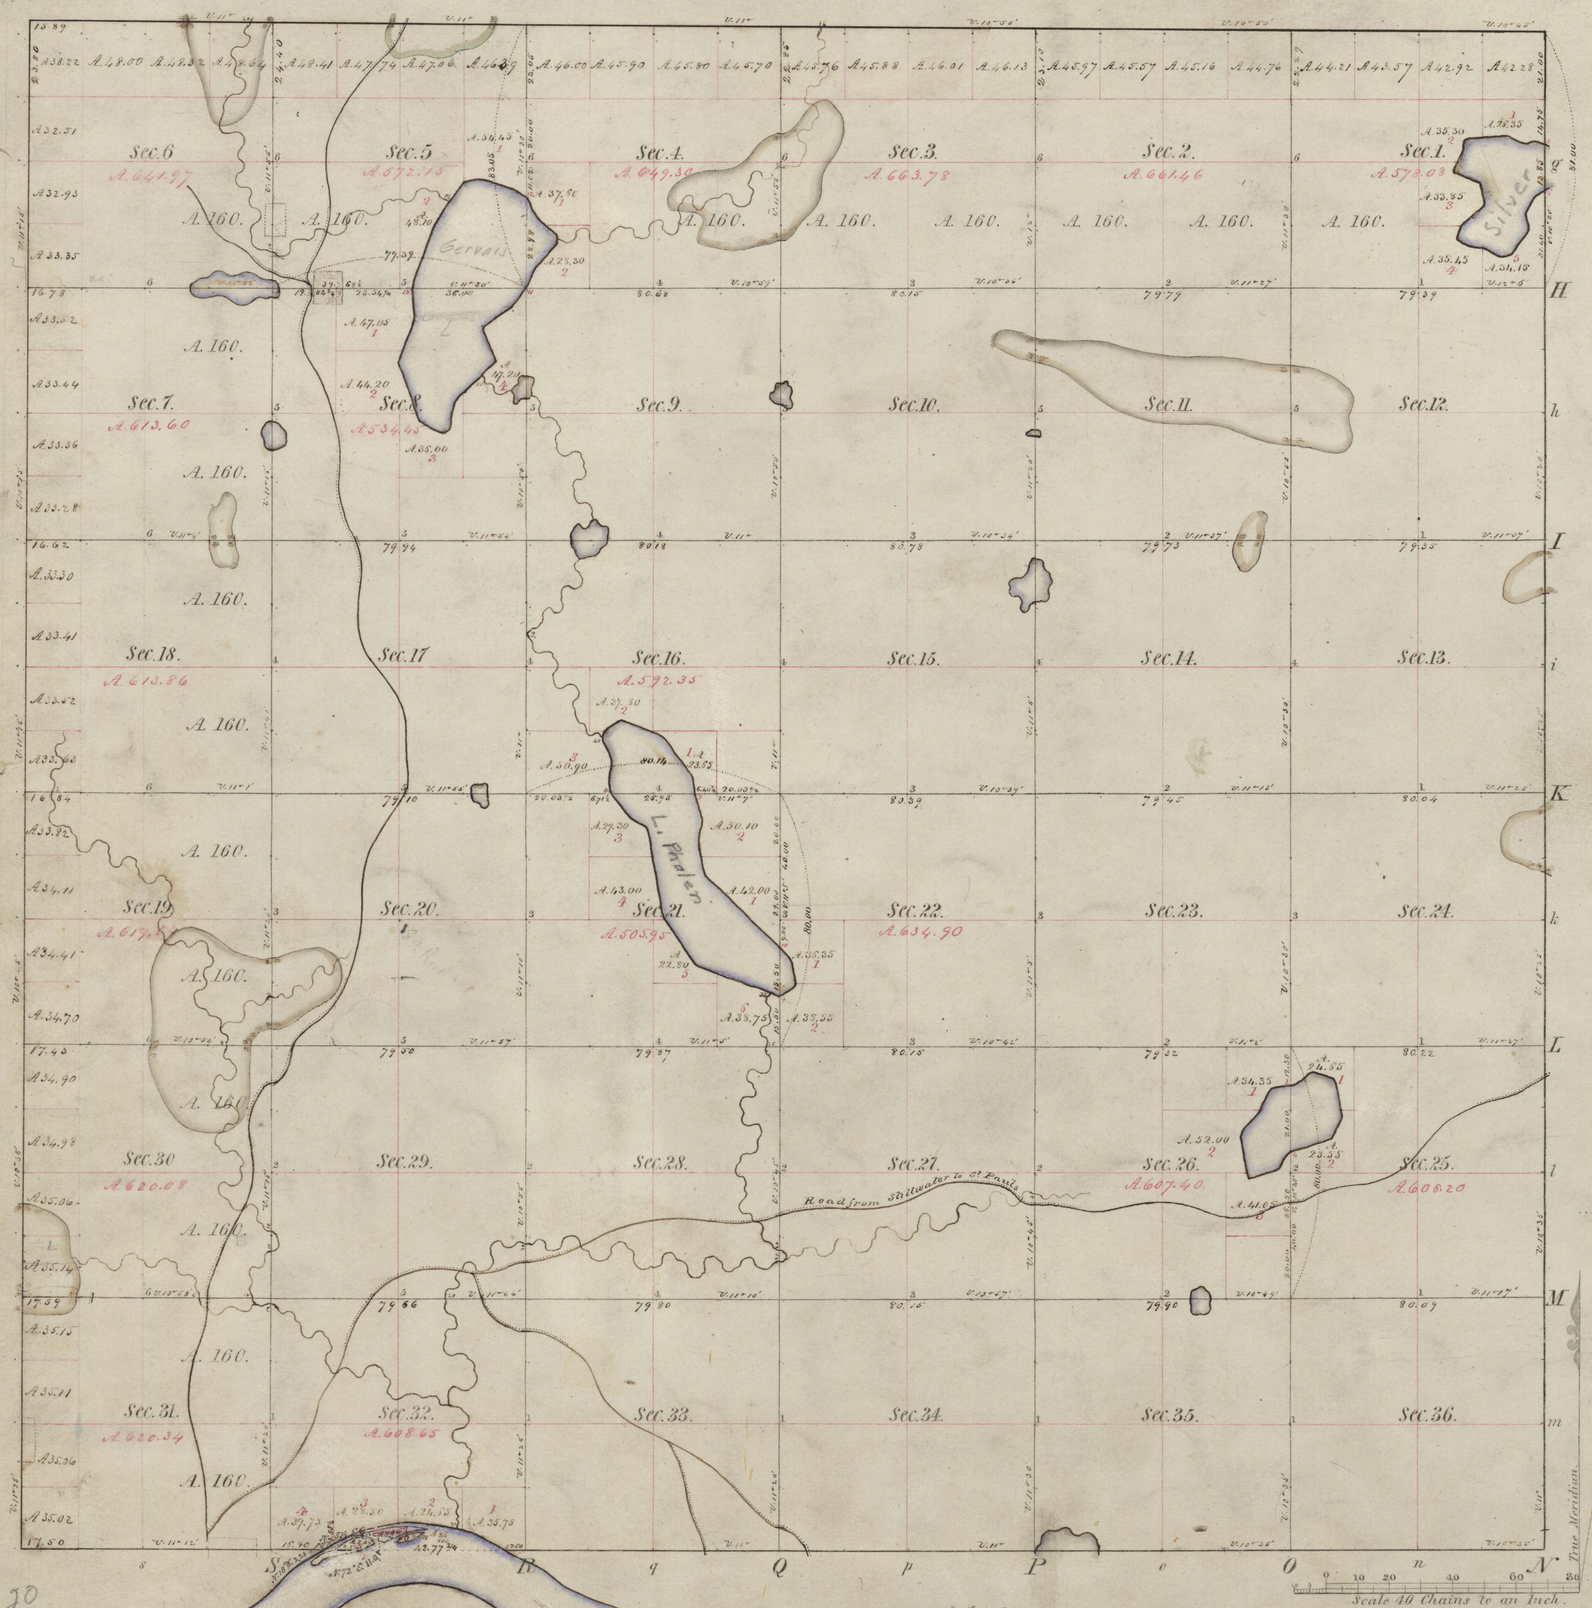

Total number of Acres. 23.463.56

Surveys Designated	By Whom Surveyed	Date of Contract	Amount of Surveys	When Surveyed	When p.d for and ch.d in the Surr. Gen.l Ys acc.t
			M. Ch.s Lks.		
Township lines	Horace McMarth	May 22.d 1847	23 - 78 - 19	October 1847	
Subdivisions	Isaac N. Higbee	September 3.d 1847	68 - 70 - 12	November 1847	

The above Map of Township N.o 29 North of Range N.o 22 West of the 4th Principal Meridian Wisconsin Territory is strictly conformable to the field notes of the survey thereof on file in this Office, which have been examined and approved.

Surveyor Generals Office, Dubuque March 16th 1848.

Geo. W. Jones Surr. Gen.l

Meanders of Lakes & Mississippi River

Posts	Courses	Ch.s Lks.	Posts	Courses	Ch.s Lks.	Posts	Courses	Ch.s Lks.
	Left bank, up stream		5	N. 43¾° W.	4.26			
1	N. 60¾° W.	11.00		N. 47° W.	31.00			
	N. 79° W.	11.00		N. 18° W.	10.00			
	West	10.00		N. 2° W.	4.00			
	S. 82° W.	5.00		N. 16° E.	5.00			
	S. 75° W.	7.50	7	N. 15½ W.	9.80			
	S. 67° W.	9.00						
2	S. 61° W.	5.09		Lake in Sec.s 4, 5 & 8				
	Lake in Sec.s 25 & 26		11	N. 24½° E.	5.00			
				N. 40° E.	12.00			
3	S. 83° W.	6.00		N. 34° W.	8.50			
	S. 24° W.	7.50		N. 44¼° W.	10.00			
	S. 46¾° W.	7.50	12	N. 83¼° W.	5.52			
	S. 19¾° W.	3.52						
	S. 10° E.	13.50		N. 61¾° W.	6.50			
	N. 75° E.	10.00		N. 74¾° W.	10.00			
4	N. 34¾° E.	6.42		S. 79¾° W.	5.00			
				S. 33¾° W.	17.00			
	N. 71¾° E.	13.50	13	S. 1° W.	20.50			
	N. 20¾° E.	8.00						
	N. 11¾° W.	11.50		S. 3¾° E.	10.00			
	N. 78¾° W.	7.00		S. 19° W.	15.00			
	S. 57° W.	5.50		S. 20° E.	7.00			
5	S. 67¾° W.	2.74		S. 16° E.	13.00			
				S. 72° E.	7.50			
	Lake in Section 1			N. 69¾° E.	3.00			
				N. 12° E.	2.50			
6	N. 66° W.	2.50		N. 45¾° E.	18.00			
	S. 70° W.	4.00		N. 81¾° E.	11.50			
	N. 66° W.	7.50		N. 58° E.	11.50			
	S. 85° W.	12.34		N. 83¾° E.	7.50			
	S. 13° W.	4.00						
	S. 22° W.	6.50						
	S. 65¾° E.	9.50	Total	8	72	01		
	S. 17° E.	6.00						
	S. 46¾° W.	10.00		Meanders of Island in Section 32				
	S. 20° W.	4.50						
	S. 71° E.	4.00						
	S. 20° E.	5.00	3	N. 73° E.	4.30			
	S. 64¾° E.	6.00		N. 15° 45' W.	.82			
	N. 80° E.	4.00		N. 74° W.	3.40			
	N. 54° E.	9.50		S. 86° 45' W.	2.02			
	N. 14¾° W.	5.00		S. 47° 30' W.	1.20			
	N. 3° E.	6.50		S. 61° 30' W.	2.62			
6	N. 59° E.	3.51	4	S. 47° 30' W.	1.11			
	Lake in Sec.s 15, 21 & 22			Meanders of Mill Island in Section 32.				
7	N. 5° W.	4.00						
	N. 36° W.	17.50	5	N. 70° E.	3.56			
	N. 67½° W.	12.00		N. 33° E.	4.20			
	S. 70° W.	5.50		S. 60¾° W.	3.52			
	S. 45° W.	3.00		S. 79° W.	5.76			
	S. 5° E.	2.00	5	N. 46½° E.	1.44			
	S. 20° E.	6.50						
	S. 5° W.	7.50		Meanders of Island in Section 32.				
8	S. 18° E.	3.24						
	S. 32° E.	10.00	6	S. 79¾° E.	7.44			
	S. 62° E.	5.50		N. 63½° E.	7.42			
	S. 10° E.	29.50		N. 84½° E.	7.40			
	S. 54° E.	19.00		N. 81° W.	7.82			
9	S. 70° E.	28.09		S. 82½° W.	7.40			
				S. 76½° W.	4.46			
	N. 57° E.	6.00		S. 70¼° W.	2.22			
	N. 18° W.	9.50	6	S. 15½° W.	1.30			

Concluded on page 22










