


Township N^o 28 N, Range N^o 21 West 4th Mer.

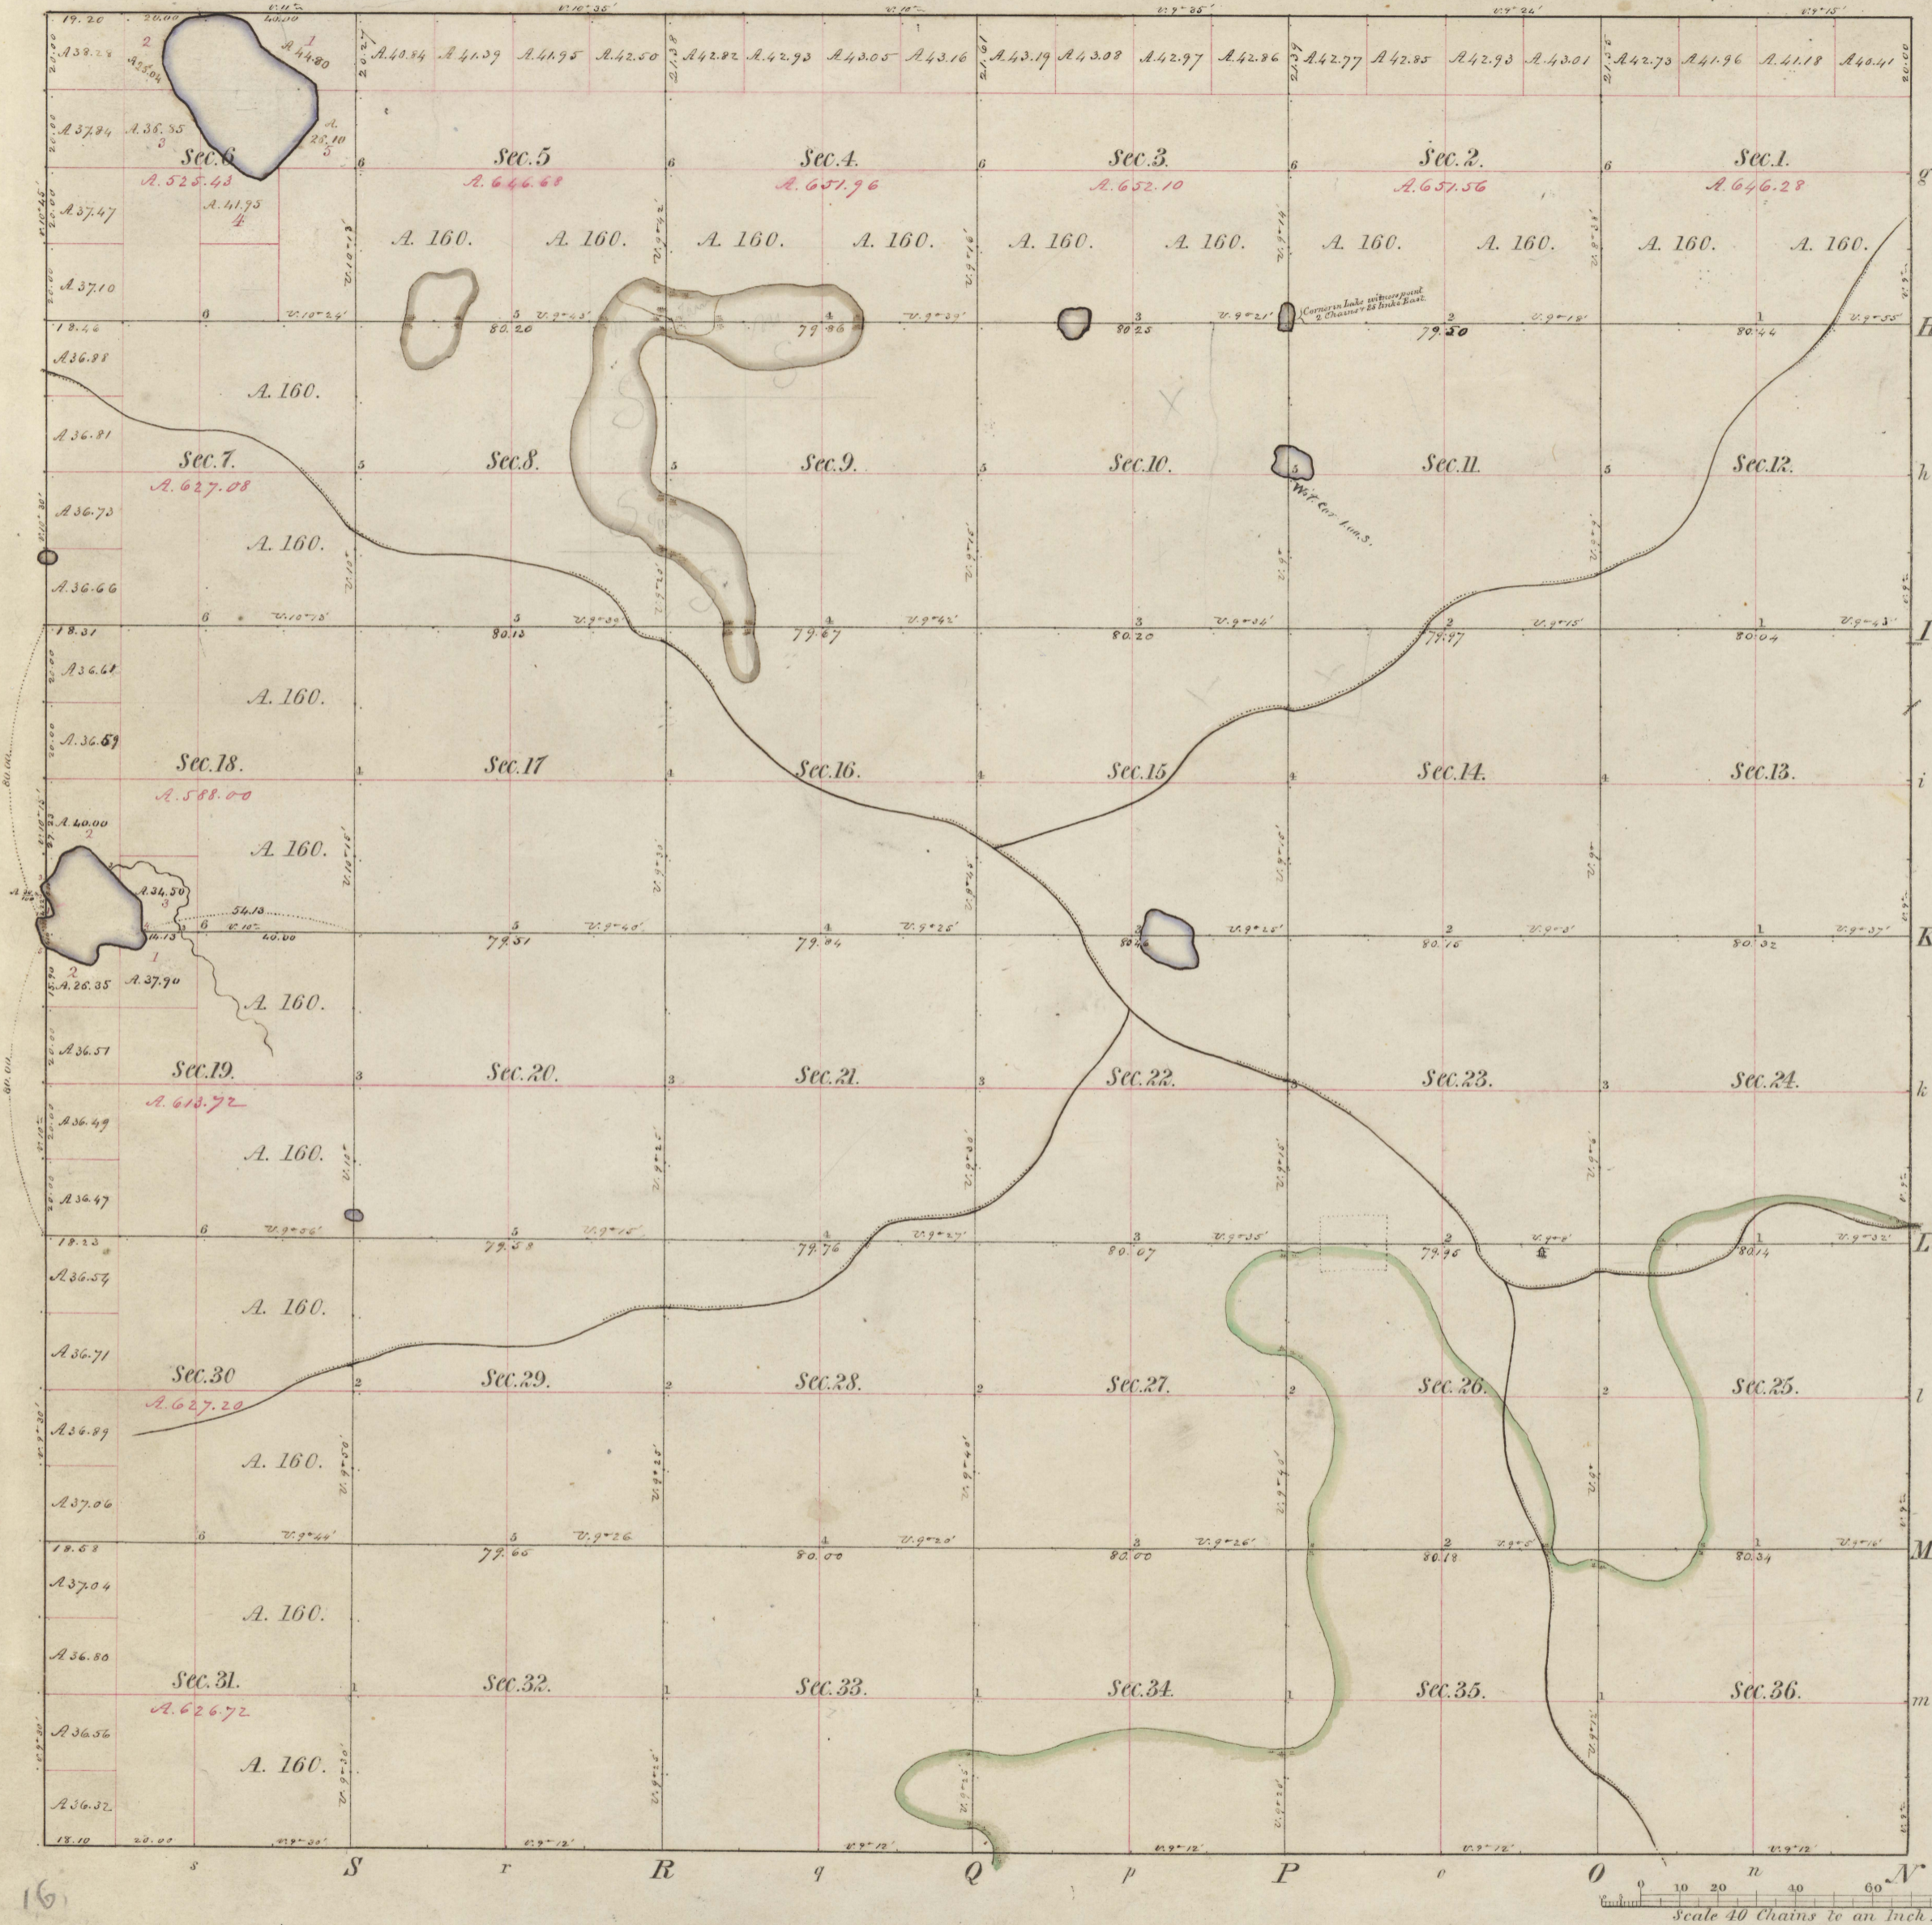

Meanders of 2 Lakes								
Posts	Courses	Ch ^o Lk ^s	Posts	Courses	Ch ^o Lk ^s	Posts	Courses	Ch ^o Lk ^s
Lake in Sec ^s 18, 19								
1	N 77 ^o E	1.40						
2	S 20 ^o W	4.25						
3	N 45 ^o E	2.50						
	N 21 ^o E	6.50						
	N 25 ^o E	2.00						
	N 71 ^o E	3.00						
	N 61 ^o E	2.00						
	S 42 ^o E	9.00						
	S 40 ^o E	2.50						
	S 51 ^o E	5.50						
4	S 24 ^o E	7.50						
	S 10 ^o E	2.00						
	S 60 ^o W	4.00						
	S 20 ^o W	7.50						
	S 60 ^o W	1.50						
	S 25 ^o W	1.00						
	S 15 ^o E	3.50						
	S 60 ^o W	2.00						
	N 70 ^o W	7.00						
5	N 65 ^o W	5.05						
Lake in Sec 5								
1	S 85 ^o W	2.50						
	S 55 ^o W	4.50						
	S 20 ^o W	4.50						
	S 5 ^o W	5.00						
	S 20 ^o E	7.50						
	S 32 ^o E	2.50						
	S 54 ^o E	3.00						
	S 25 ^o E	11.00						
	S 44 ^o E	10.00						
	S 65 ^o E	6.50						
	N 54 ^o E	5.37						
	N 32 ^o E	16.00						
	N 24 ^o W	2.00						
	N 54 ^o W	17.50						
	N 29 ^o W	2.50						
	N 67 ^o W	4.50						
1	S 85 ^o W	7.00						
Total	2	46	57					

Total number of Acres. 32,856.73

Surveys Designated	By Whom Surveyed	Date of Contract	Amount of Surveys	When Surveyed	When p ^d for and ch ^d in the Sur ^g Gen ^l acc ^t
Township lines	James M. Marsh	May 23 1847	M. Ch ^s Lks. 23. 77. 30	Sept. & October 1847	
Subdivisions	James M. Marsh	Sept. 3 1847	62. 20. 69	November 1847	

The above Map of Township N^o 28 north of Range N^o 21 West of the 4th Principal Meridian Wisconsin Territory is strictly conformable to the field notes of the survey thereof on file in this Office, which have been examined and approved.

Surveyor General's Office,
 Dubuque, March 15th 1848

Geo. W. Jones
 Sur^g Gen^l