17

# Township N.o 29 N., Range N.o 21 West 4th Mer.

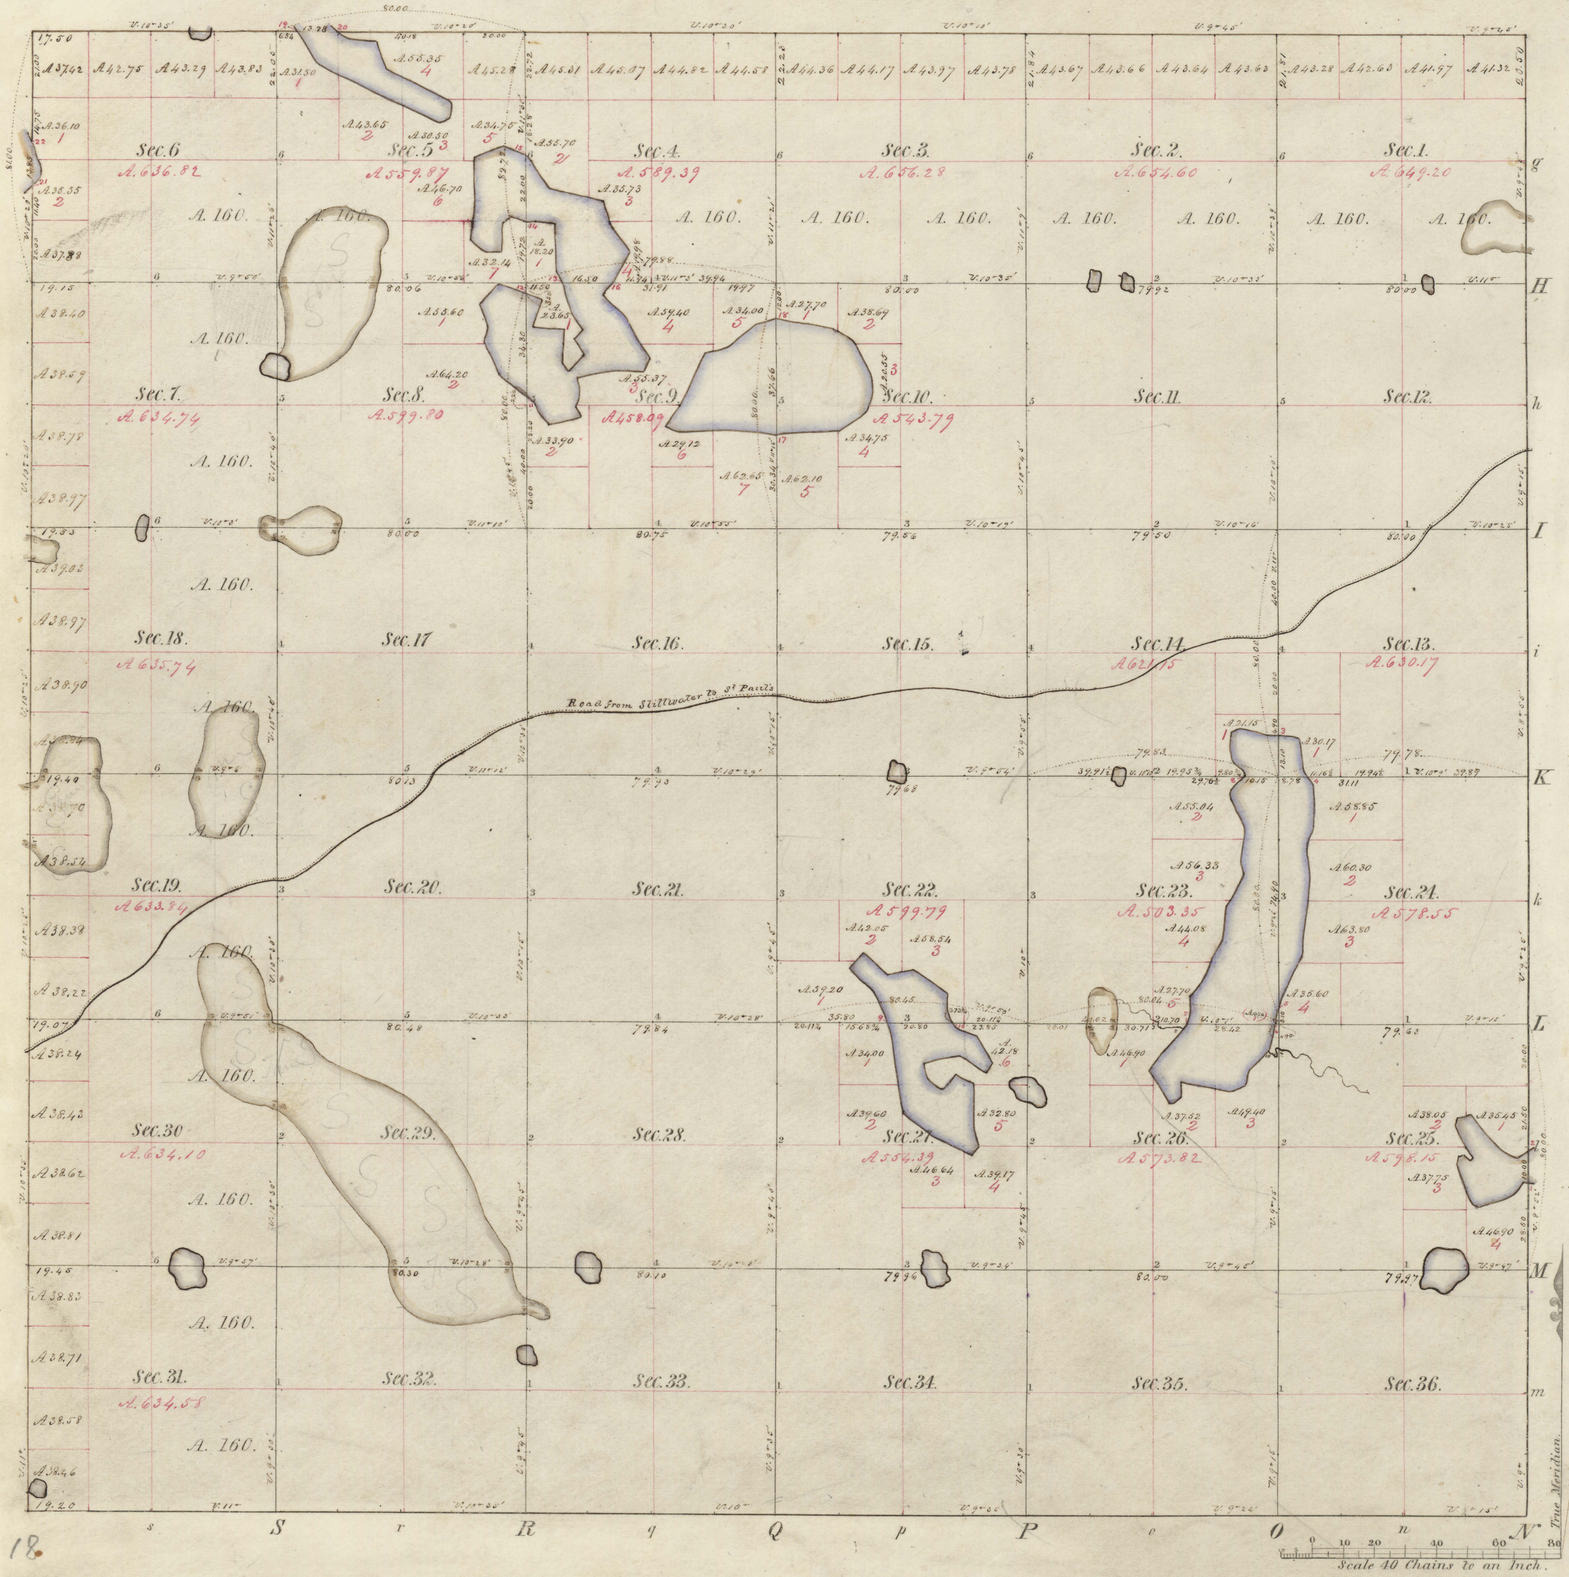


14

## Meanders of Lake's

| Posts | Courses | Ch. Lks. |
|---|---|---|
| Lake in Sec 25 | | |
| 1 | N. 64¼° W. | 1.00 |
| | S. 33° W. | 4.00 |
| | S. 64° W. | 6.00 |
| | S. 74° W. | 8.00 |
| | N. 63° W. | 2.00 |
| | N. 24½° W. | 13.00 |
| | N. 14½° E. | 3.00 |
| | N. 74° E. | 2.00 |
| | S. 50° E. | 2.50 |
| | N. 35° E. | 0.50 |
| | N. 24° W. | 11.00 |
| | N. 14½° E. | 3.00 |
| | N. 70° E. | 4.00 |
| | S. 29° E. | 15.00 |
| | S. 64½° E. | 5.00 |
| 2 | N. 61½° E. | 4.06 |
| Lake in Sec's 13, 14, 23, 24 & 26 | | |
| 3 | S. 80½° E. | 6.50 |
| | S. 21° E. | 3.00 |
| | S. 2½° E. | 7.00 |
| | S. 11° E. | 1.50 |
| 4 | S. 35° E. | 1.00 |
| | S. 31½° E. | 3.50 |
| | South | 14.00 |
| | S. 24° W. | 4.50 |
| | S. 54° E. | 11.00 |
| | S. 6° W. | 11.00 |
| | S. 8° W. | 16.00 |
| | S. 26½° W. | 15.00 |
| 5 | S. 11° W. | 3.27 |
| 6 | S. 10° W. | 5.20 |
| | S. 17½° W. | 9.00 |
| | S. 4° W. | 7.50 |
| | S. 18° W. | 6.50 |
| | S. 7½° W. | 5.00 |
| | N. 79½° W. | 15.50 |
| | South | 5.00 |
| | S. 45° W. | 2.50 |
| | N. 76½° W. | 2.00 |
| | N. 34½° W. | 12.00 |
| | N. 28½° E. | 4.00 |
| 7 | N. 40° E. | 15.40 |
| | N. 20½° E. | 3.50 |
| | North | 5.50 |
| | N. 38° E. | 7.00 |
| | N. 23½° E. | 14.00 |
| | N. 12½° E. | 11.50 |
| | N. 32° E. | 11.50 |
| | N. 13½° W. | 4.00 |
| | N. 7½° E. | 11.00 |
| | N. 27½° W. | 11.00 |
| | N. 11° E. | 2.00 |
| | N. 25° E. | 1.50 |
| 8 | N. 50° E. | 5.14 |
| 3 | North | 1.00 |
| | N. 49° W. | 5.00 |
| | N. 9½° W. | 6.50 |
| | S. 70° W. | 4.00 |
| | N. 88° E. | 4.82 |
| | S. 70° E. | 6.50 |
| | N. 70° E. | 4.00 |
| | S. 26° E. | 2.00 |
| | S. 8° E. | 2.00 |
| | S. 50° E. | 12.00 |
| | S. 66½° E. | 14.00 |
| | N. 42½° E. | 3.50 |
| | N. 1° W. | 4.50 |
| | N. ¼° W. | 16.00 |
| | N. 66° W. | 6.50 |
| | S. 40° W. | 6.00 |
| | N. 75° W. | 2.00 |
| | N. 42° W. | 3.50 |
| | N. 16° W. | 6.00 |
| | N. 79½° E. | 11.50 |
| | S. 61° E. | 10.00 |
| | N. 29½° E. | 3.50 |
| | N. 30½° W. | 9.00 |
| | N. 67° W. | 8.00 |
| 10 | N. 35½° W. | 1.88 |
| 10 | N. 2½° W. | 3.00 |
| | N. 1½° W. | 6.50 |
| | N. 53½° W. | 12.00 |
| | S. 77½° W. | 9.00 |
| | N. 47° W. | 10.00 |
| | S. 45½° W. | 7.00 |
| | S. 46° E. | 10.00 |
| 9 | S. 26° E. | 11.82 |
| Lake in Sec's 4, 8 & 9 | | |
| 11 | N. 53½° W. | 4.85 |
| | N. 54½° W. | 6.91 |
| | N. 17½° W. | 12.16 |
| | N. 9½° E. | 5.00 |
| | N. 13½° E. | 8.11 |
| | N. 41½° E. | 9.32 |
| 12 | S. 68° E. | 9.42 |
| | S. 68° E. | 5.58 |
| | S. 16° W. | 9.31 |
| | S. 85½° E. | 9.56 |
| | S. 37° W. | 10.50 |
| | S. 35° E. | 3.50 |
| | N. 43½° E. | 7.25 |
| | N. 30½° W. | 6.40 |
| | N. 48½° E. | 3.75 |
| | N. 2½° W. | 6.17 |
| 13 | N. 18½° W. | 10.33 |
| | S. 6½° W. | 1.00 |
| | N. 46½° W. | 3.50 |
| | N. 1° W. | 15.00 |
| | N. 77½° W. | 6.23 |
| 14 | S. 85½° W. | 2.83 |
| | S. 72½° W. | 4.79 |
| | S. 56½° W. | 3.60 |
| | S. 4° W. | 9.50 |
| | N. 84½° W. | 5.20 |
| | N. 45½° W. | 5.30 |
| | N. 8½° E. | 7.00 |
| | N. 44½° W. | 19.00 |
| | N. 70½° E. | 11.50 |
| 15 | S. 65½° E. | 7.05 |
| | S. 39° E. | 5.00 |
| | S. 33½° E. | 8.50 |
| | S. 76½° E. | 17.50 |
| | S. 18½° E. | 8.50 |
| | S. 31½° E. | 10.00 |
| 16 | S. 25½° W. | 10.42 |
| 16 | S. 39½° W. | 5.00 |
| | S. 43½° E. | 9.00 |
| | S. 27½° E. | 8.50 |
| | S. 35½° E. | 8.30 |
| | S. 30½° W. | 4.21 |
| | N. 89½° W. | 10.00 |
| | S. 76½° W. | 12.00 |
| | S. 15½° E. | 6.73 |
| | S. 29½° W. | 3.40 |
| | S. 30° E. | 4.00 |
| | S. 81° W. | 11.13 |
| | N. 43½° W. | 4.94 |
| | N. 21½° W. | 4.00 |
| 11 | N. 64½° W. | 2.18 |
| 17 | N. 84° W. | 13.00 |
| | West | 17.50 |
| | N. 76° W. | 5.00 |
| | N. 31½° E. | 10.00 |
| | N. 25½° E. | 17.50 |
| | N. 75½° E. | 7.50 |
| | N. 51° E. | 10.50 |
| 18 | N. 73° E. | 7.00 |
| 18 | S. 79½° E. | 12.50 |
| | S. 63½° E. | 7.00 |
| | S. 30½° E. | 12.50 |
| | S. 5½° E. | 8.00 |
| | S. 2.3° W. | 6.00 |
| | S. 33½° W. | 11.00 |
| | S. 81½° W. | 15.00 |
| 17 | S. 81½° W. | 4.50 |
| 19 | S. 31½° E. | 13.50 |
| | S. 62° E. | 42.00 |
| | N. 62° E. | 4.00 |
| | N. 7° E. | 5.50 |
| | N. 63½° W. | 23.00 |
| | N. 16° W. | 9.50 |
| | N. 83° W. | 9.00 |
| 20 | N. 48° W. | 4.57 |
| 21 | N. 32½° E. | 4.50 |
| | North | 2.50 |
| | N. 25° W. | 2.50 |
| 22 | N. 14½° W. | 4.55 |

| | Ms | Chs | Lks |
|---|---|---|---|
| Total | 16 | 06 | 73 |

Total number of Acres. 22,140.21

| Surveys Designated | By Whom Surveyed | Date of Contract | Amount of Surveys | When Surveyed | When p.d for and ch.d in the Sur.r Gen.ls ace.t |
|---|---|---|---|---|---|
| Township lines | Jame M. Marsh | May 22d 1847 | M. 23 Chs. 73 Lks. 20 | Oct.r 1847 | |
| Subdivisions | Isaac N. Taylor | September 8.th 1847 | 76 · 14 · 07 | November 1847 | |

The above Map of Township No 29 North of Range No 21 West of the 4th Principal Meridian Wisconsin Territory is strictly conformable to the field notes of the survey thereof on file in this Office, which have been examined and approved.

Surveyor General's Office.
Dubuque, March 15th 1848.

Geo. W. Jones
Surv.r Gen.l

18