

MONUMENT 126

CERTIFICATE OF LOCATION OF GOVERNMENT CORNER


West Quarter Corner Section 18, Township 30 North, Range 23 West,
County of Ramsey, State of Minnesota.

At the corner location shown on the sketch

On March 1, 2005 found a cast iron monument.

left monument as found, lowered monument, removed monument (explain)

On _____ placed a _____

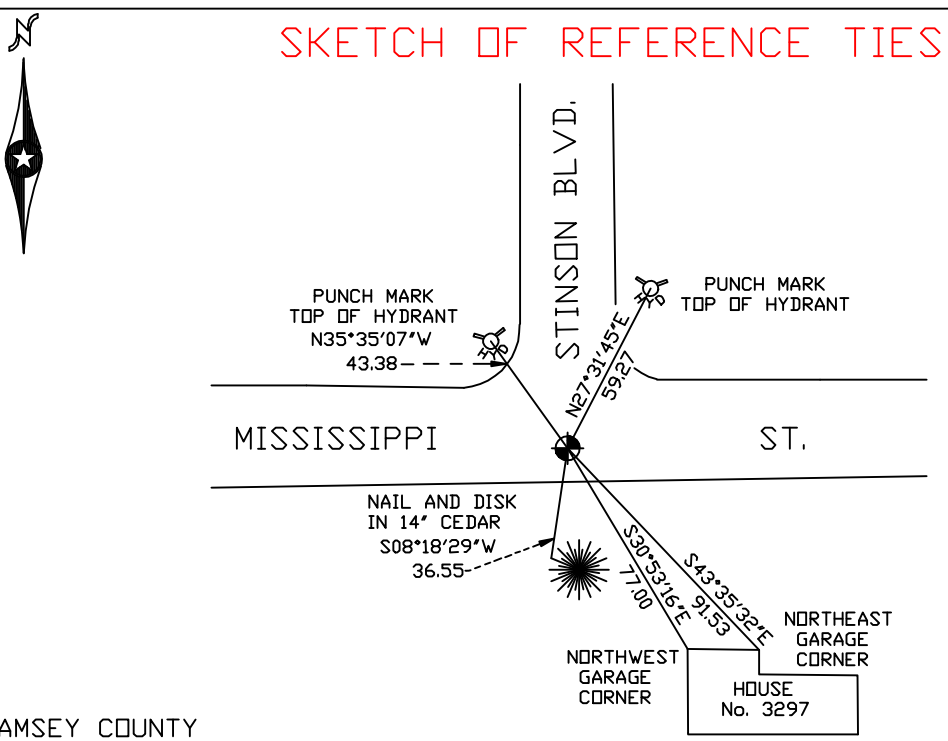

RAMSEY COUNTY
NAD83 (1986) DATUM

MONUMENT 126

X=540213.503 (Easting)
Y=207531.746 (Northing)

ALL DISTANCES ARE SHOWN IN U.S. SURVEY FEET.
BEARINGS ARE FOR TIE REFERENCE PURPOSES ONLY.

Statements of evidence relative to this corner are on the following page(s).

I hereby certify that this document and the data contained herein was prepared by me or under my direct supervision this _____ day of _____, 20____.

SIGNATURE

Minnesota License No. _____

- Land Surveyor Professional Engineer
- County Surveyor County Engineer

OFFICE OF COUNTY SURVEYOR

County of Ramsey

I hereby certify that this document was filed in the County Surveyor's office on the ____ day of _____, 20____.

David D. Claypool, P.L.S., County Surveyor

By _____, Deputy

MONUMENT 126

Found cast iron monument flush and retied, August 21, 1974.

Retied monument, January 14, 1992.

Retied monument, September 8, 1999.

Retied monument, March 1, 2005.