

MONUMENT 191

CERTIFICATE OF LOCATION OF GOVERNMENT CORNER

Center of Section 20, Township 30 North, Range 22 West, County of Ramsey,
State of Minnesota.


At the corner location shown on the sketch

On March 28, 2005 found a granite monument.

left monument as found lowered monument removed monument (explain)

On _____ placed a _____

SKETCH OF REFERENCE TIES

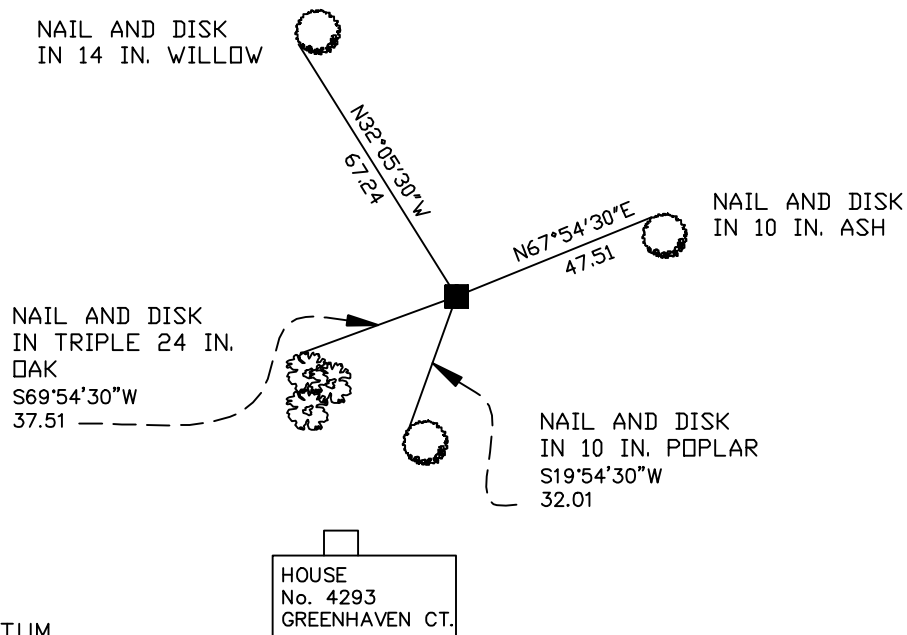

RAMSEY COUNTY
NAD83 (1986) DATUM

MONUMENT 191

X= 579256.817 (Easting)
Y= 202575.098 (Northing)

ALL DISTANCES ARE SHOWN IN U.S. SURVEY FEET.
BEARINGS ARE FOR TIE REFERENCE PURPOSES ONLY.

Statements of evidence relative to this corner are on the following page(s).

I hereby certify that this document and the data contained herein was prepared by me or under my direct supervision this _____ day of _____, 20____.

SIGNATURE

Minnesota License No. _____

County Surveyor Land Surveyor

OFFICE OF COUNTY SURVEYOR

County of Ramsey

I hereby certify that this document was filed in the County Surveyor's office on the ____ day of _____, 20____.

David D. Claypool, P.L.S., County Surveyor

By _____, Deputy

MONUMENT 191

Found granite monument up 0.1 ft. and retied, September 17, 1974.

Placed sign and post; retied monument, October 2, 1991.

Retied monument, December 8, 1999.

Retied monument, March 28, 2005.