

# MONUMENT 232

## CERTIFICATE OF LOCATION OF GOVERNMENT CORNER

West Quarter Corner of Section 27, Township 30 North, Range 23 West,  
County of Ramsey, State of Minnesota.


At the corner location shown on the sketch

On October 25, 2005 found a granite monument up 0.4 ft.

left monument as found     lowered monument     removed monument (explain)

On \_\_\_\_\_ placed a \_\_\_\_\_

### SKETCH OF REFERENCE TIES

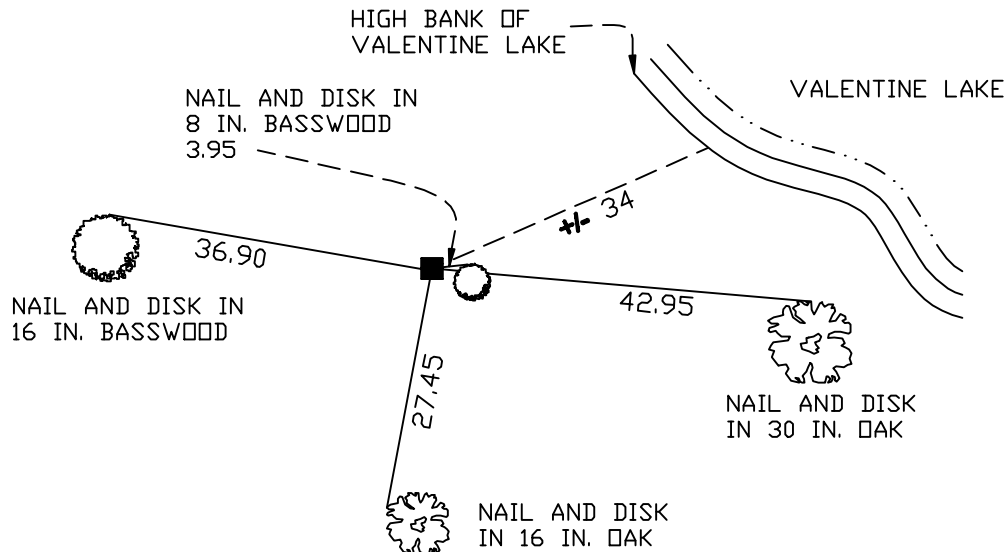

RAMSEY COUNTY

NAD83 (1986)

MONUMENT 232

X= 555769.754 (Easting)  
Y= 197173.320 (Northing)

ALL DISTANCES ARE SHOWN IN U.S. SURVEY FEET.

Statements of evidence relative to this corner are on the following page(s).

I hereby certify that this document and the data contained herein was prepared by me or under my direct supervision this \_\_\_\_\_ day of \_\_\_\_\_, 20\_\_\_\_.

SIGNATURE

Minnesota License No. \_\_\_\_\_

County Surveyor     Land Surveyor

OFFICE OF COUNTY SURVEYOR

County of Ramsey

I hereby certify that this document was filed in the County Surveyor's office on the \_\_\_\_ day of \_\_\_\_\_, 20\_\_\_\_.

David D. Claypool, P.L.S., County Surveyor

By \_\_\_\_\_, Deputy

## MONUMENT 232

**Found granite monument up 3 in. and retied, November 27, 1974.**

**Found granite monument; retied and set sign and post, August 14, 1996.**

**Retied monument, October 25, 2005.**