

MONUMENT 297

CERTIFICATE OF LOCATION OF GOVERNMENT CORNER

Center of Section 35, Township 30 North, Range 22 West, County of Ramsey,
State of Minnesota.


At the corner location shown on the sketch

On October 28, 2005 found a cast iron monument.

left monument as found lowered monument removed monument (explain)

On _____ placed a _____

SKETCH OF REFERENCE TIES

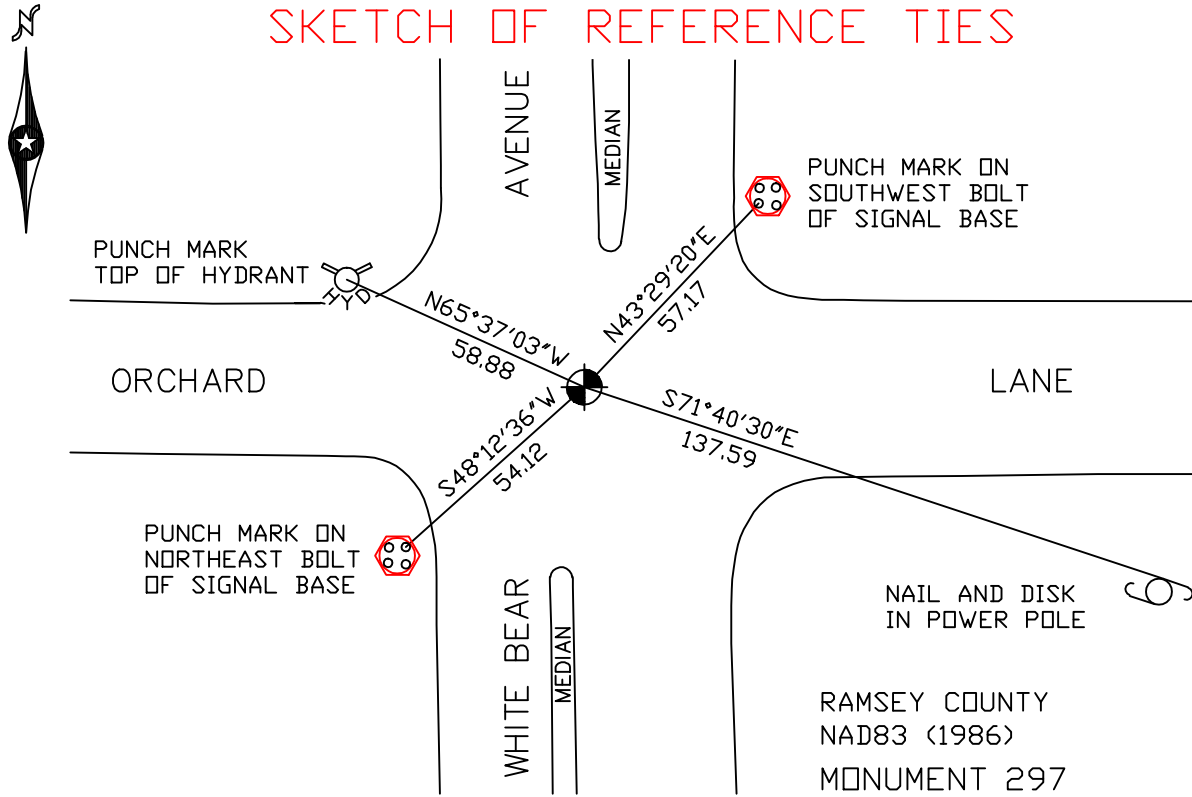

ALL DISTANCES ARE SHOWN IN U.S. SURVEY FEET.
BEARINGS ARE FOR TIE REFERENCE PURPOSES ONLY.

RAMSEY COUNTY
NAD83 (1986)
MONUMENT 297

X = 595121.964 (Easting)
Y = 192062.183 (Northing)

Statements of evidence relative to this corner are on the following page(s).

I hereby certify that this document and the data contained herein was prepared by me or under my direct supervision this _____ day of _____, 20____.

SIGNATURE

Minnesota License No. _____

County Surveyor Land Surveyor

OFFICE OF COUNTY SURVEYOR

County of Ramsey

I hereby certify that this document was filed in the County Surveyor's office on the ____ day of _____, 20____.

David D. Claypool, P.L.S., County Surveyor

By _____, Deputy

MONUMENT 297

Found cast iron monument, 1974.

Tied out cast iron monument, June 25, 1991.

Retied monument, November 13, 1998.

Retied monument, October 28, 2005.